


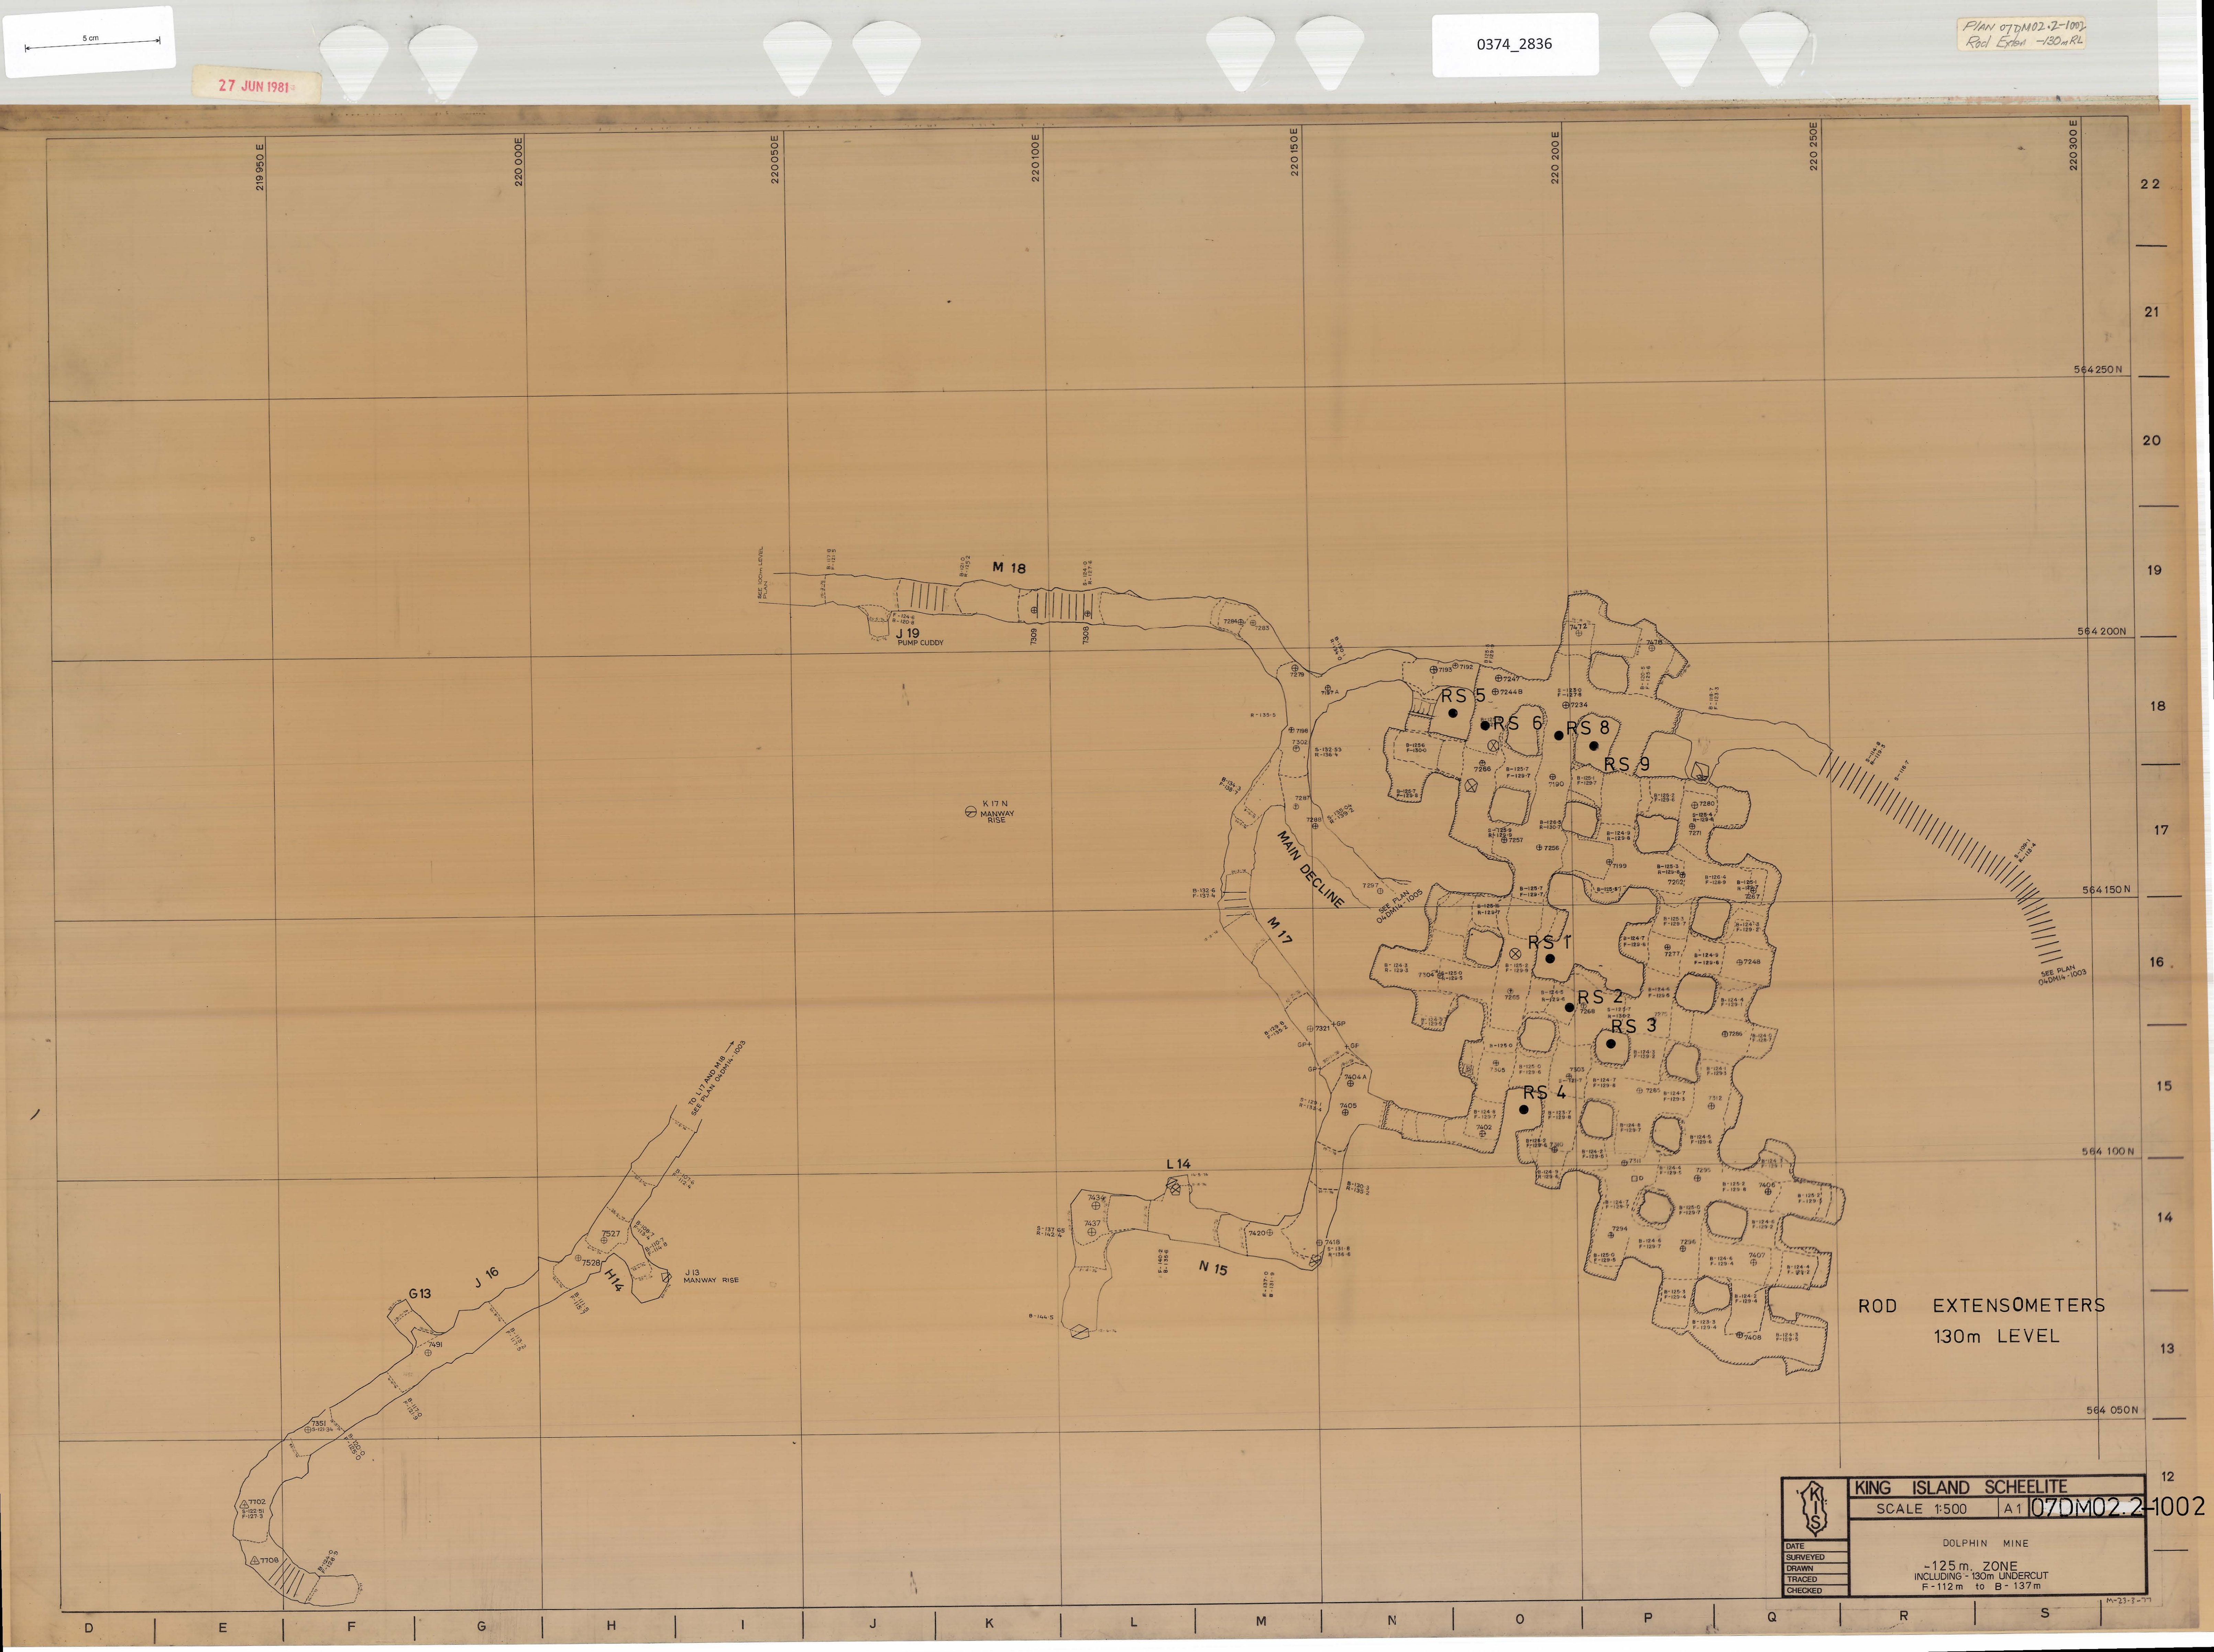

0374\_2836

PLAN 07DM02.2-1002  
Rod Exten -130m RL

27 JUN 1981

ROD EXTENSOMETERS  
130m LEVEL

|                                                                                       |                                              |                  |
|---------------------------------------------------------------------------------------|----------------------------------------------|------------------|
|  | KING ISLAND SCHEELITE                        |                  |
|                                                                                       | SCALE 1:500                                  | A1 07DM02.2-1002 |
|                                                                                       | DOLPHIN MINE                                 |                  |
|                                                                                       | -125 m. ZONE                                 |                  |
|                                                                                       | INCLUDING -130m UNDERCUT<br>F-112m to B-137m |                  |
| DATE                                                                                  |                                              |                  |
| SURVEYED                                                                              |                                              |                  |
| DRAWN                                                                                 |                                              |                  |
| TRACED                                                                                |                                              |                  |
| CHECKED                                                                               |                                              |                  |