


0374\_2841

RS-15 +16

07DM02.2-1007

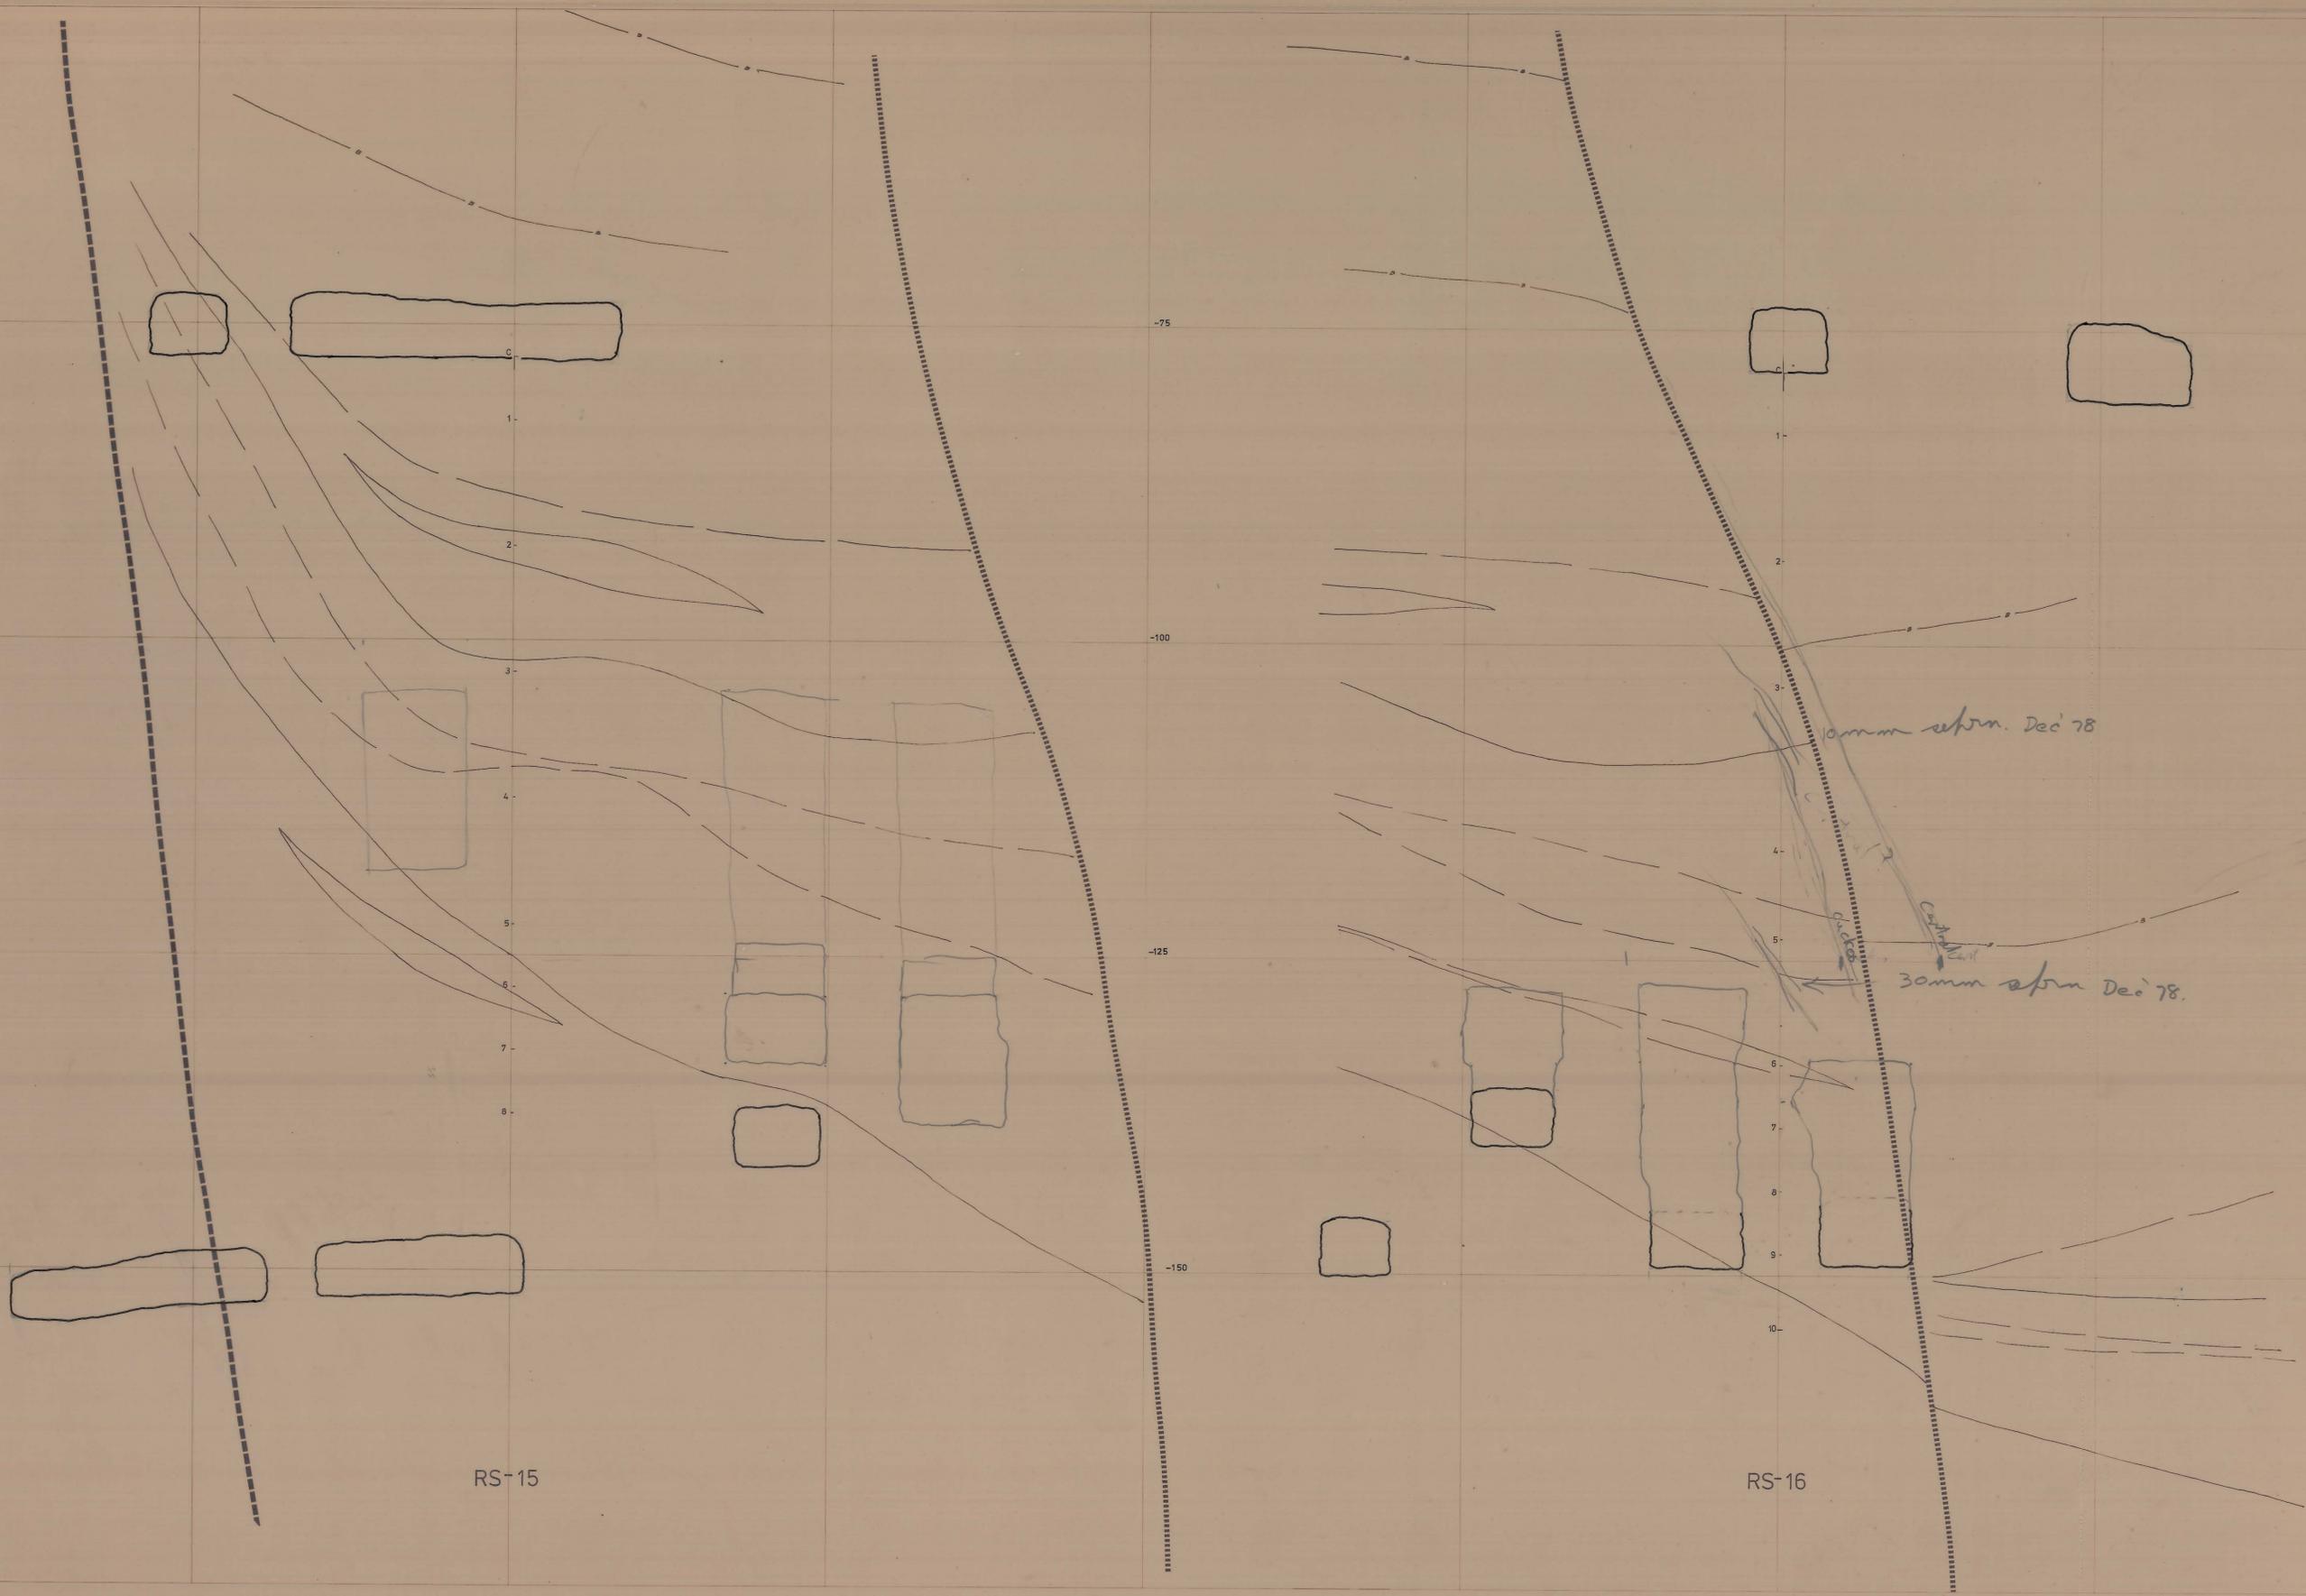

RS-15

RS-16

SCALE 1:250

LOCATION DOLPHIN MINE



north

PLAN NUMBER 07 DM 02.2 - 1007

© CENTRAL No 3