


07DM02.2-1014

E.W. SECTION
WEDLE ORE.
83

0374_2854

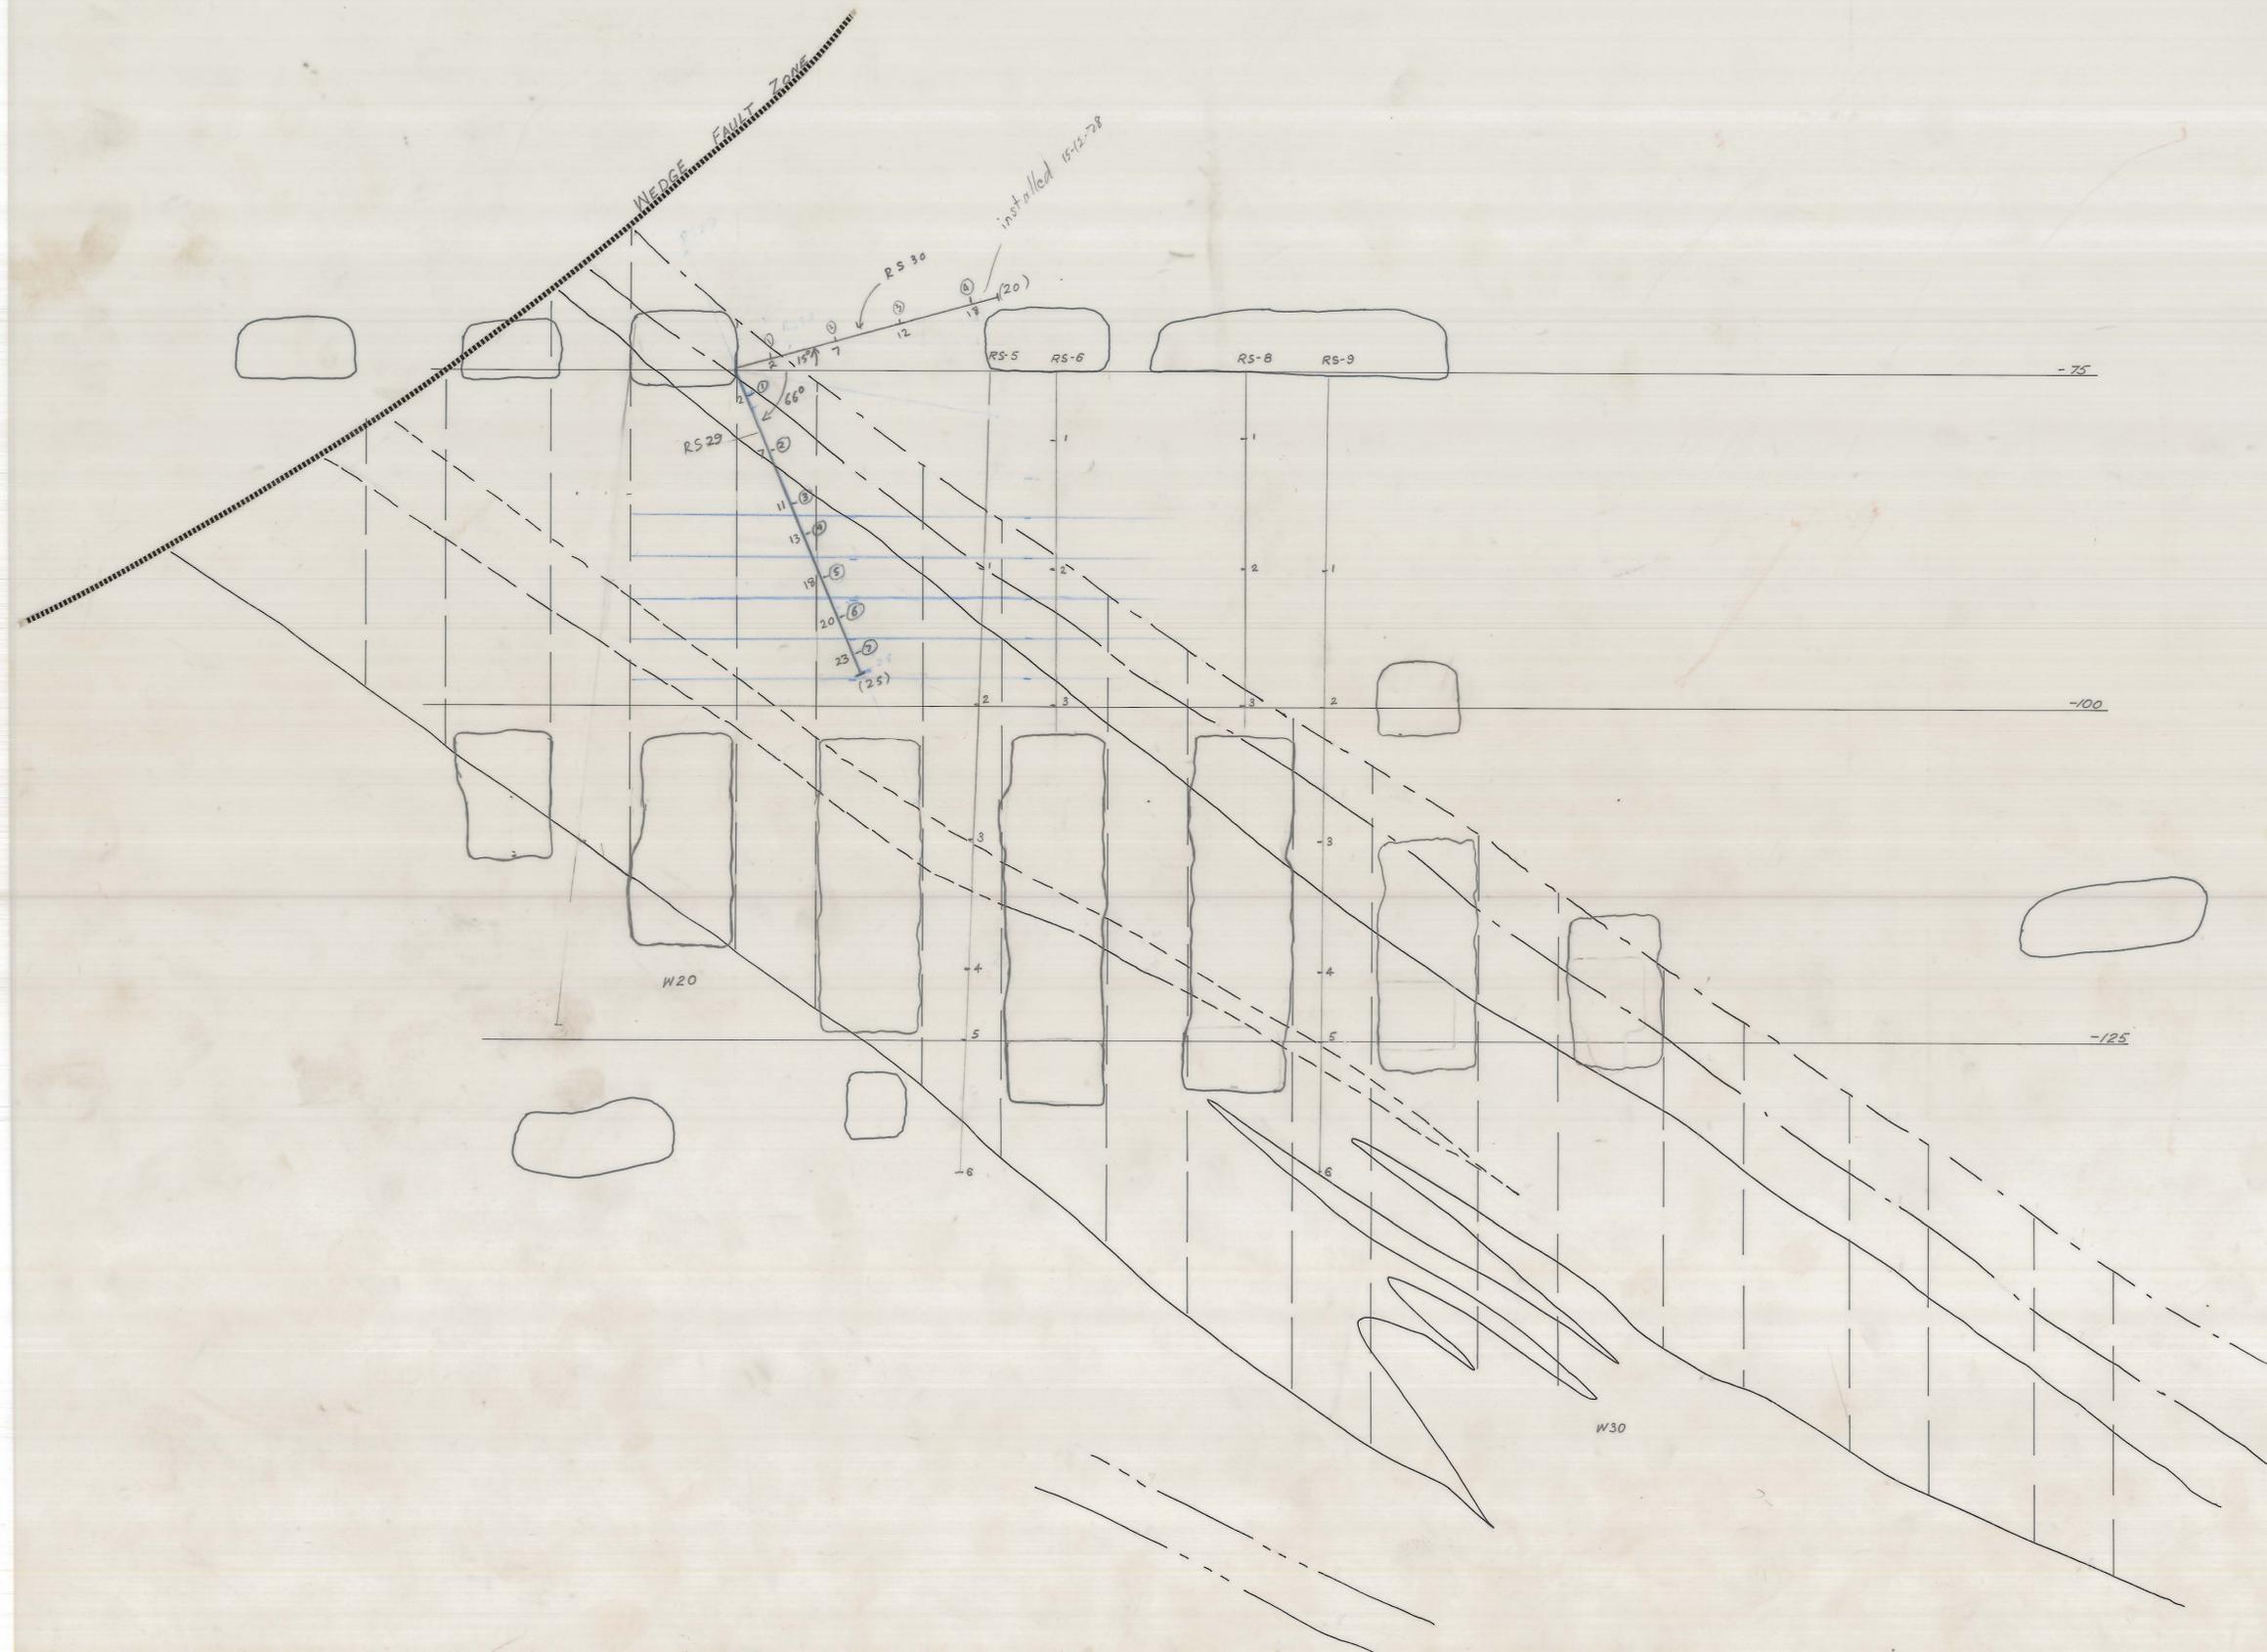

DOLPHIN MINE

07DM02.2-1014

11/83