


0374_2857

5 cm

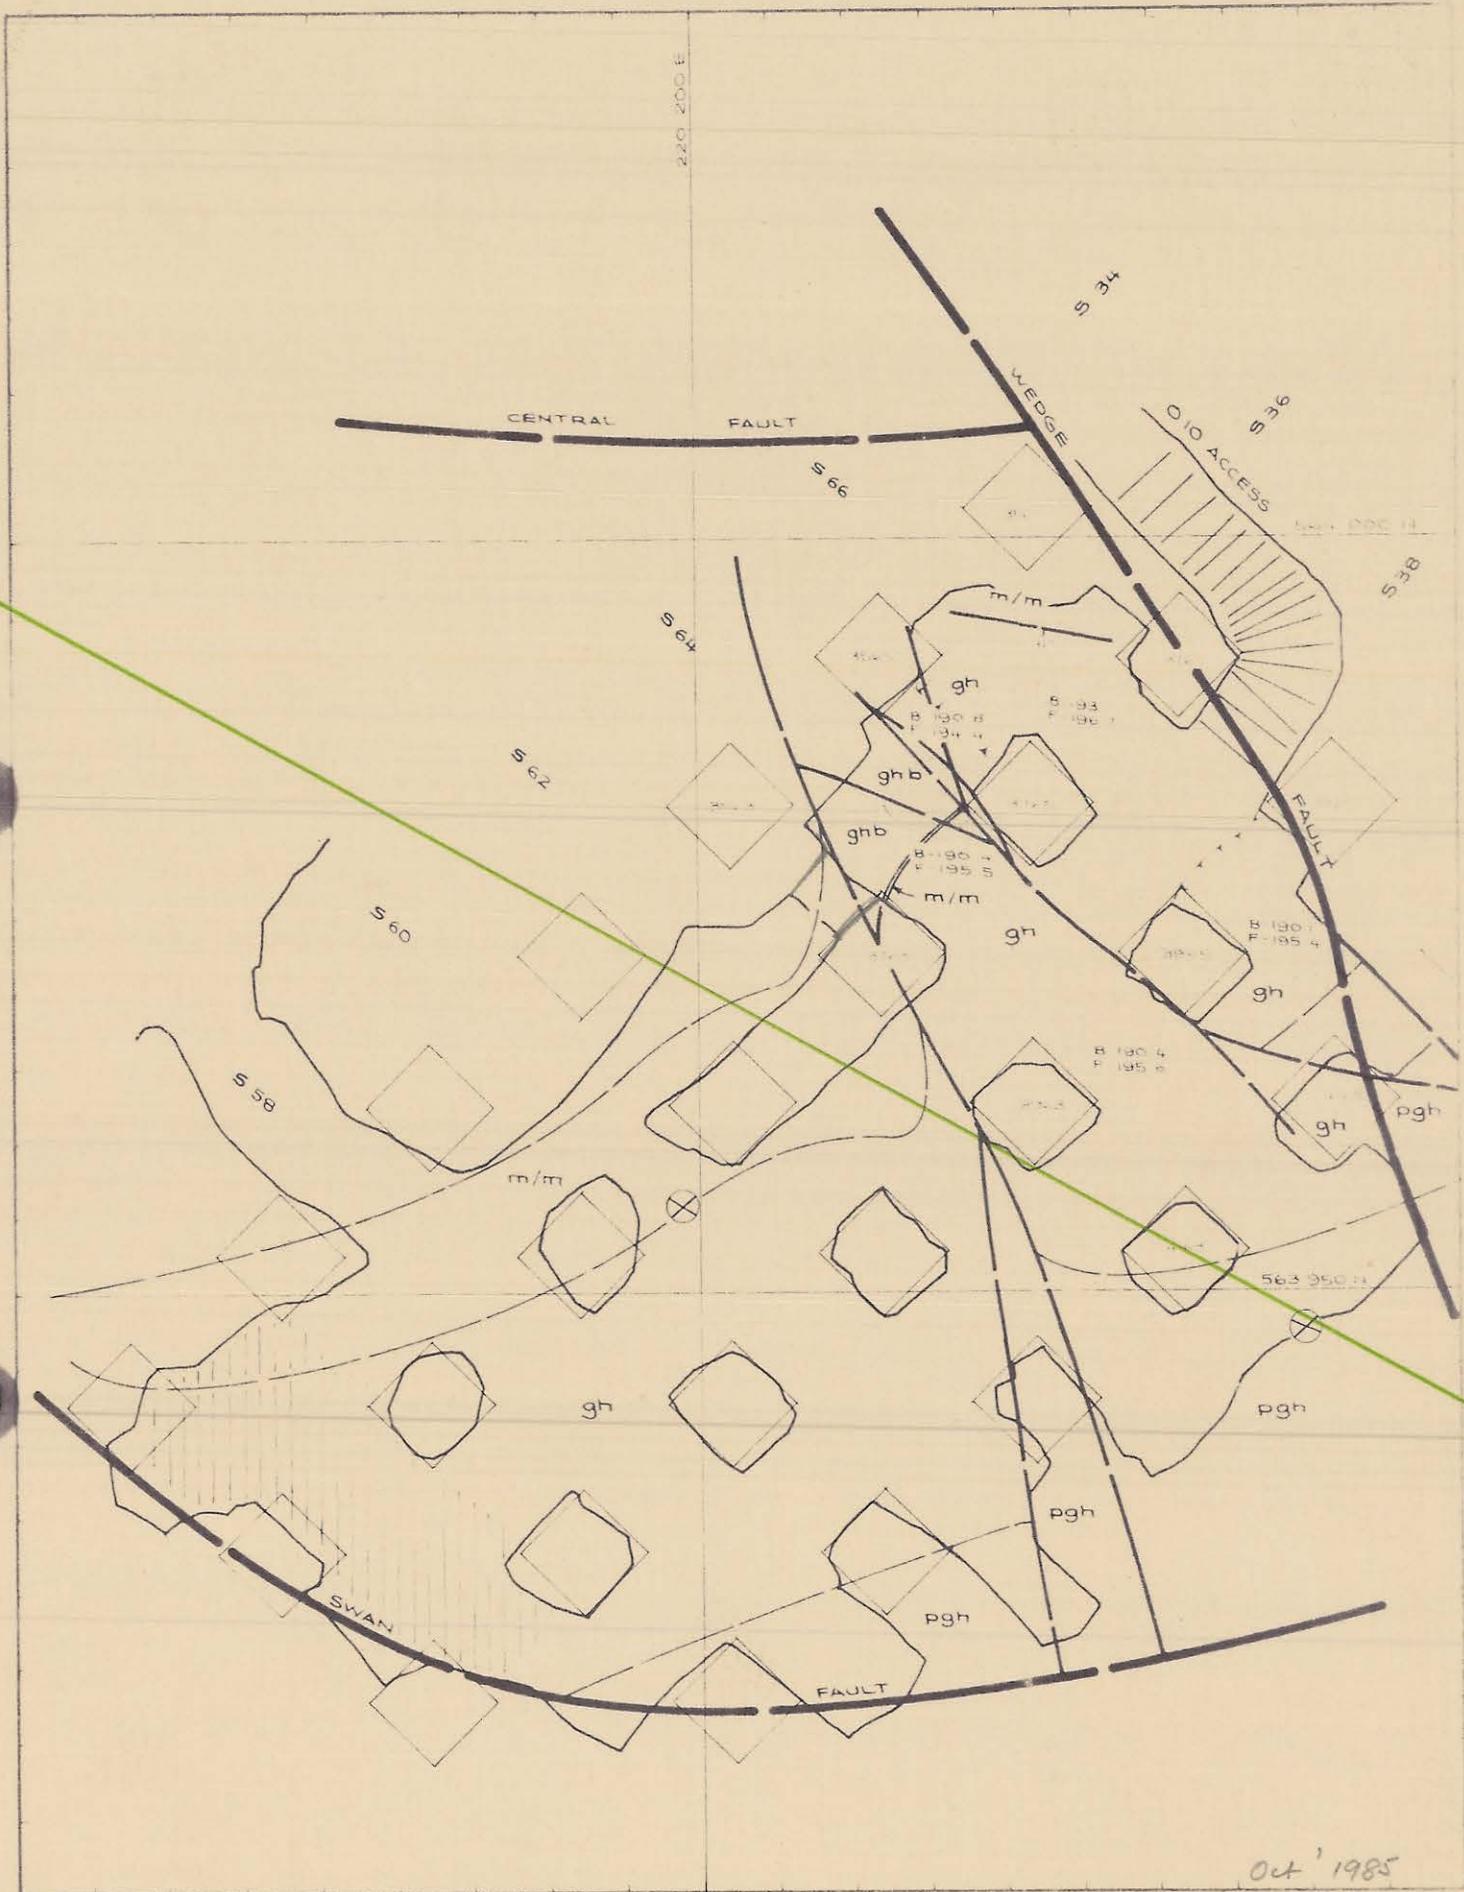

04 '1985

REF PLAN	GEOLOGY	5/8/85	A. J. W.	1:500 SCALE	
	SURVEY	5/8/85			
	PLANNING			DOLPHIN MINE LOWER PIT STOPE - LIFT 9 (010 UNDERCUT)	
	FIELD MEASUREMENT				
	WASTE CONTROL				
	DRAFTING	5/8/85	A. J. W.		
	1:500			DRAWING NUMBER	