


5 cm

0374_2861

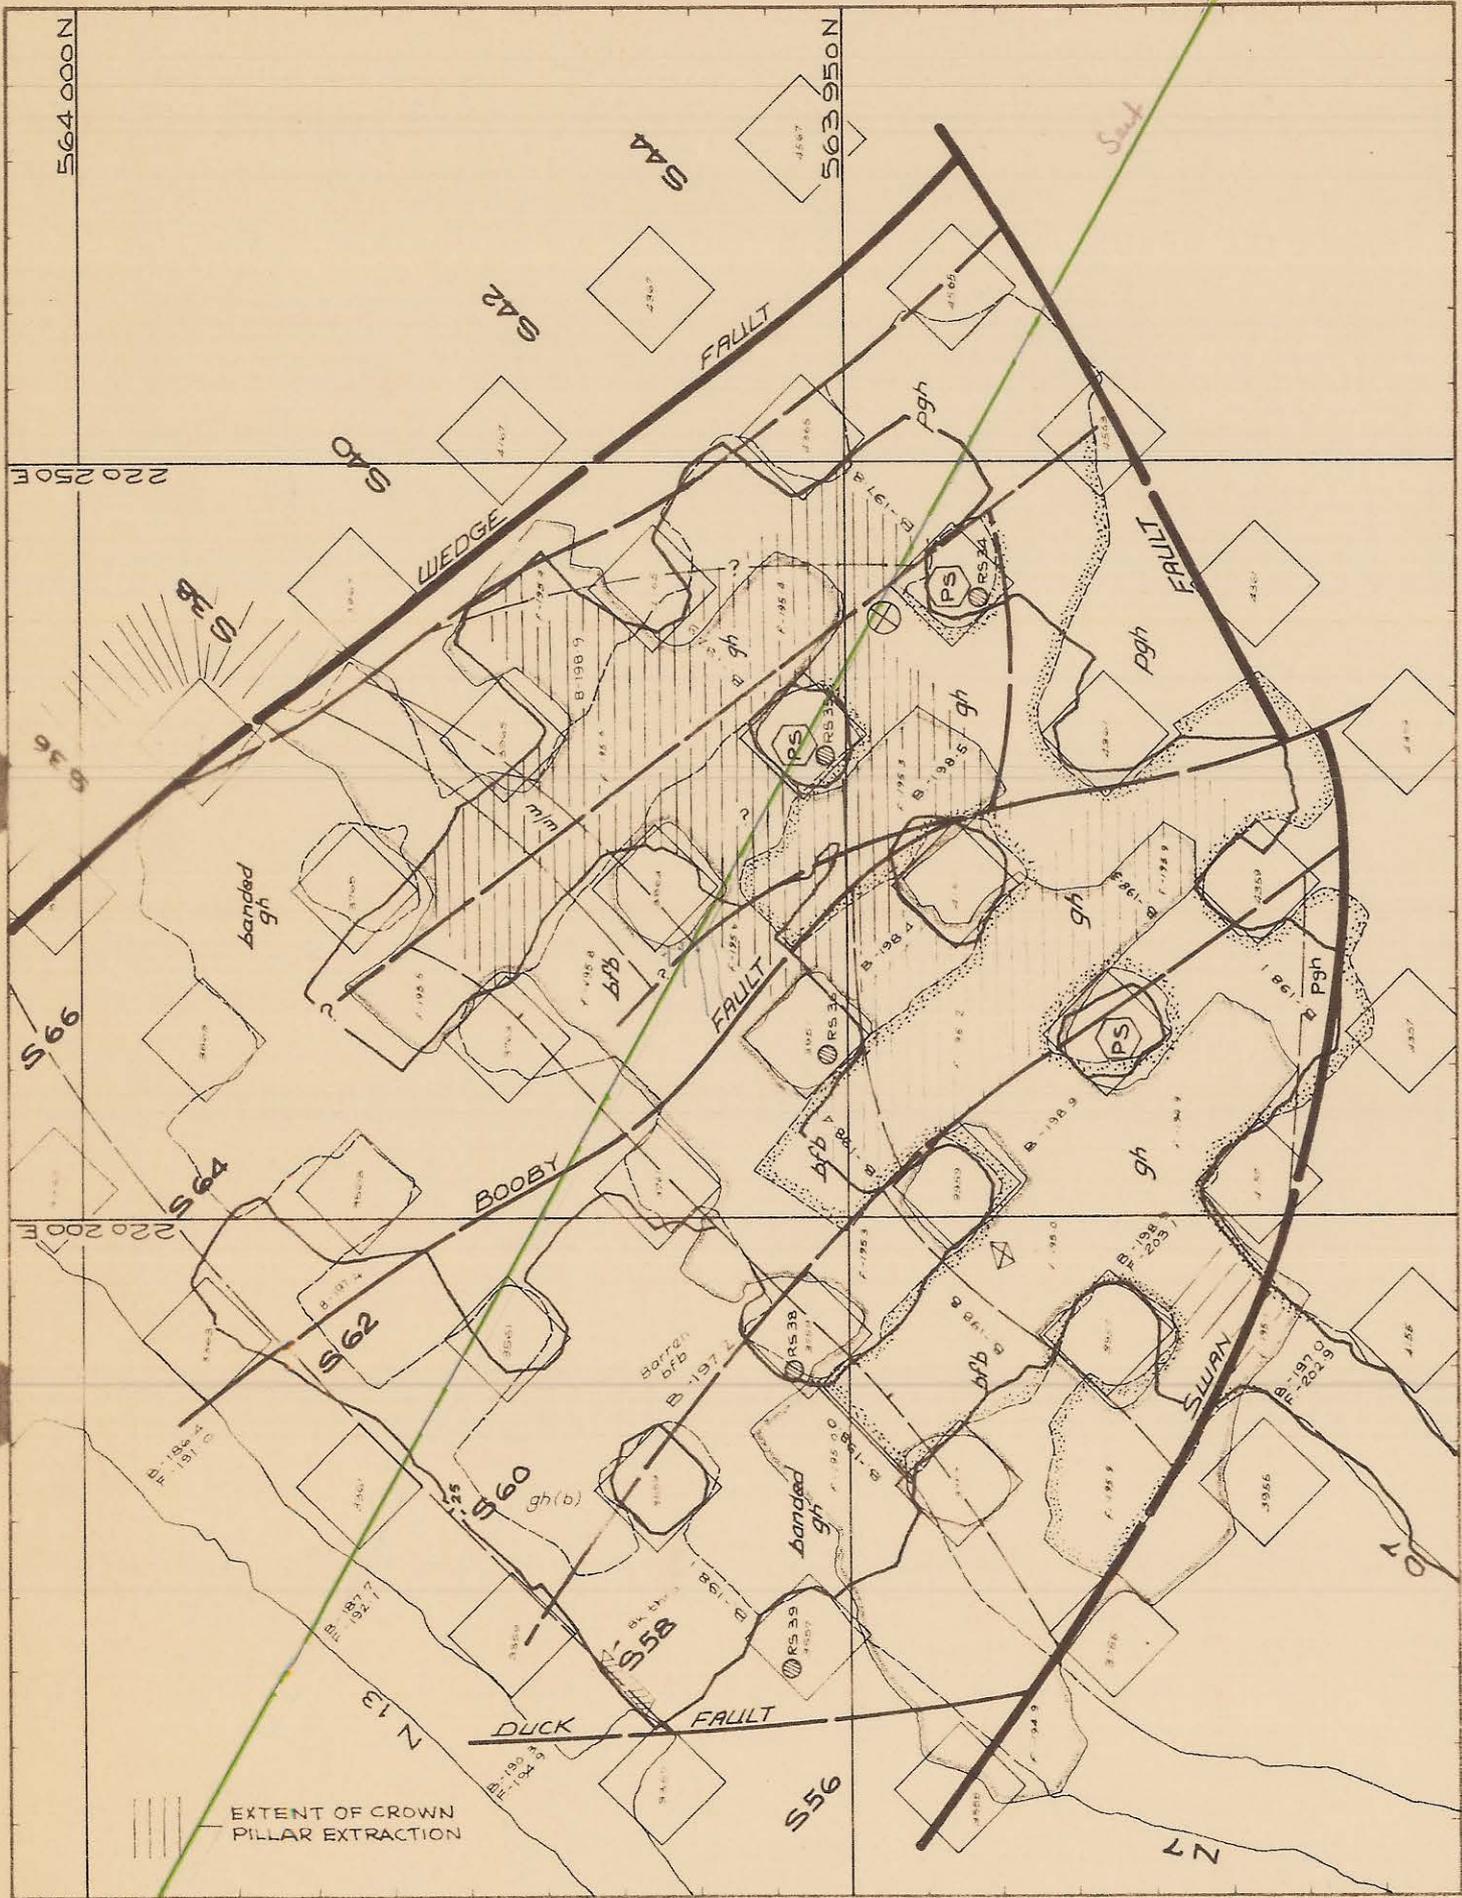

EXTENT OF CROWN PILLAR EXTRACTION

REF PLAN	GEOLOGY	C.J.K.	1 500	KING ISLAND SCHEELITE GRASSY KING ISLAND
--- 6 th LIFT ○ 10 UNDERCUT PILLAR REQUIRES STITCHING IMMEDIATELY EXPOSED. WEAK ROCK IN BACK	SURVEY PLANNING ROCK MEAS. GRADE CON. DRAFTING T.S.S.		SCALE DOLPHIN MINE 7 th LIFT - LOWER PIT STOPE -202.0m to -198.5mRL. GEOLOGY at -202.0mRL.	
			DRAWING NUMBER	