


5 cm

07 DM 02.2-4003

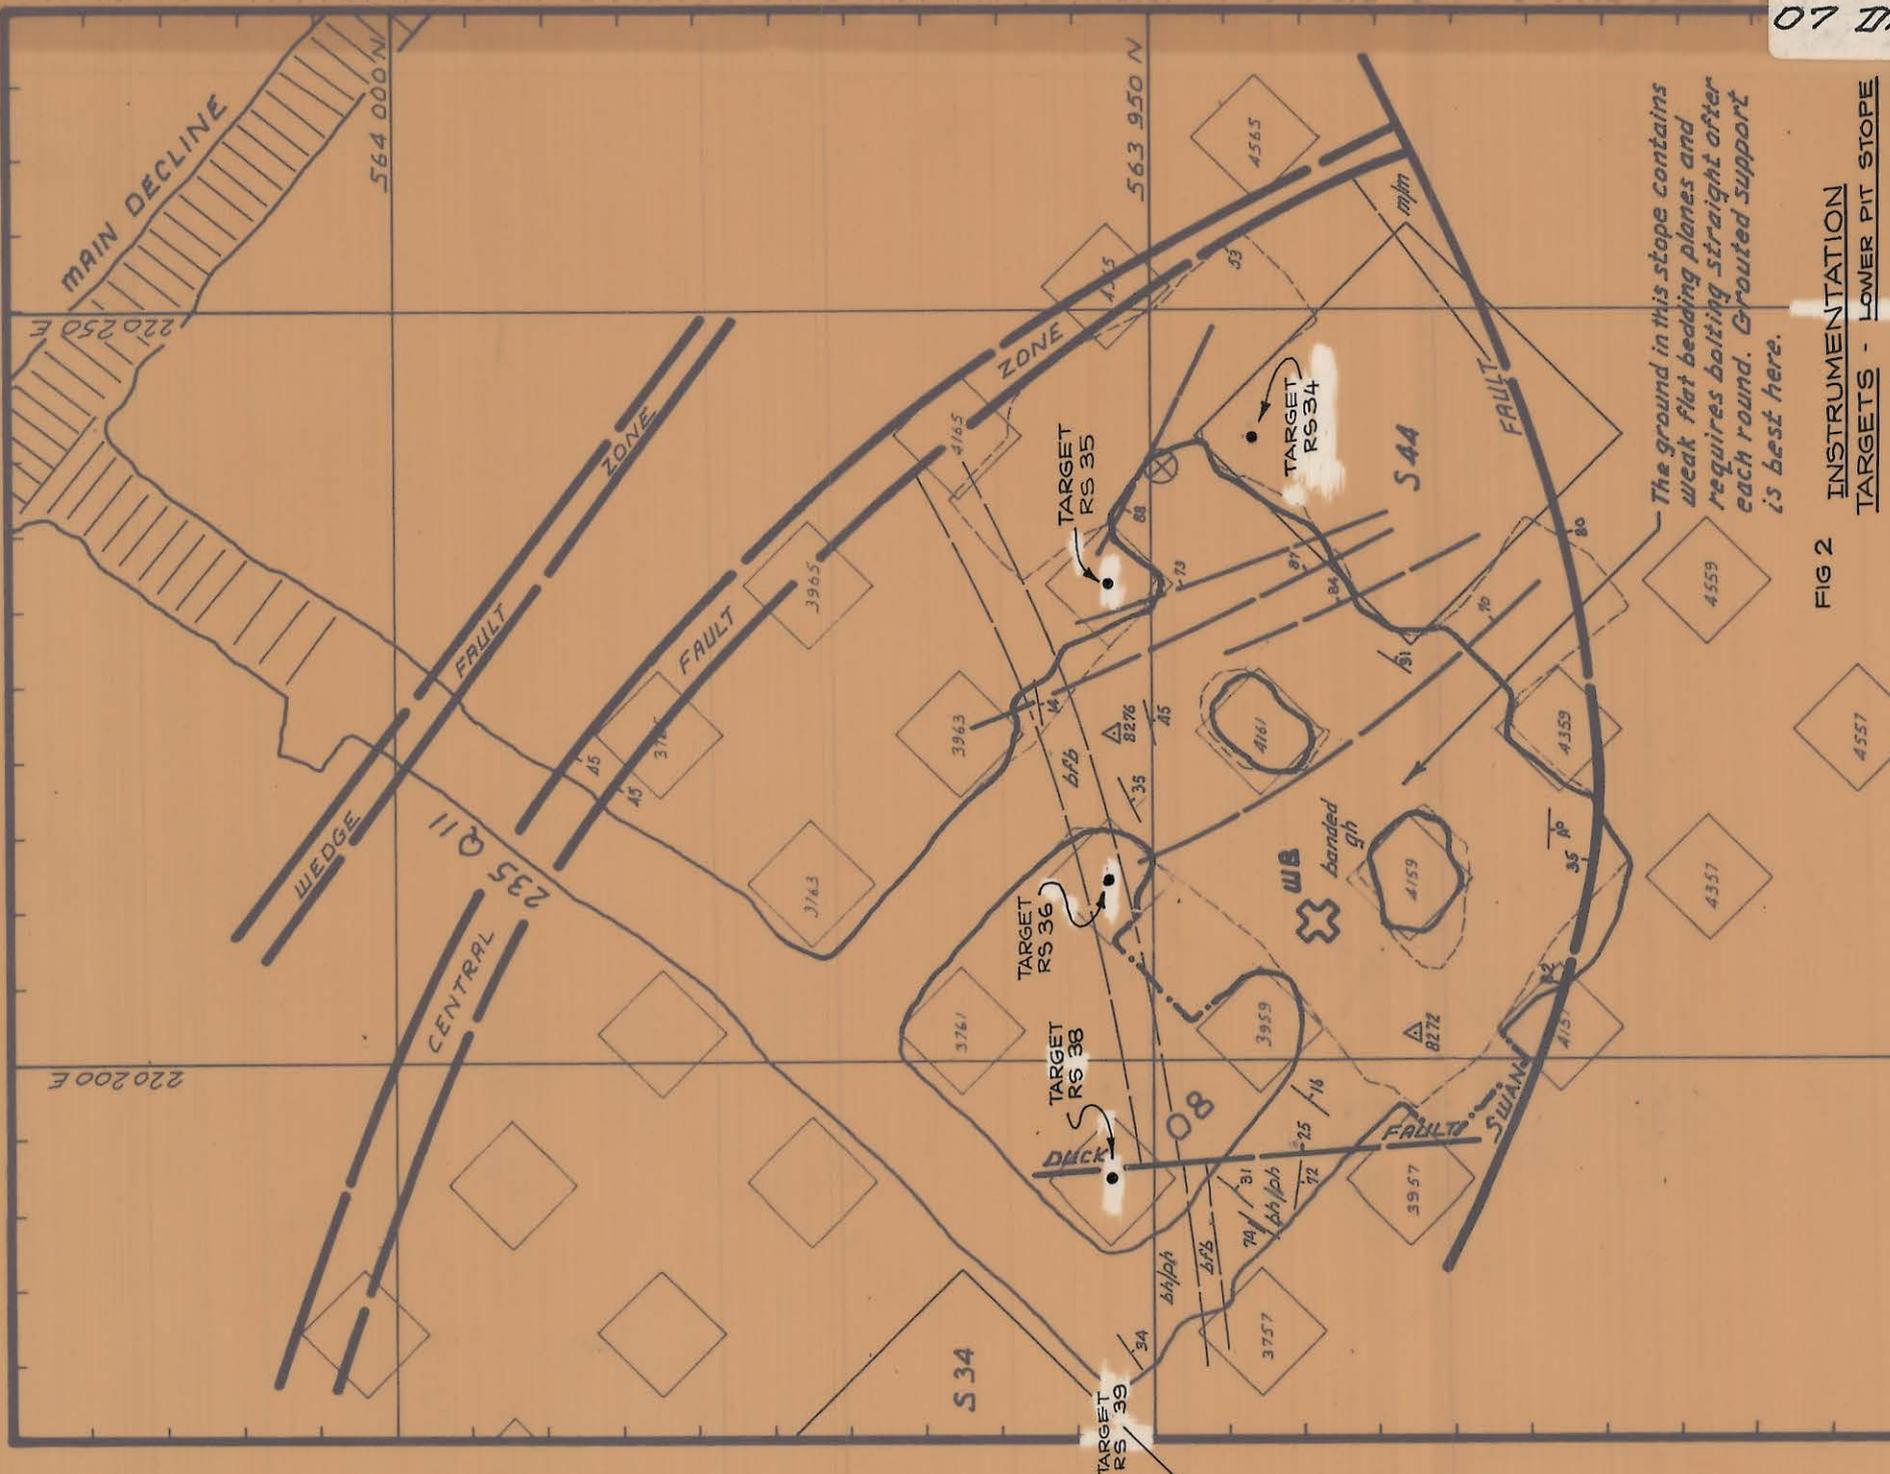

The ground in this slope contains weak flat bedding planes and requires bolting straight after each round. Grouted support is best here.

FIG 2 INSTRUMENTATION TARGETS - LOWER PIT STOPE

LEGEND:

- undercut
- WB Weak rock in back

Scale: 1:500

DATE: _____

GEOLOGICAL: SOB. _____

DRAWN: R.F. _____

CHECKED: _____

NO. K

GEOPEKO LIMITED
KING ISLAND

DOLPHIN MINE
LOWER PIT STOPE
1st LIFT - 225 to -222m.R.L.
Geology at -225m.R.L.

07 DM 02.2 - 4003