


5 cm

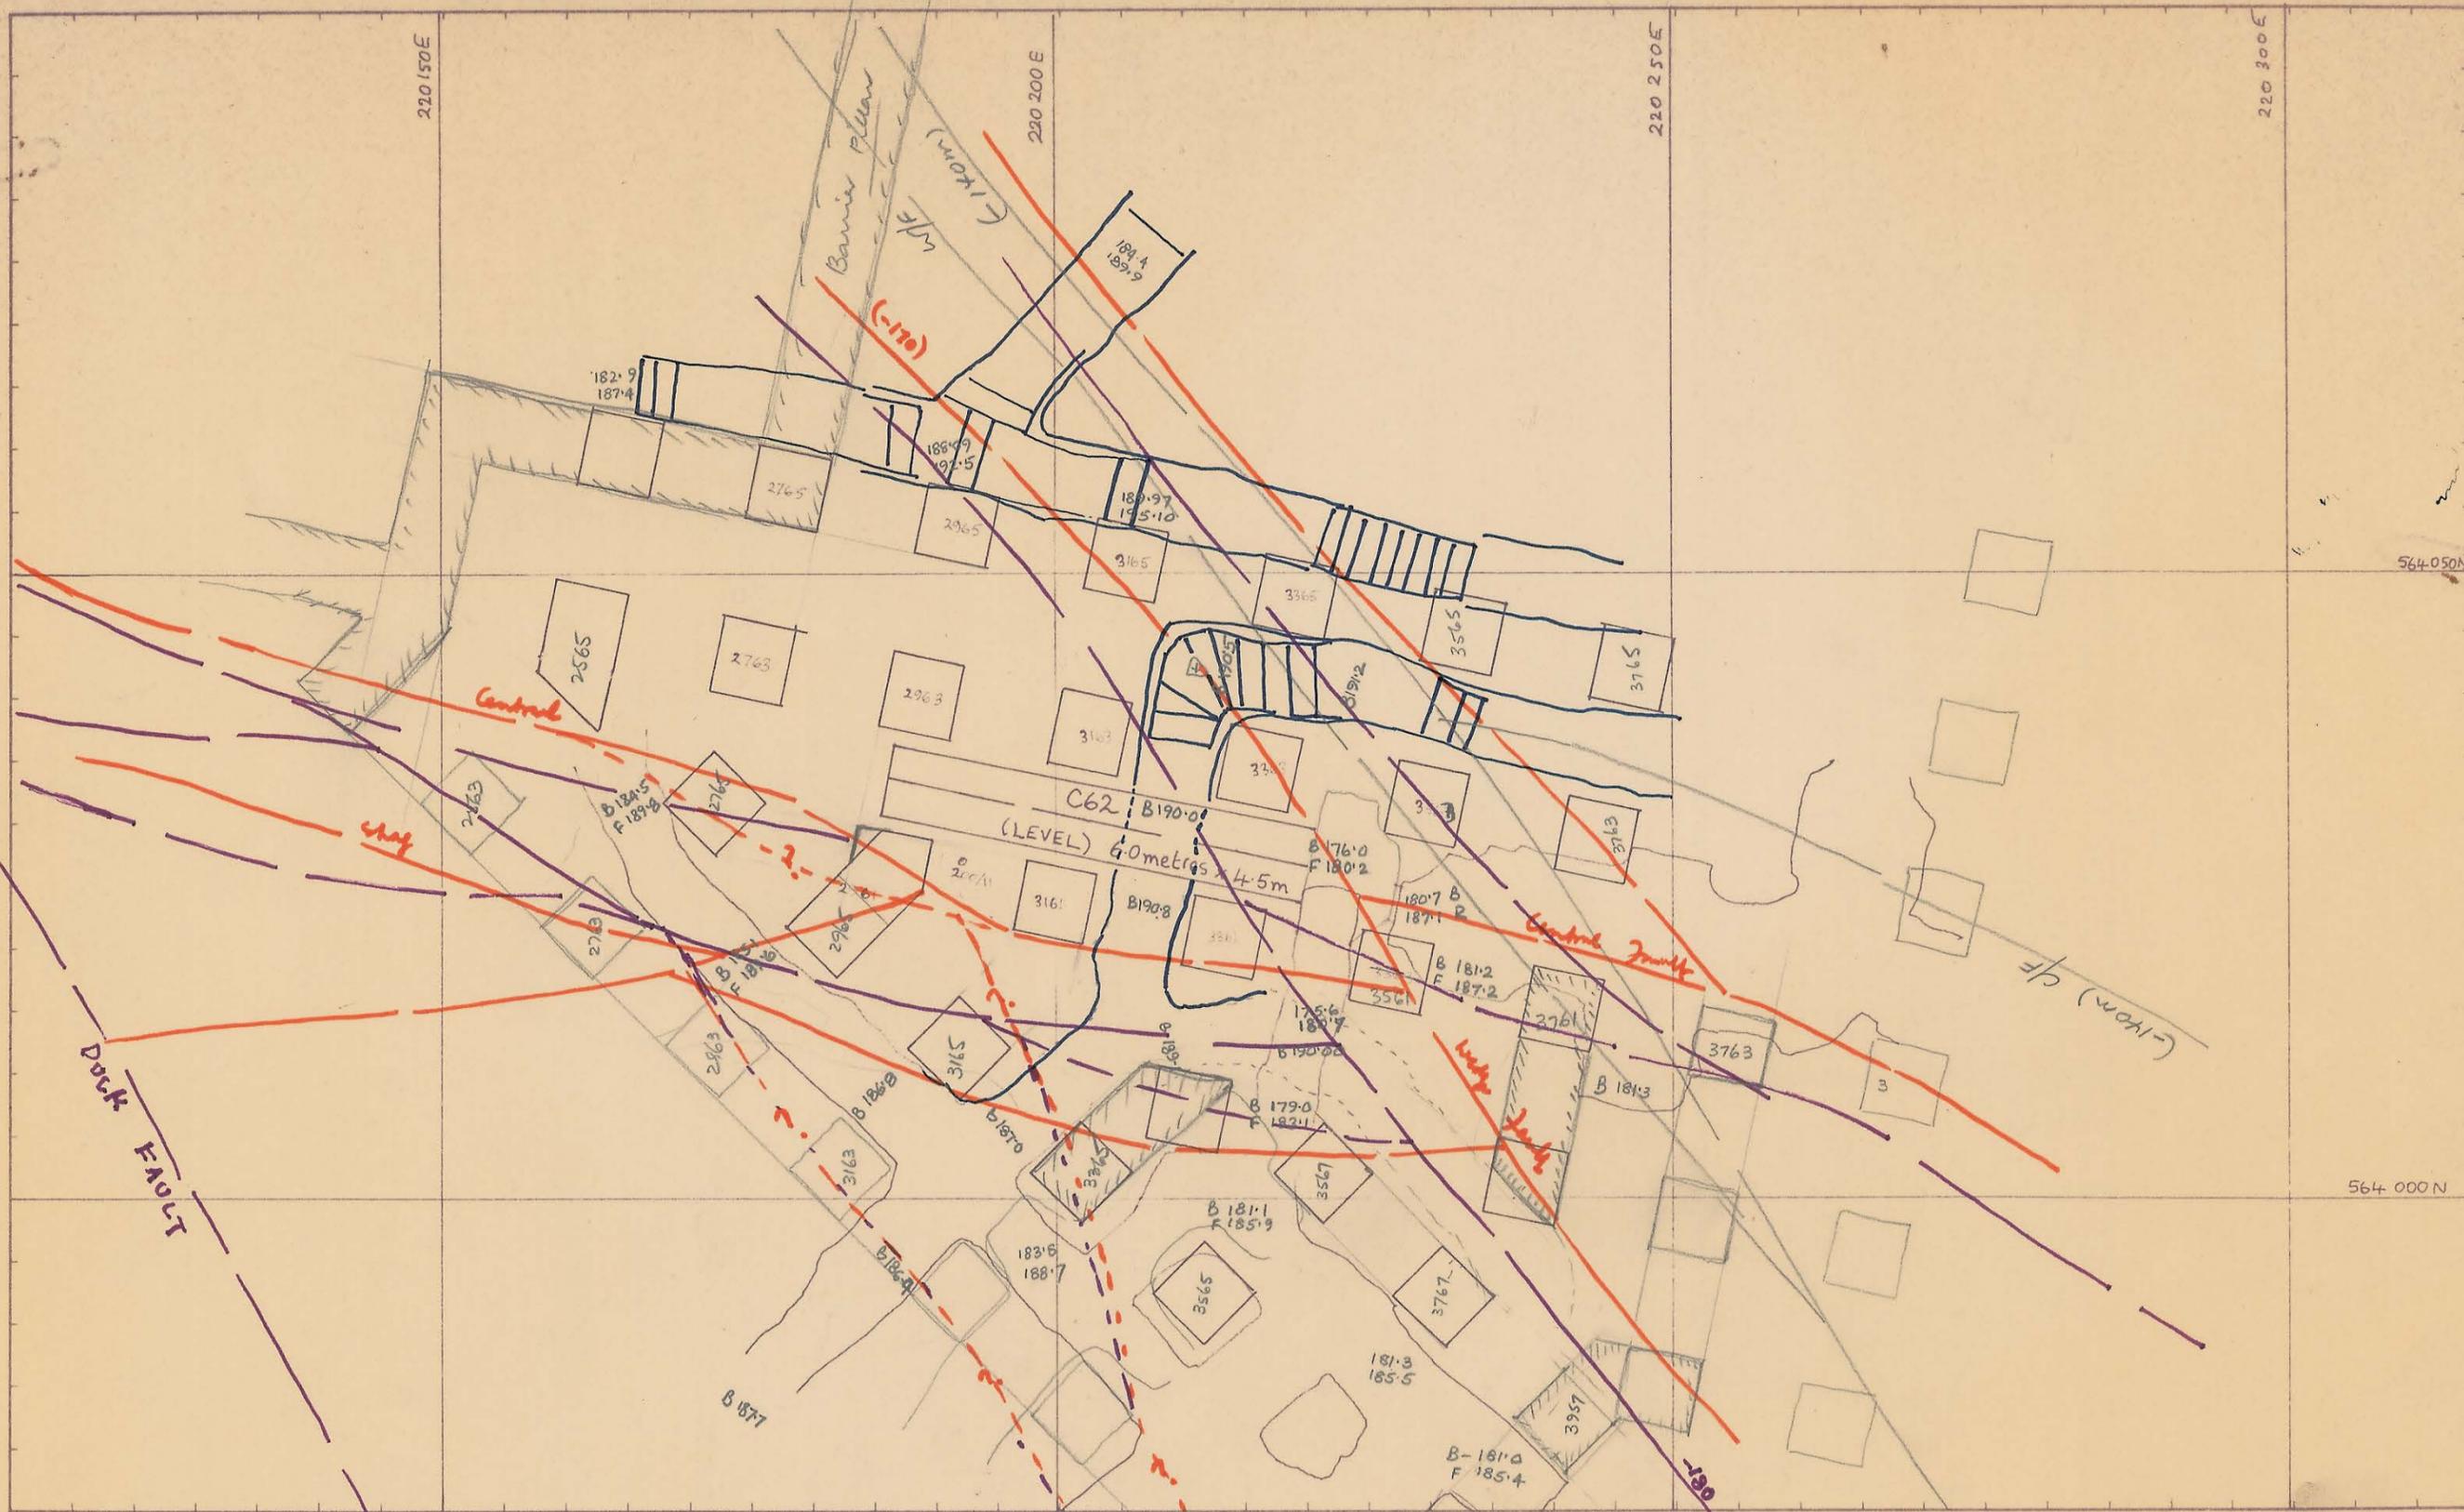

REF PLAN	GEOLOGY	SCALE 1:500	
	SURVEY		
	PLANNING	ADT 20-2-85	MID - CENTRAL UNDERCUT DRIVE C62
	ROCK MEC.	J/L 25/2/85	
	GRADE CON		DRAWING NUMBER
	DRAFTING		
	T.S.S.		