


0374\_2910

5 cm

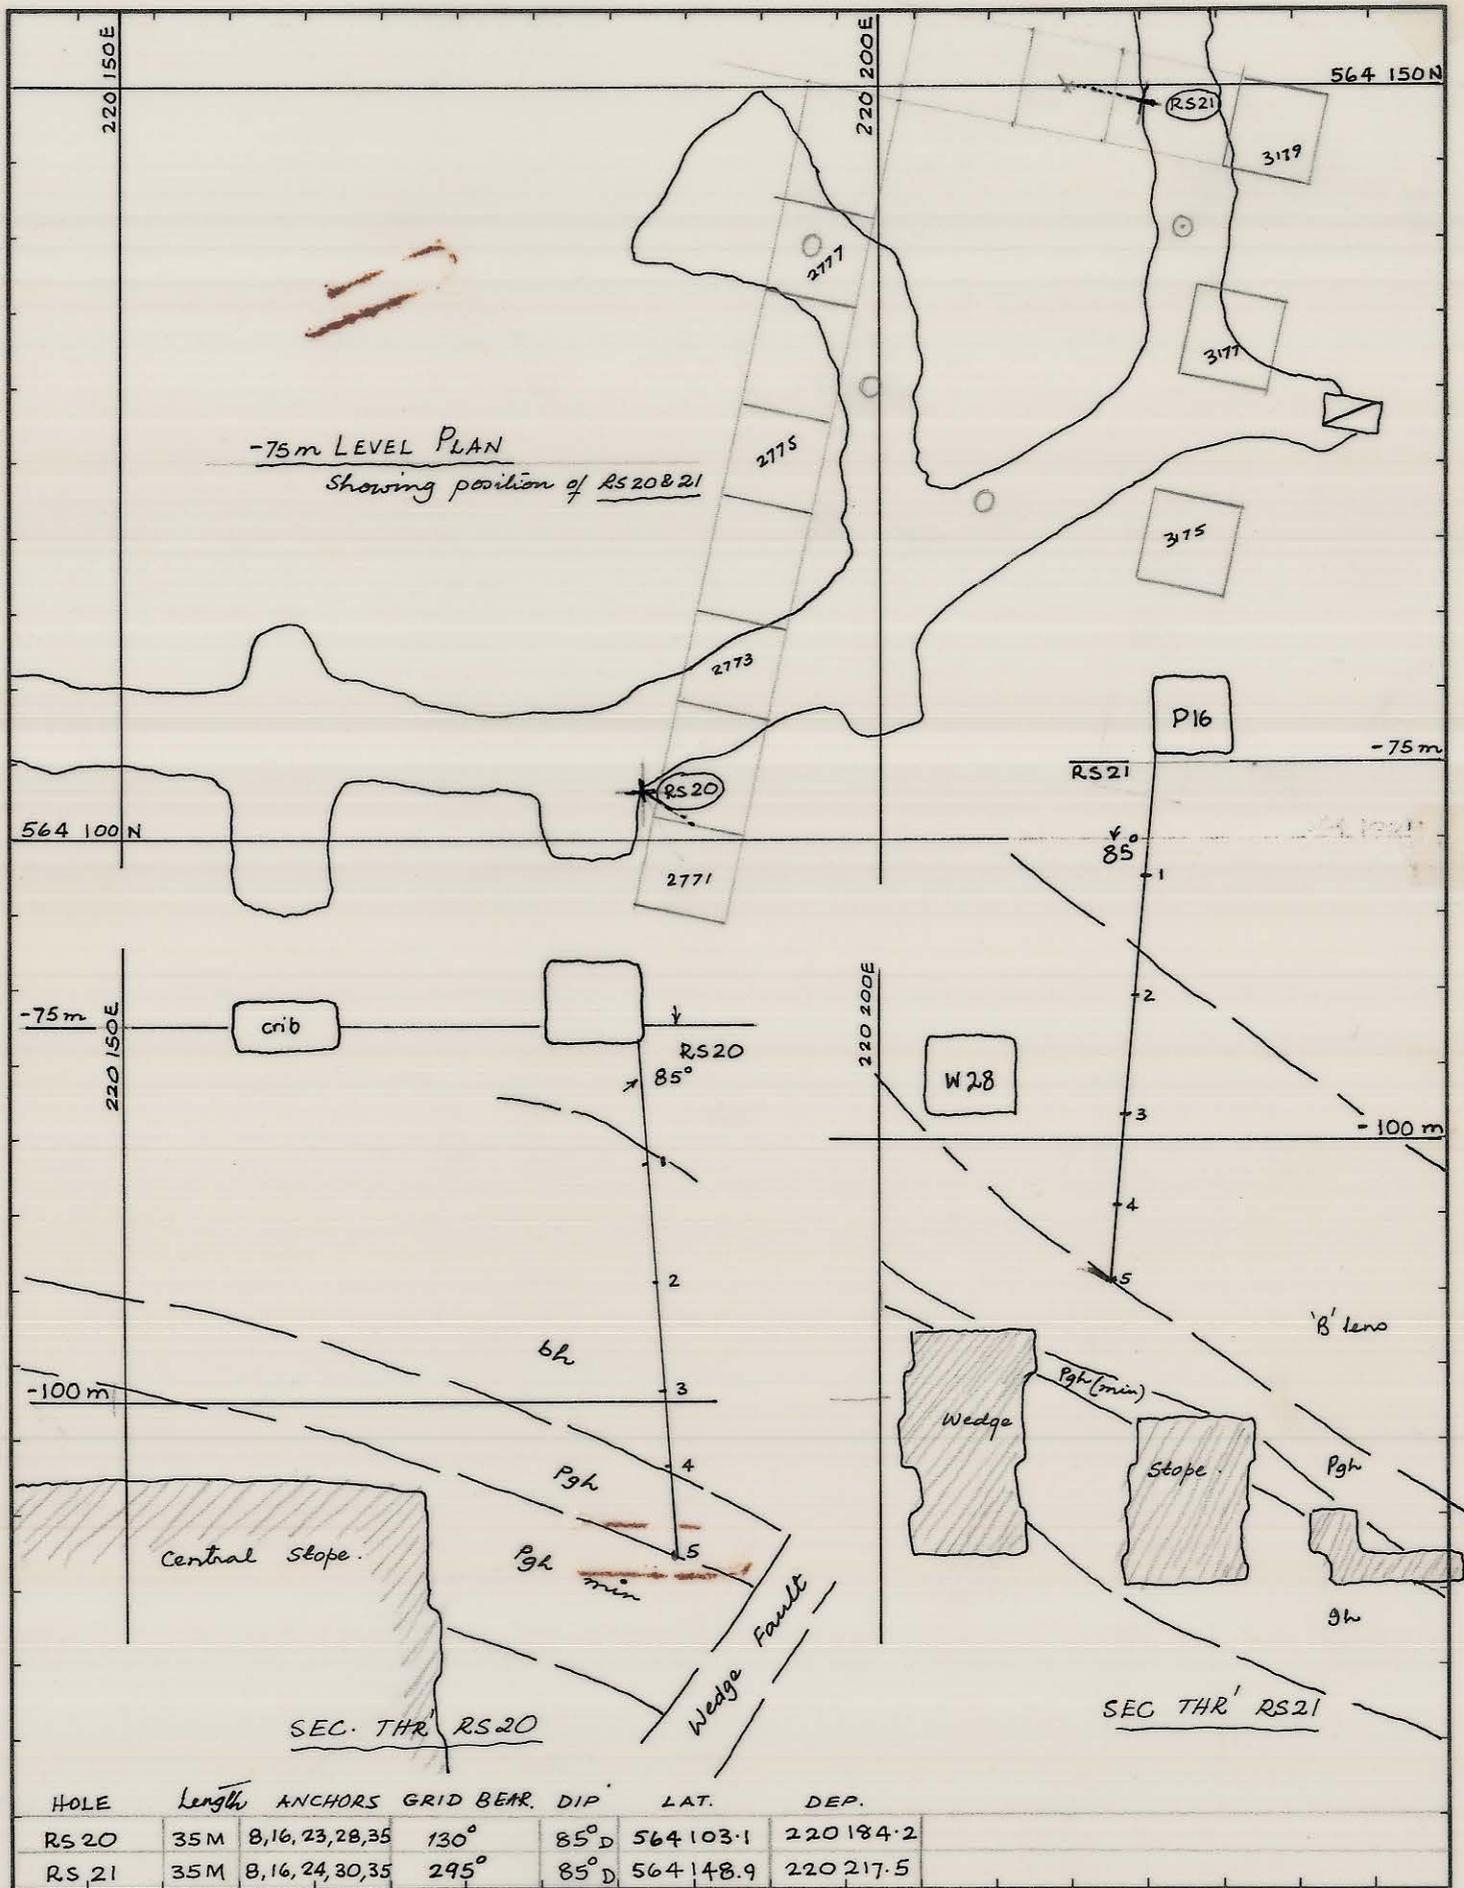

REF PLAN

MULTIPOINT EXTENSOMETERS  
RS 20 (REPLACEMENT FOR  
RS 4) & RS 21 (New).

GEOLOGY

SURVEY

PLANNING

ROCK. MEC. *2/8* Oct 83

GRADE CON.

DRAFTING

T.S.S.

1:500

SCALE

KING ISLAND SCHEELITE  
GRASSY KING ISLAND

EXTENSOMETERS RS 20 & RS 21  
TO MONITOR WEDGE FAULT  
REGION & LONG TERM MID  
WEDGE STOPE

DRAWING NUMBER