


DOLPHIN MINE VEHICLES

UNIT No.	MAKE & MODEL	VENT. RECD.
17-1	CAT 988	12.4 m <sup>3</sup> /sec
17-2	CAT 950	6.2 m <sup>3</sup> /sec
17-3	CAT 980B	12.9 m <sup>3</sup> /sec
17-8	CAT 980B	12.9 m <sup>3</sup> /sec
12-2	KIRUNA 250	14.0 m <sup>3</sup> /sec
12-4	KIRUNA 250	14.0 m <sup>3</sup> /sec
12-5	CAT 769B	18.7 m <sup>3</sup> /sec
15-3	CAT DS	6.6 m <sup>3</sup> /sec
18-1	G/D JUMBO	2.7 m <sup>3</sup> /sec
18-5	G/D JUMBO	1.7 m <sup>3</sup> /sec
18-9	G/D JUMBO	2.7 m <sup>3</sup> /sec
13-3	FIAT TRACT.	1.4 m <sup>3</sup> /sec
2-8	L/ROVER	2.2 m <sup>3</sup> /sec
2-12	L/ROVER	2.2 m <sup>3</sup> /sec
L-7	L/ROVER(Geopoko)	2.2 m <sup>3</sup> /sec

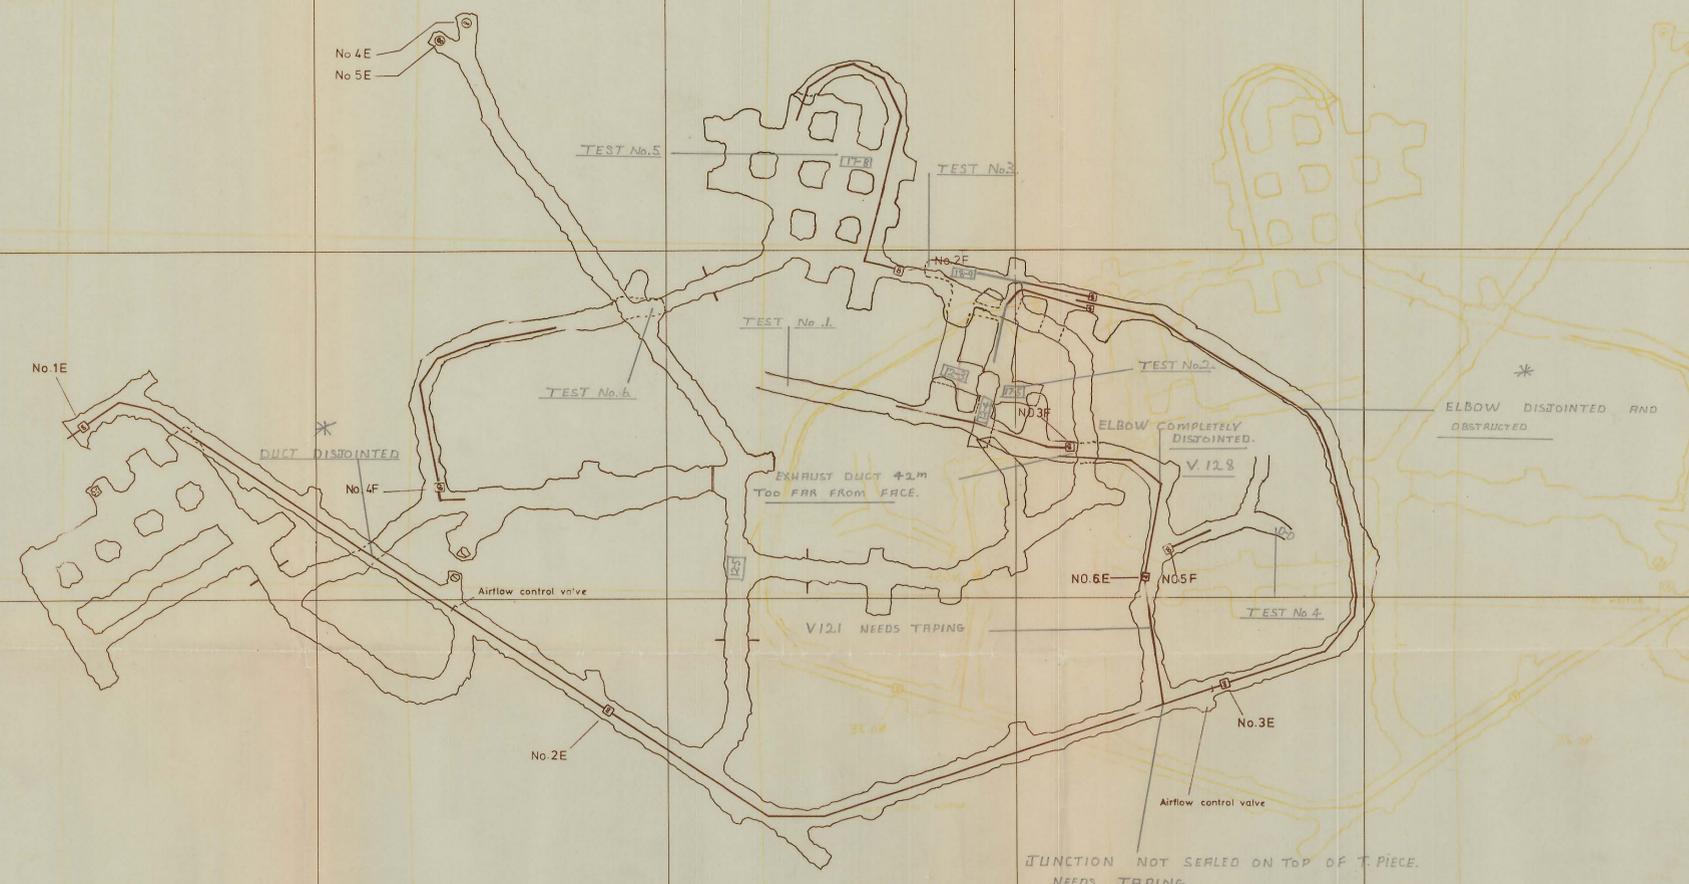

Q 13 DRIVE  
 BOTH SIDES OF EXHAUST FAN NEED TAPING.  
 V. 118 - V. 121 V. 133 - V. 135. TAPING.  
 ELBOW AT STN. 7236 (V123)  
 COMPLETELY DISJOINTED  
 EXHAUST INTAKE 4.2m TOO FAR FROM FACE.  
 FORCING 2.1m TOO FAR FROM FACE.

MAIN DECLINE  
 JOINTS ON FOLLOWING EXHAUST SECTIONS NEED TAPING.  
 V. 21.  
 V. 31 DISJOINTED.  
 V. 77.  
 V. 84.  
 V. 85.  
 V. 94.  
 V. 96.  
 BLANK AT 75' X CUT NOT SEALED PROPERLY.

EXHAUST FANS			FORCING FANS		
No	HP	LOCATION	No	HP	LOCATION
1E	60	PORTAL	1F	25	MAIN DECLINE
2E	60	MAIN DECLINE	2F	40	C-WEDGE
3E	60	MAIN DECLINE	3F	25	Q13 DRIVE
4E	60	MAIN OFFICE	4F	40	I16 DRIVE
5E	60	MAIN OFFICE	5F	40	Q15 DRIVE

TEST	GAS TEST										ANEMOMETER		DUST CM <sup>3</sup>
	20% O <sub>2</sub>	50 CO	5000 CO <sub>2</sub>	45 NO <sub>x</sub>	8 HCHO	5 NO <sub>2</sub>	5 SO <sub>2</sub>	10 H <sub>2</sub> S	FORCING	EXHAUST			
NO 1	NT	45	2000	20	NIL	3	NIL	NIL	7.9 m <sup>3</sup> /sec	3.9 m <sup>3</sup> /sec	25		
NO 2	NT	40	1500	25	NIL	8	NIL	NIL	11.4 m <sup>3</sup> /sec	N/A	15		
NO 3	NT	20	800	10	NIL	4	NIL	NIL	8.9 m <sup>3</sup> /sec	7.3 m <sup>3</sup> /sec	20		
NO 4	NT	70	200	200	NIL	NIL	NIL	NIL	7.8 m <sup>3</sup> /sec	N/A	NIL		
NO 5	NT	50	200	10	NIL	2	NIL	NIL	4.2 m <sup>3</sup> /sec	N/A	35		
NO 6	NT	NIL	200	NIL	NIL	NIL	NIL	NIL	5.2 m <sup>3</sup> /sec	N/A	NT		
NO 7													
NO 8													
NO 9													
NO 10													

KING ISLAND SCHEELITE  
 SCALE 1:1000 No 1-22-63  
 DOLPHIN MINE  
 VENTILATION TEST PLAN  
 DATE 3-7-75  
 SURVEYED M.S.M.  
 DRAWN M.D.B.  
 TRACED  
 CHECKED M.S.M.