


0374_2930

07DM03.1-1003
(Print Only)

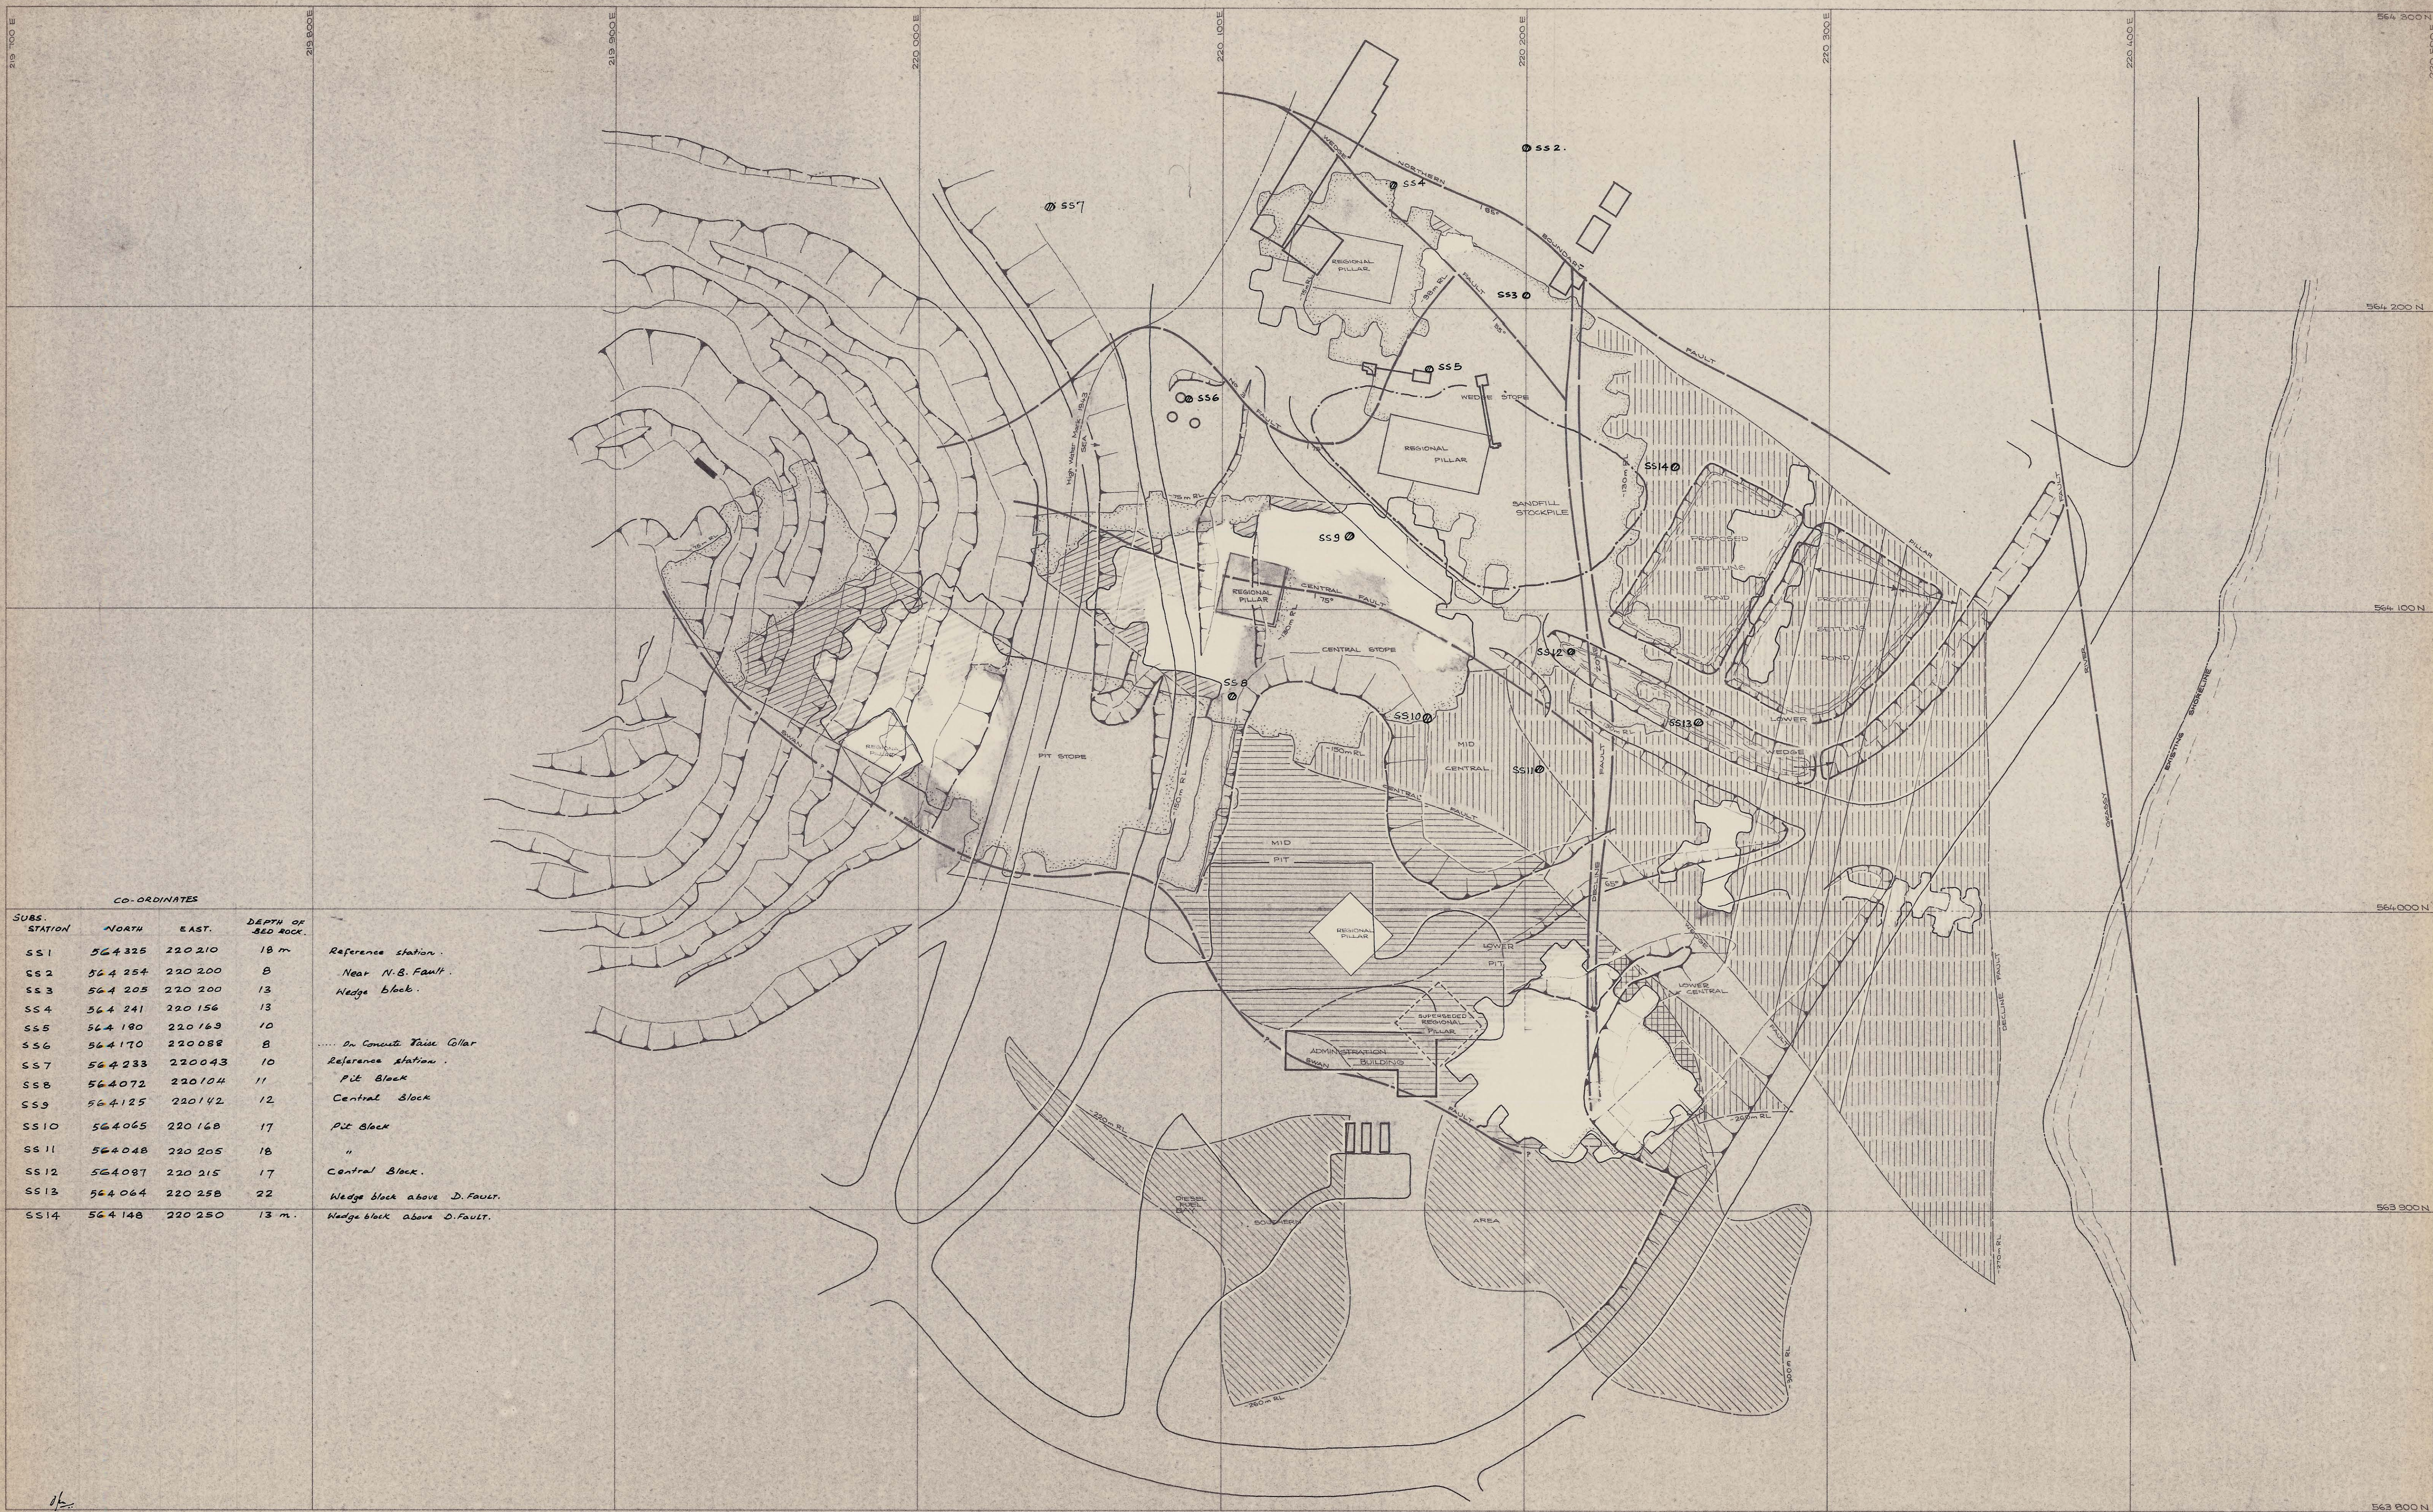

CO-ORDINATES				
SUBS. STATION	NORTH	EAST	DEPTH OF BED ROCK	
SS 1	564 325	220 210	18 m	Reference station.
SS 2	564 254	220 200	8	Near N.B. Fault.
SS 3	564 205	220 200	13	Wedge block.
SS 4	564 241	220 156	13	
SS 5	564 180	220 169	10	
SS 6	564 170	220 088	8	On Concrete Tasse Collar
SS 7	564 233	220 043	10	Reference station.
SS 8	564 072	220 104	11	Pit Block
SS 9	564 125	220 142	12	Central Block
SS 10	564 065	220 168	17	Pit Block
SS 11	564 048	220 205	18	"
SS 12	564 087	220 215	17	Central Block.
SS 13	564 064	220 258	22	Wedge block above D. Fault.
SS 14	564 148	220 250	13 m.	Wedge block above D. Fault.

Trace of Faults at Surface Bedrock

DRAWN: R.D.F.
TRACED: B.J.C.

SCALE 1:1000

MINED & FILLED
TO BE MINED (immediate future)
FUTURE MINING

LOCATION: DOLPHIN MINE

SUBJECT: SURFACE SUBSIDENCE STATIONS.
COMPOSITE PLAN
OUTLINING PRESENT & FUTURE STOPING AREAS
ROCK MECHANICS.

north

KIS KING ISLAND SCHEELITE
A DIVISION OF WARRIOR INTERNATIONAL

GRASSY KING ISLAND

PLAN NUMBER: 07DM03.1 - 1003