


5 cm

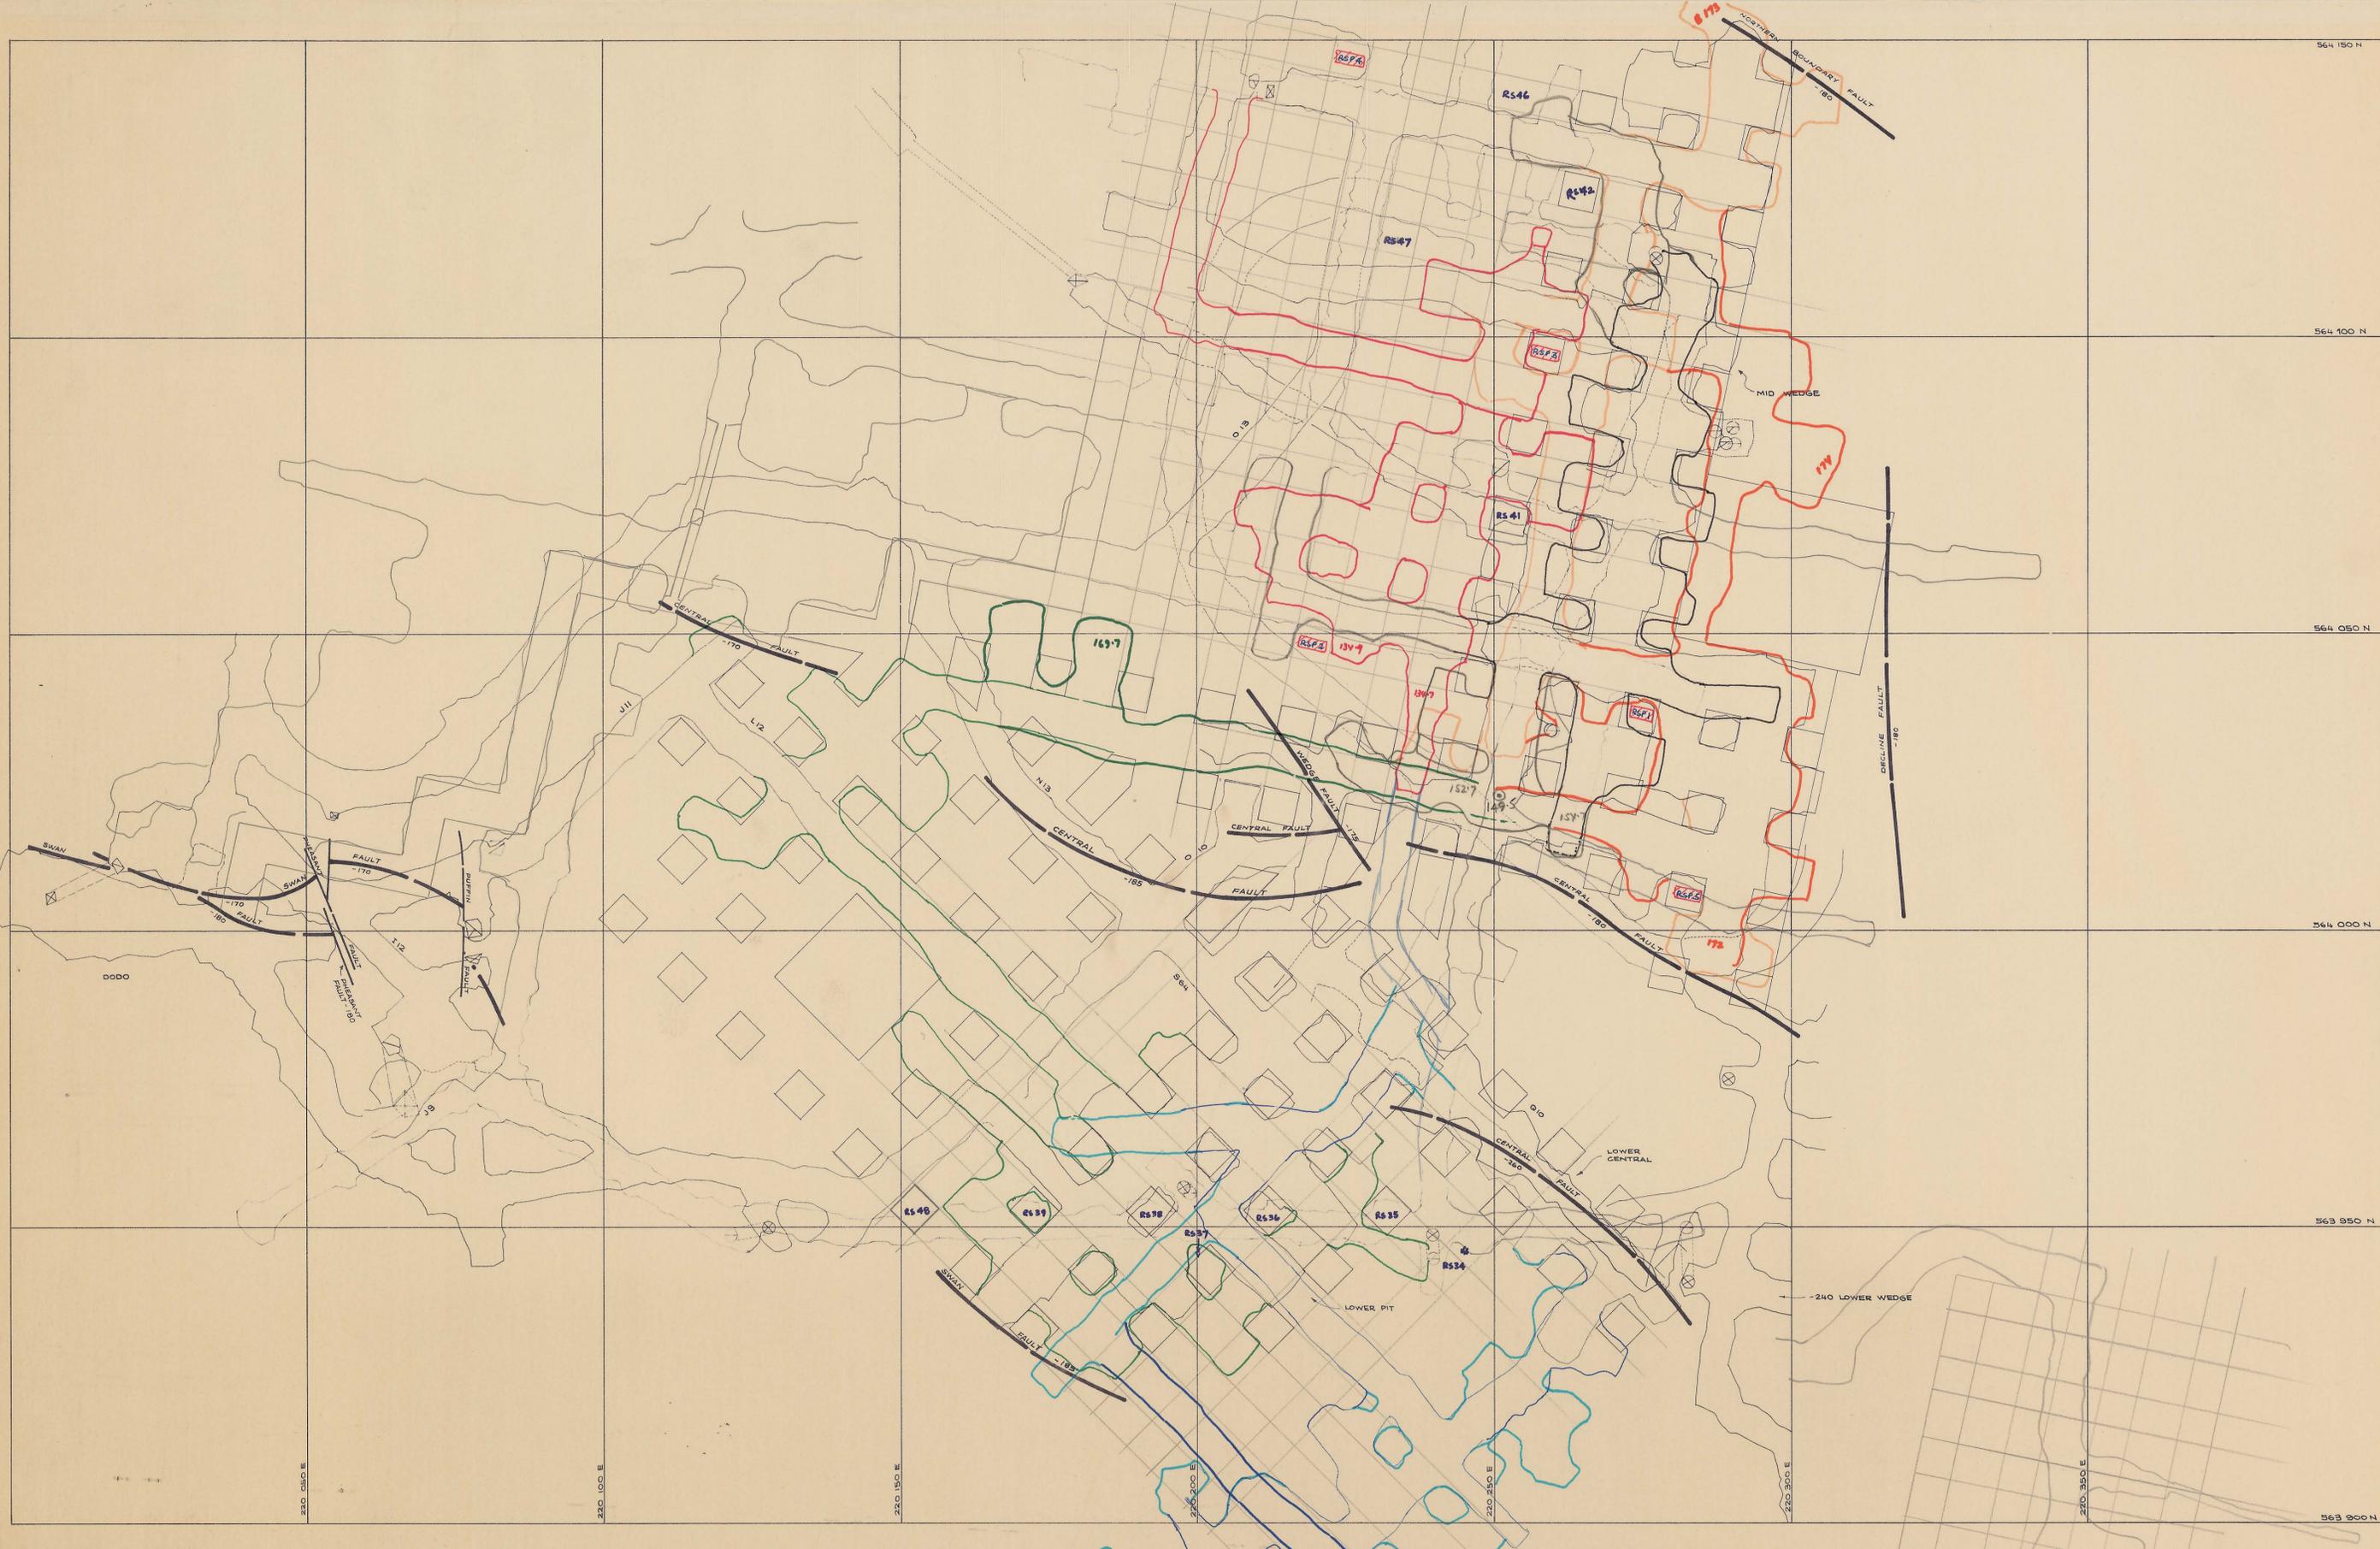

<p>SCALE 1:500</p> <p>north</p>	<p>LOCATION DOLPHIN MINE</p>	<p>KIS KING ISLAND SCHEELITE A DIVISION OF WARMAN INTERNATIONAL</p>
<p>GRASSY</p>	<p>SUBJECT COMPOSITE PLAN of LOWER PIT & CENTRAL, MID WEDGE & DODO STOPES</p>	<p>KING ISLAND</p>
<p>PLAN NUMBER</p>	<p>07DM03 - 1 - 1004</p>	<p>07DM03 - 1 - 1004</p>