

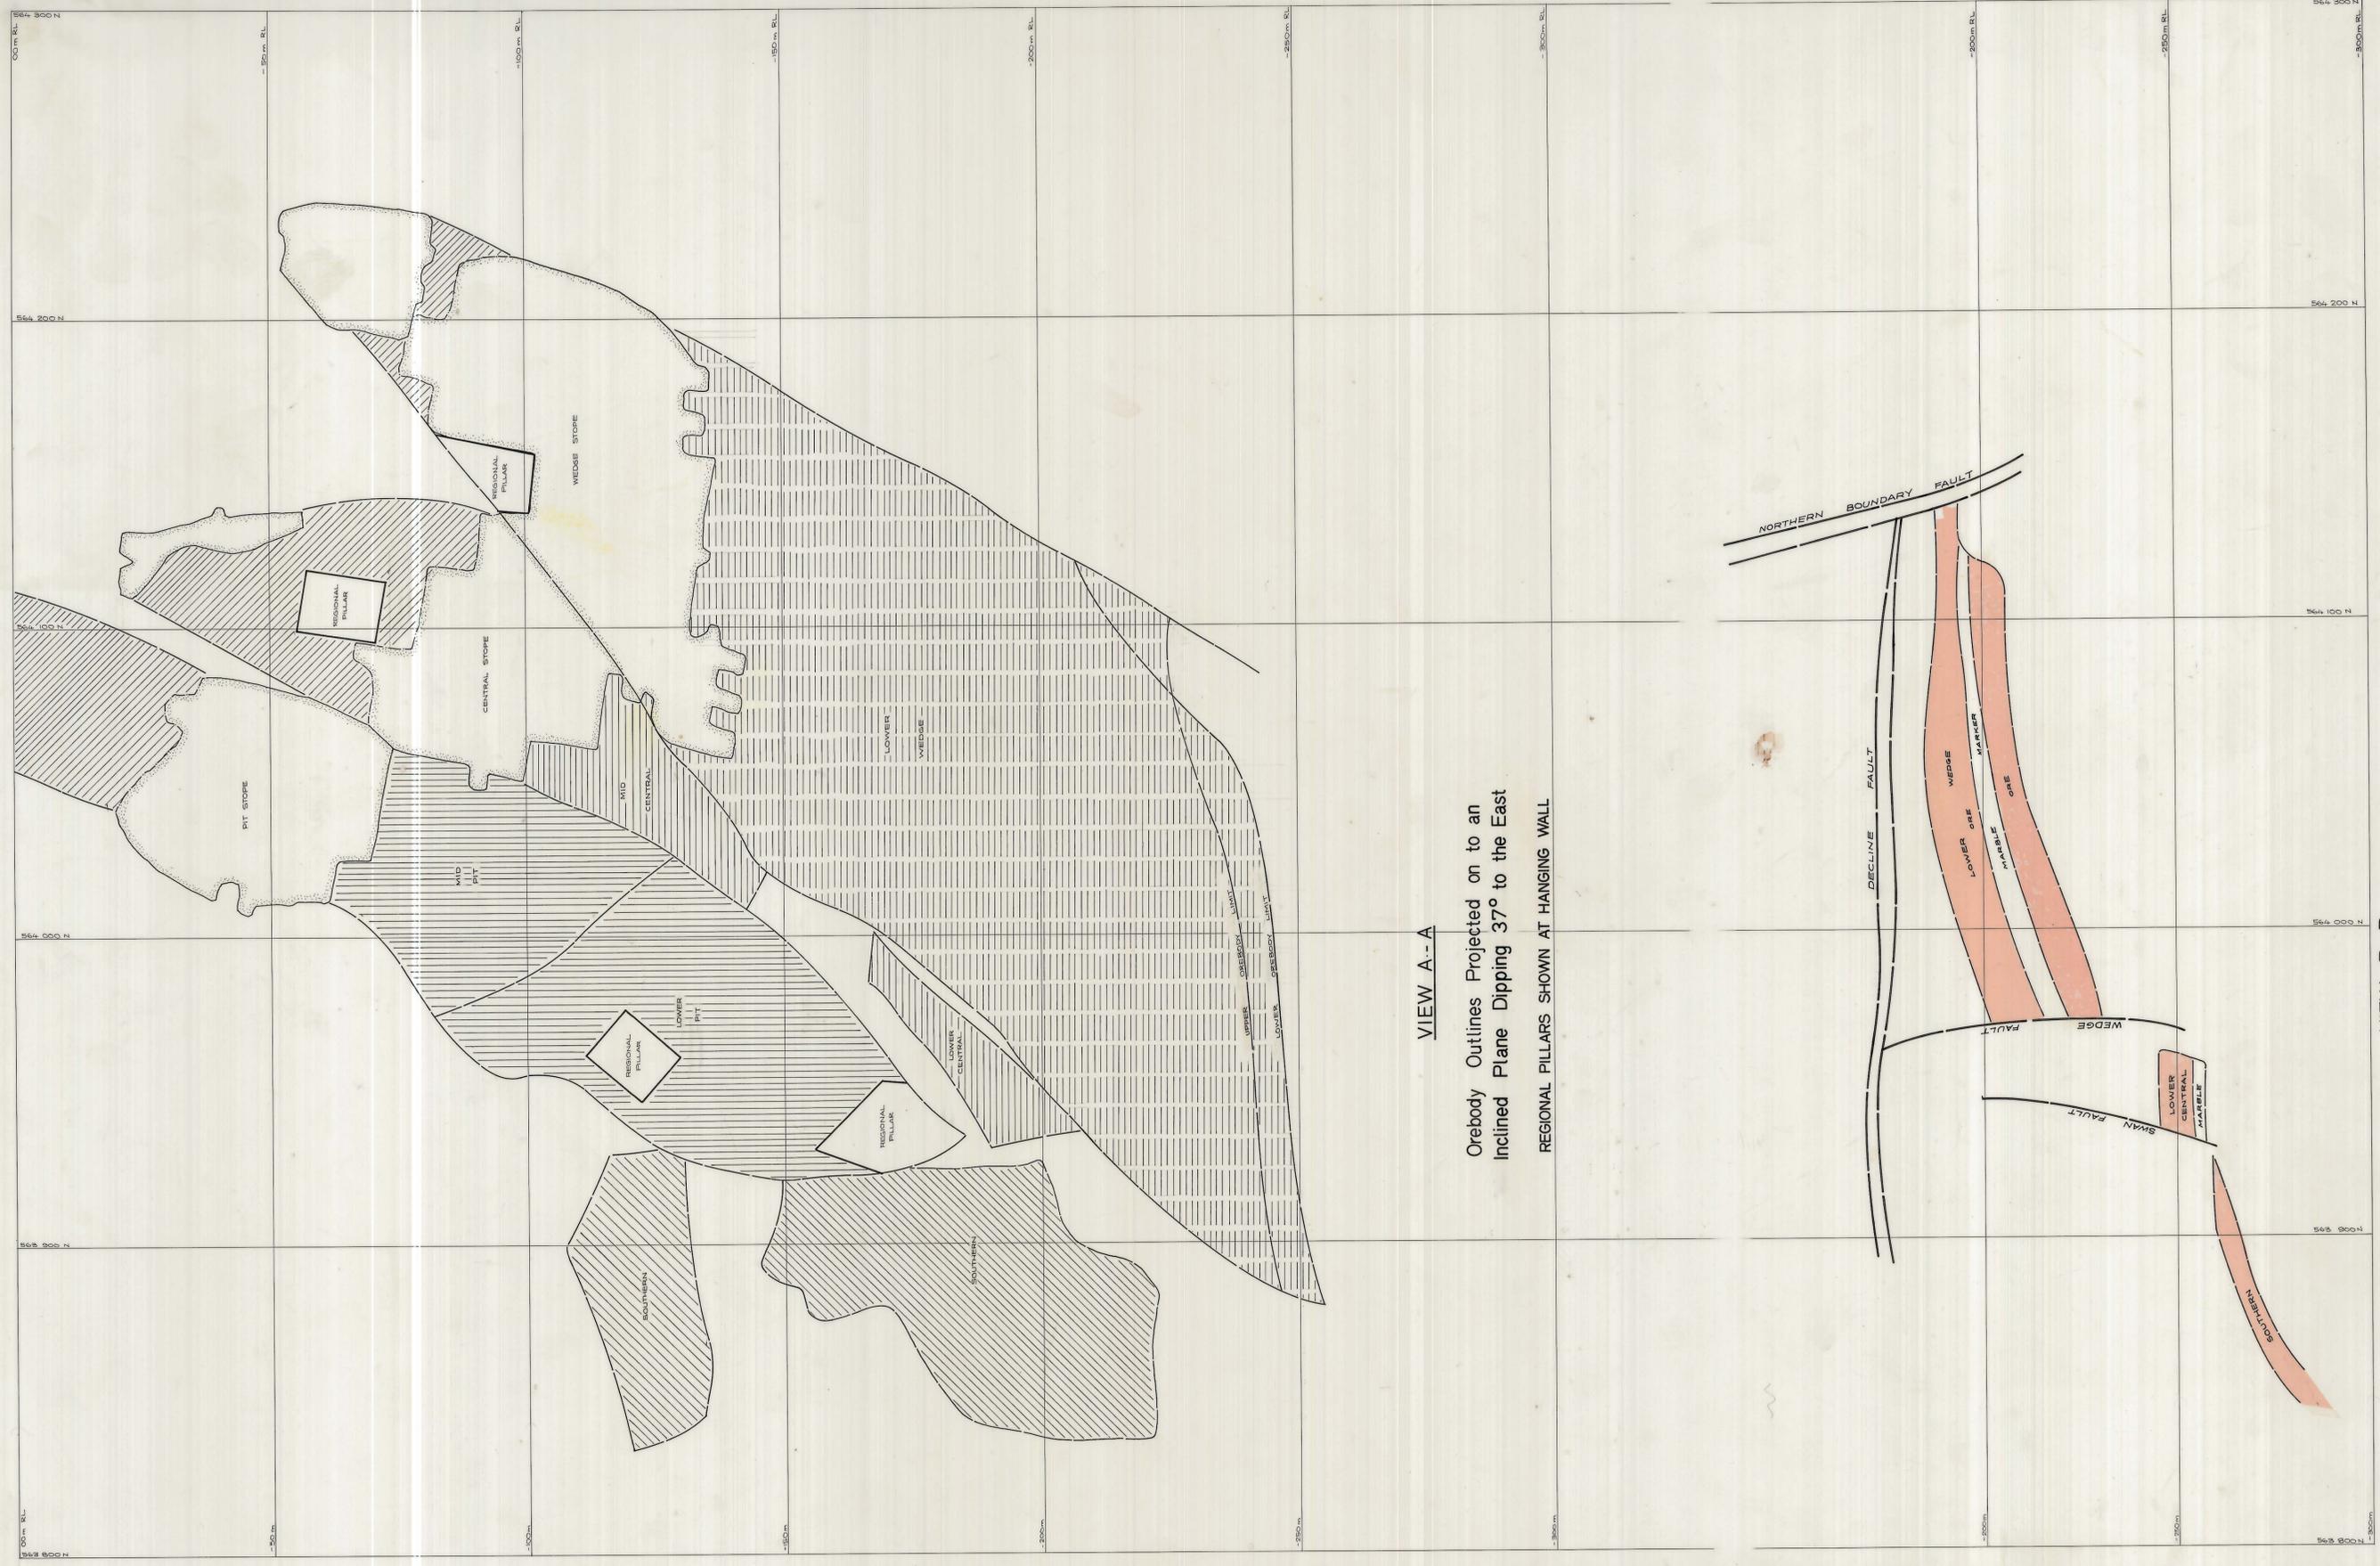


27 JUN 1981

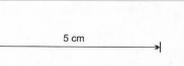

VIEW A - A
 Orebody Outlines Projected on to an
 Inclined Plane Dipping 37° to the East
 REGIONAL PILLARS SHOWN AT HANGING WALL

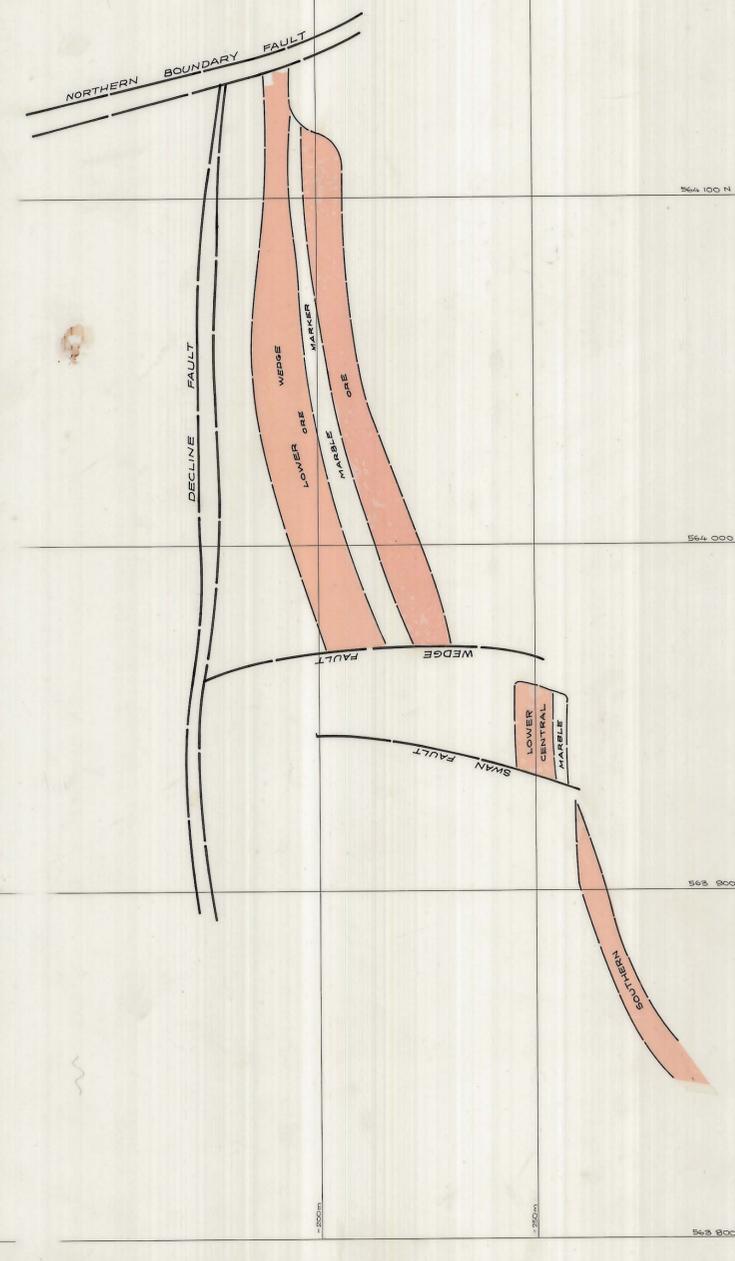

VIEW B - B
 Lower Wedge Orebody looking Up Dip

SURVEYED DATE DRAWN R. Friday TRACED B. Collis DATE 2 - 4 - 79 CHECKED SHEET OF SHEETS		SCALE 1:1000 MINED & FILLED TO BE MINED (Immediate future) FUTURE MINING	LOCATION DOLPHIN MINE SUBJECT OUTLINE OF PRESENT & PAST STOPING AREAS PROJECTED VIEWS north	 A DIVISION OF WARMAN INTERNATIONAL GRASSY KING ISLAND PLAN NUMBER 07DM03 - 1002
--	--	---	---	---