


5 cm

DOLPHIN MINE VEHICLES

UNIT No	MAKE & MODEL	VENT. REQD.
17-1	CAT 988	12.4m ³ /sec.
17-2	CAT 950	6.2m ³ /sec.
17-3	CAT 980B	12.9m ³ /sec.
17-8	CAT 980B	12.9m ³ /sec.
12-2	KIRUNA 250	14.0m ³ /sec.
12-4	KIRUNA 250	14.0m ³ /sec.
12-5	CAT 769B	18.7m ³ /sec.
15-3	CAT D5	6.6m ³ /sec.
18-1	G/D JUMBO	2.7m ³ /sec.
18-5	G/D JUMBO	1.7m ³ /sec.
18-9	G/D JUMBO	2.7m ³ /sec.
13-3	FAIT TRACT.	1.4m ³ /sec.
2-8	L/ROVER	2.2m ³ /sec.
2-12	L/ROVER	2.2m ³ /sec.
L-7	L/ROVER(Gropeko)	2.2m ³ /sec.
17-7	CAT 922	4.5m ³ /sec.

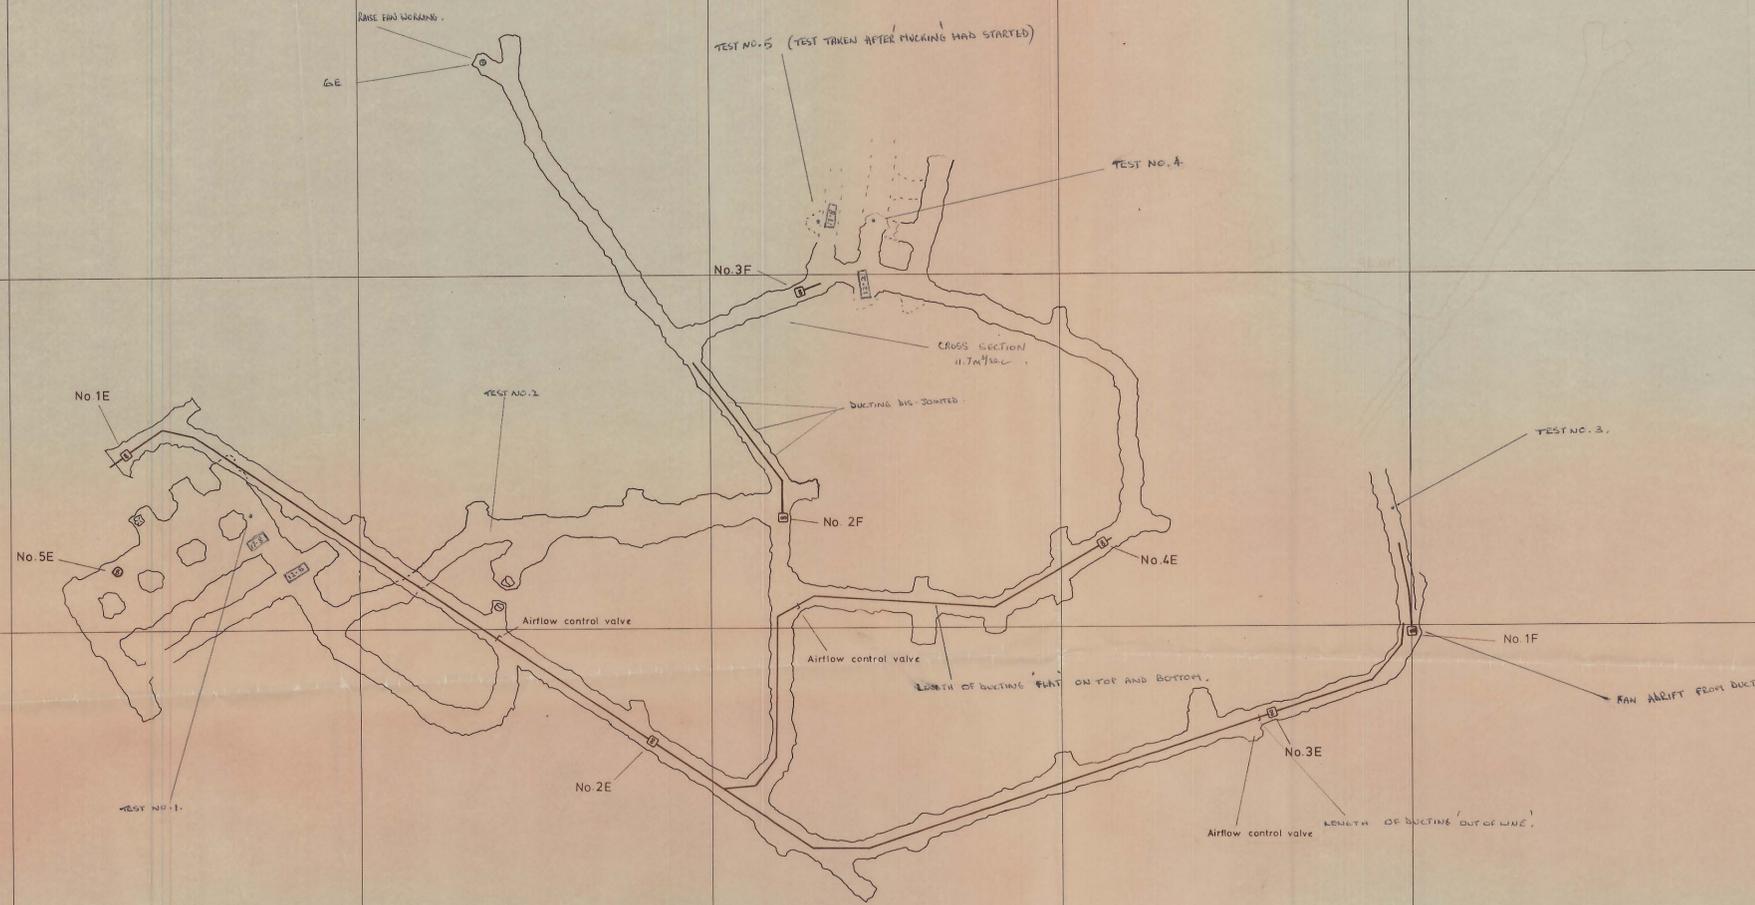

EXHAUST FANS			FORCING FANS		
No	HP	LOCATION	No	HP	LOCATION
1E	60	PORTAL	1F	25	MAIN DECLINE
2E	60	MAIN DECLINE	2F	40	L16 DRIVE
3E	60	MAIN DECLINE	3F	10	C-WEDGE
4E	40	B-LENS			
5E	60	19 BENCH			
6E	60	MAIN OFFICE			

GAS TEST										ANEMOMETER	
TEST	20% O ₂	50 CO	5000 CO ₂	25 NO _x	5 HCHO	5 NO ₂	5 SO ₂	10 H ₂ S	FORCING	EXHAUST	
NO 1	-	TRACE	-	10	-	NIL	NIL	NIL	-	Vitakar	
NO 2	-	NIL	-	5	-	NIL	NIL	NIL	-	-	
NO 3	-	NIL	-	TRACE	-	NIL	NIL	NIL	5.4 m ³ /sec	22.2 m ³ /sec	
NO 4	-	NIL	-	10	-	NIL	NIL	NIL	7.2 m ³ /sec	Via Boss	
NO 5	-	10	-	20	-	1	NIL	NIL	-	Via Boss	
NO 6											
NO 7											
NO 8											
NO 9											
NO 10											

DATE 18/2/75

KING ISLAND SCHEELITE
SCALE 1:1000 No 1-22-63

DOLPHIN MINE
VENTILATION TEST PLAN

DATE 3-2-75
SURVEYED M.G.M.
DRAWN M.D.B.
TRACED