
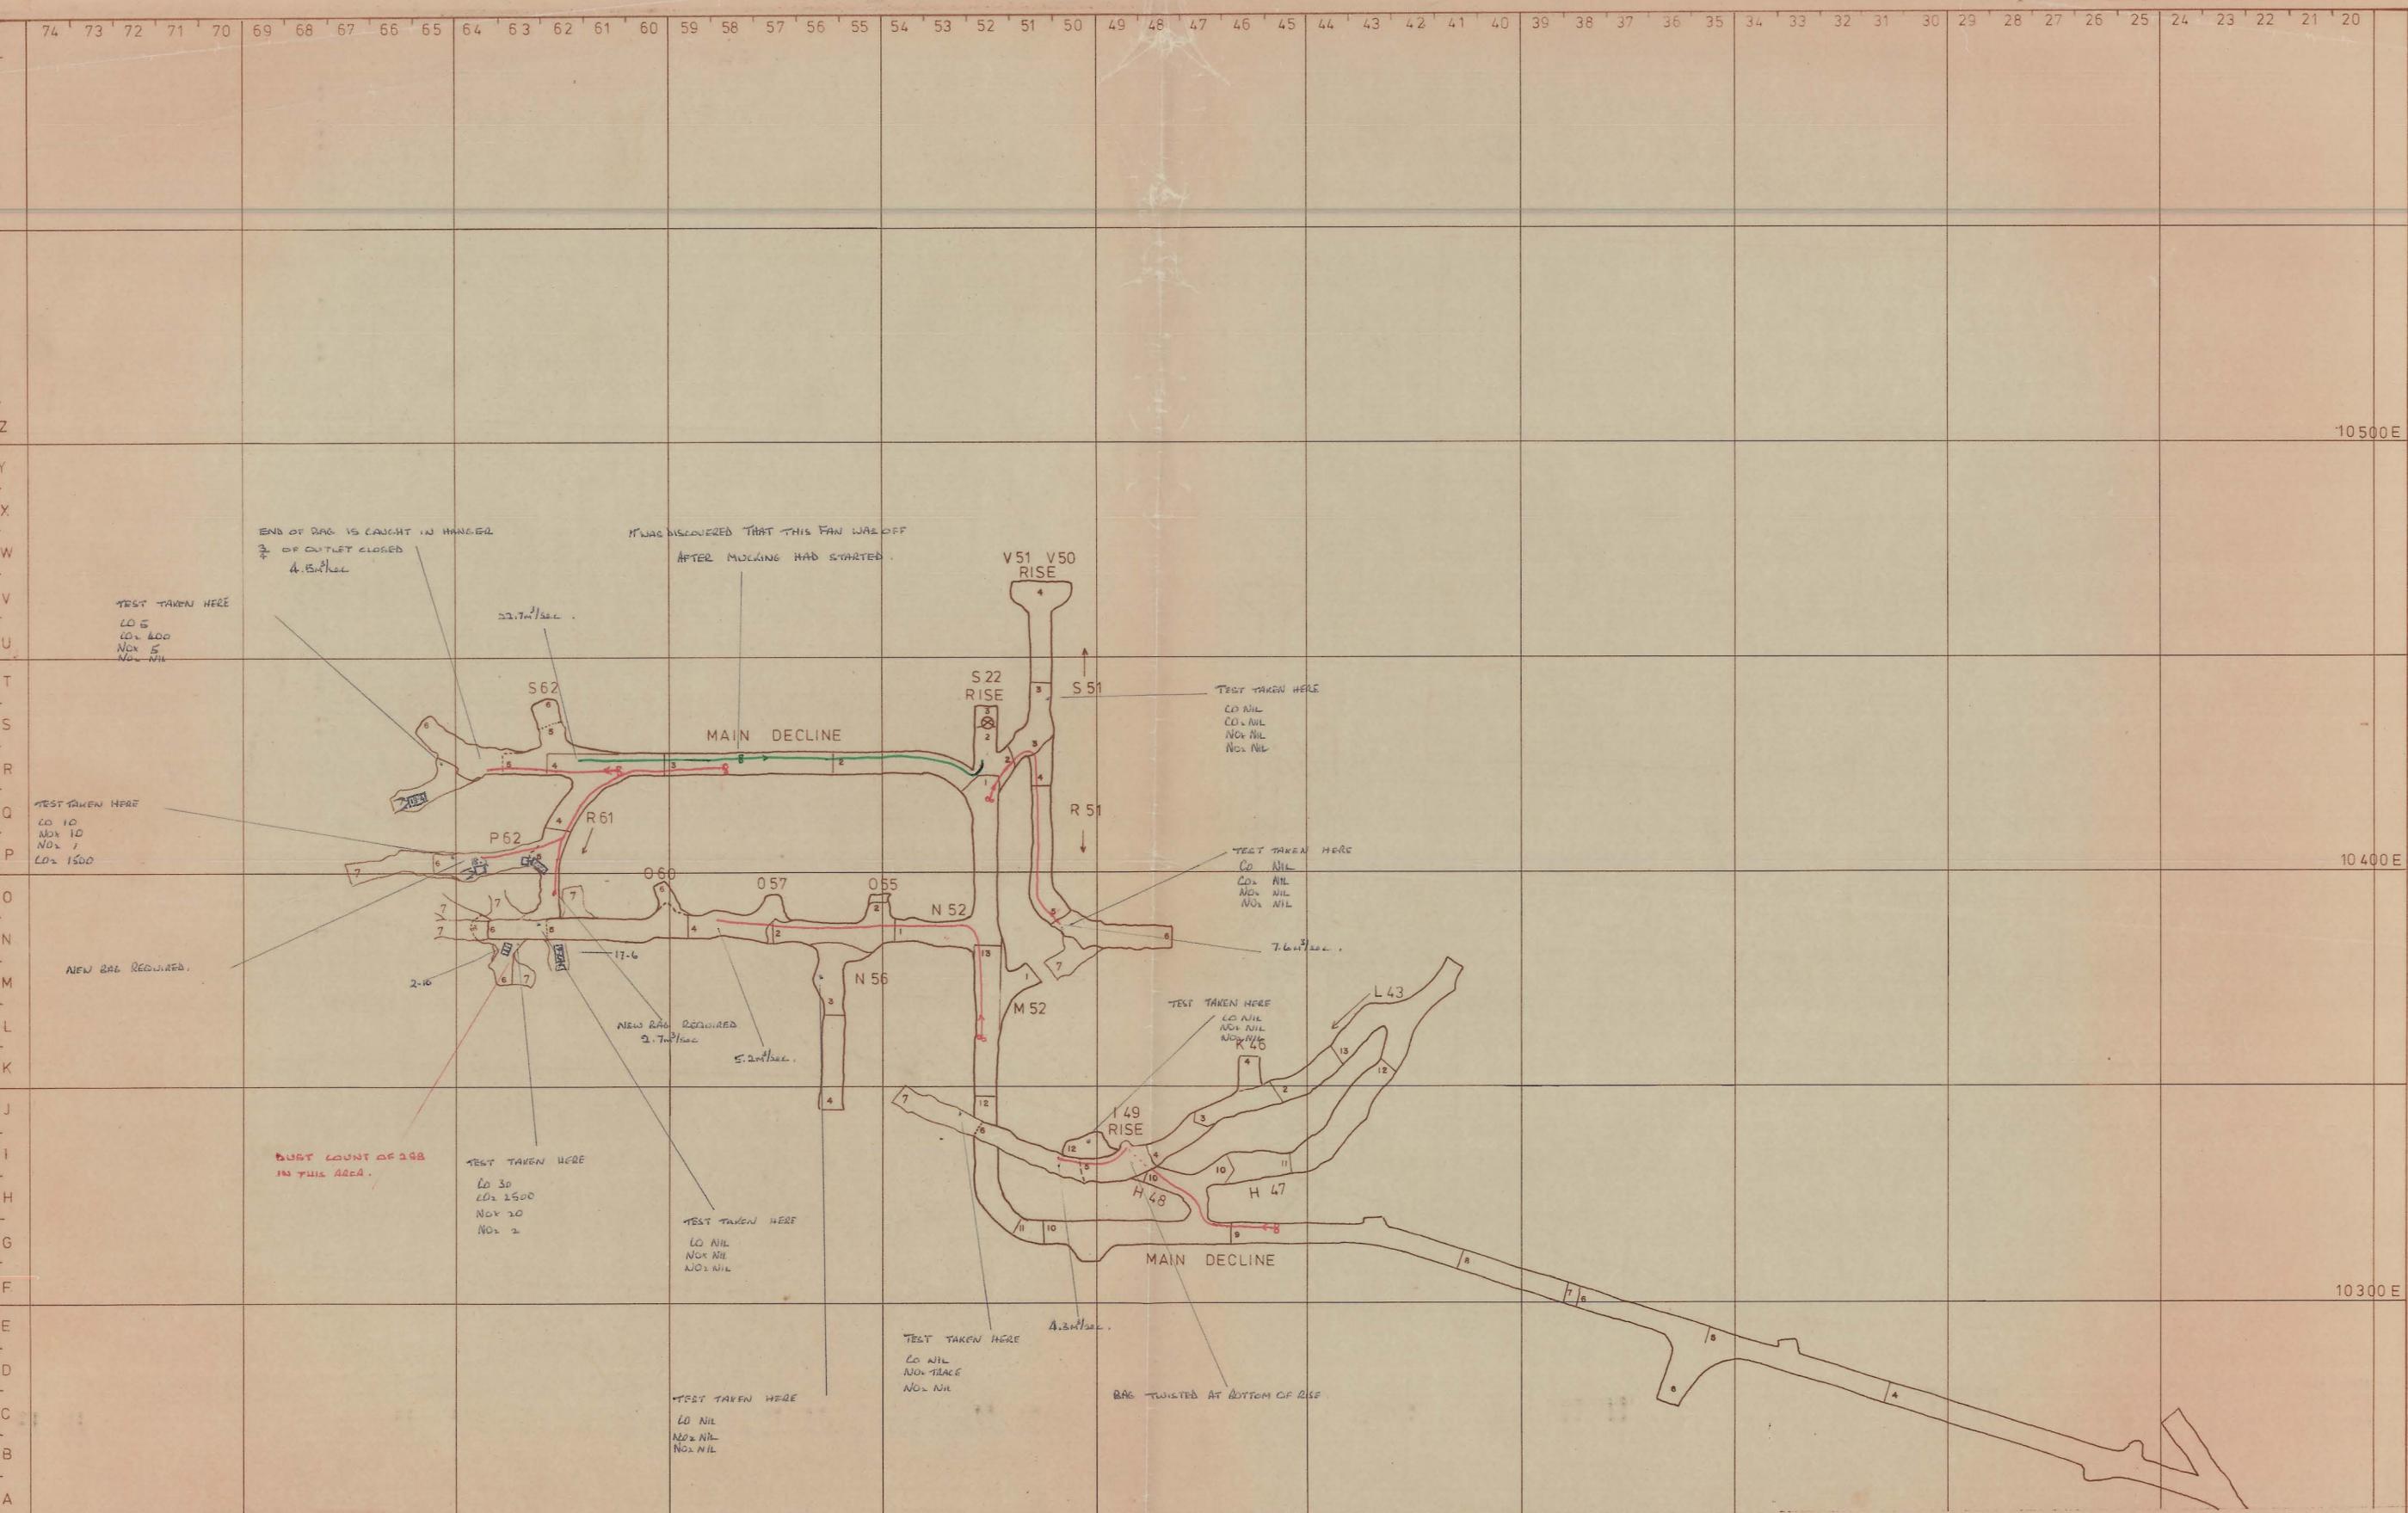


5 cm

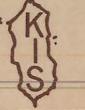

	<b>KING ISLAND SCHEELITE</b>	
	SCALE 1:1000	No 1-5-75
	<b>BOLD HEAD MINE</b> PERIOD REPORT PLAN 8 PERIOD ending 21-1-75	

10 700 N

10 600 N

10 500 N

10 400 N

10 500 E

10 400 E

10 300 E