




0374_2956

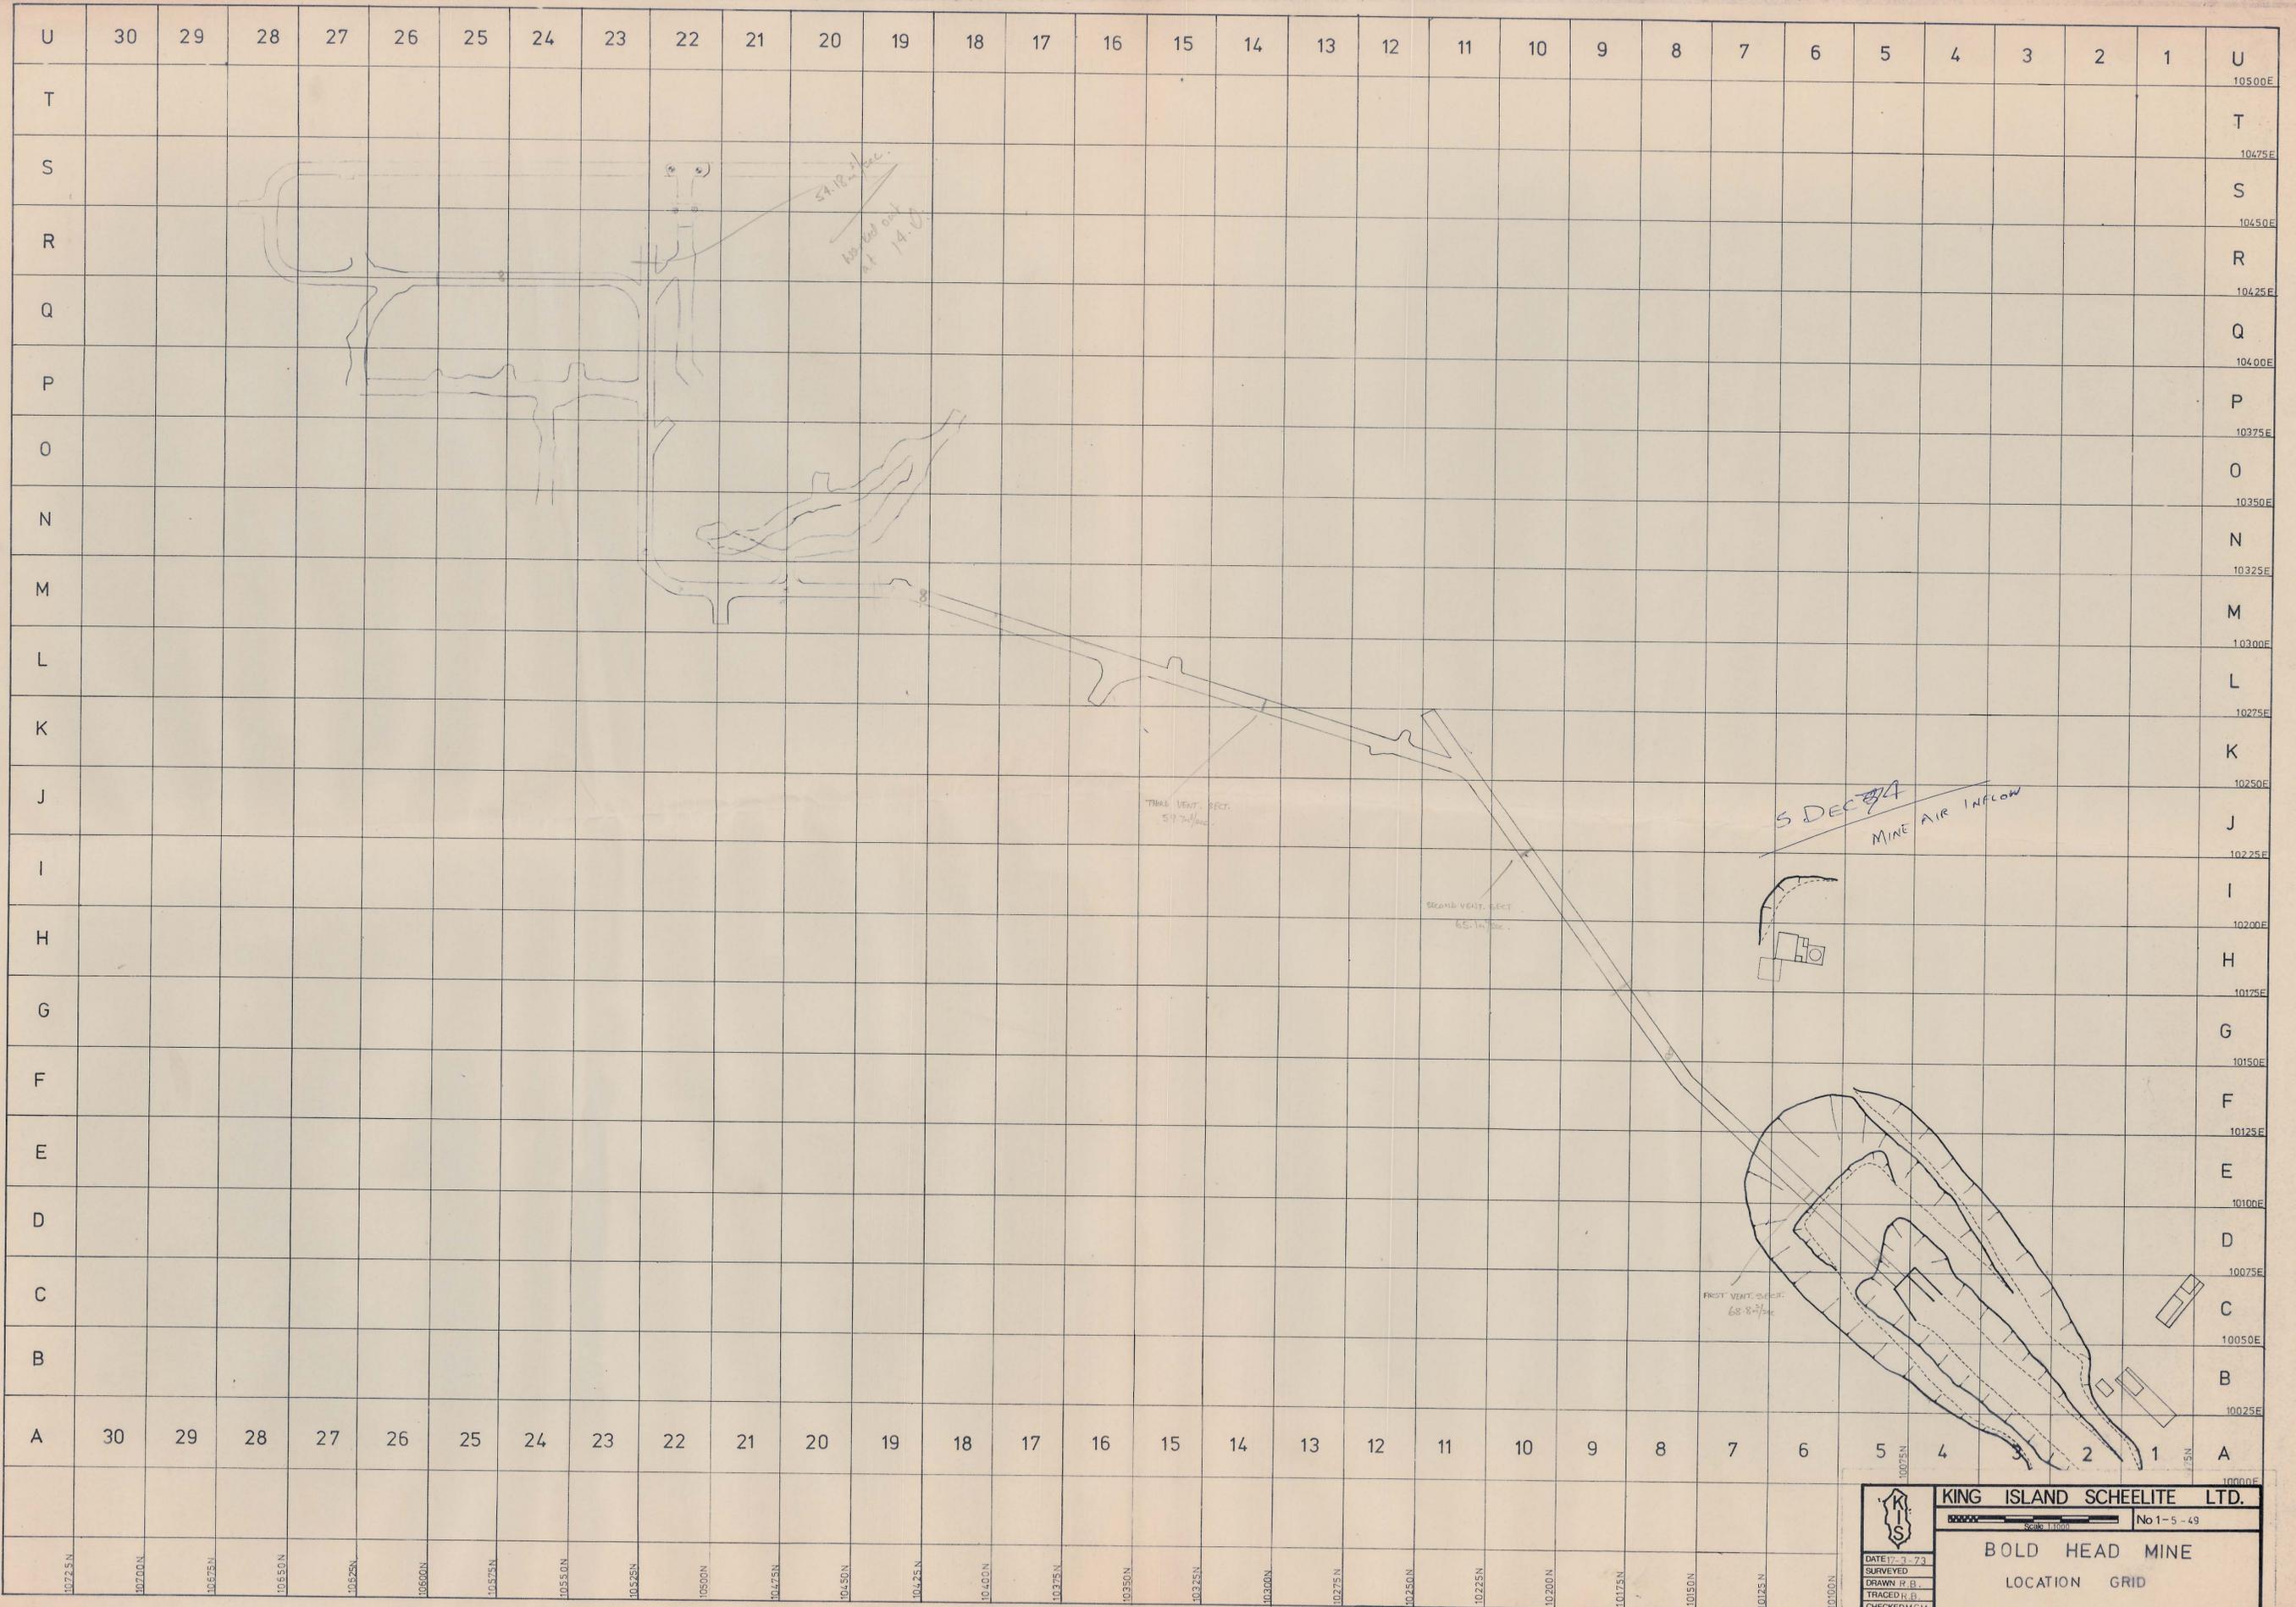

	KING ISLAND SCHEELITE LTD.	
	Scale 1:1000 No 1-5-49	
BOLD HEAD MINE		
LOCATION GRID		
DATE: 1-3-73		
SURVEYED:		
DRAWN: R.B.		
TRACED: R.B.		
CHECKED: M.G.M.		