


5 cm

0374_2962

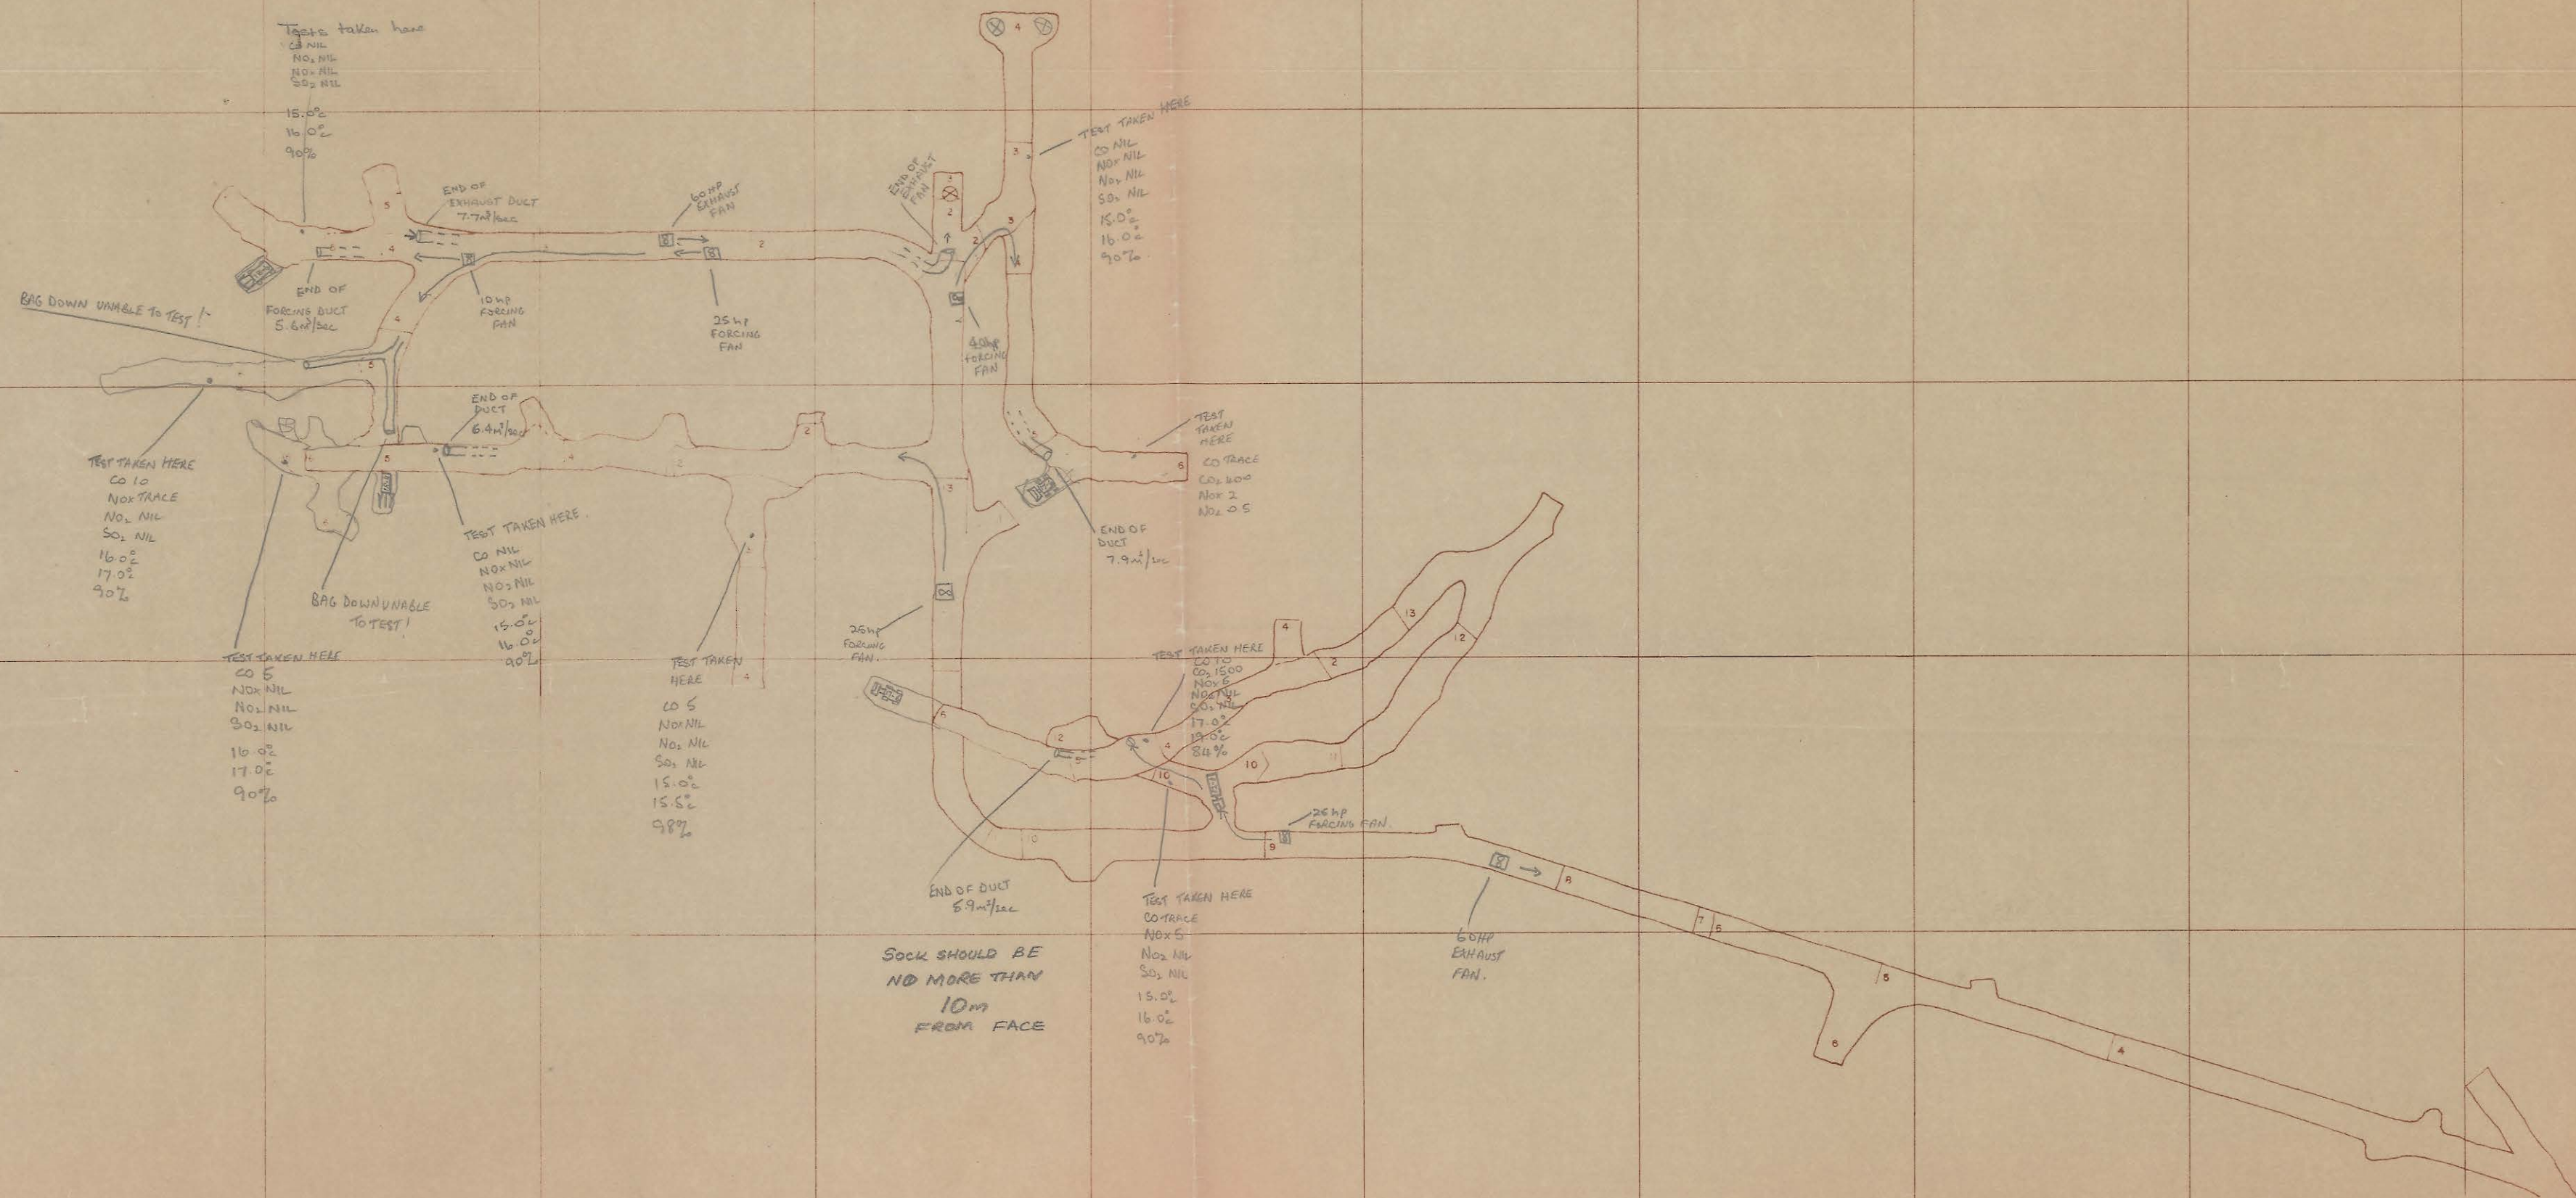

	KING ISLAND SCHEELITE	
	SCALE 1:1000	No 1-5-75
	BOLD HEAD MINE PERIOD REPORT PLAN PERIOD end to	