

0374_3040

5 cm

NUMBER 1(cont)

Plugs Located on
-75 m Level

INSTALLATION DETAILS:

PILLAR W 2775
LIFT 4
R.L. 116.38
BEARING 113°
DATE 6-4-77


CALIBRATION 0.001 volts = 0.03 mm

ROD LENGTHS

NUMBER	LENGTH
1	2.7m
2	2.7m
3	5.5m

TRANSVERSE
MONITORING
UNIT

DIAGRAM

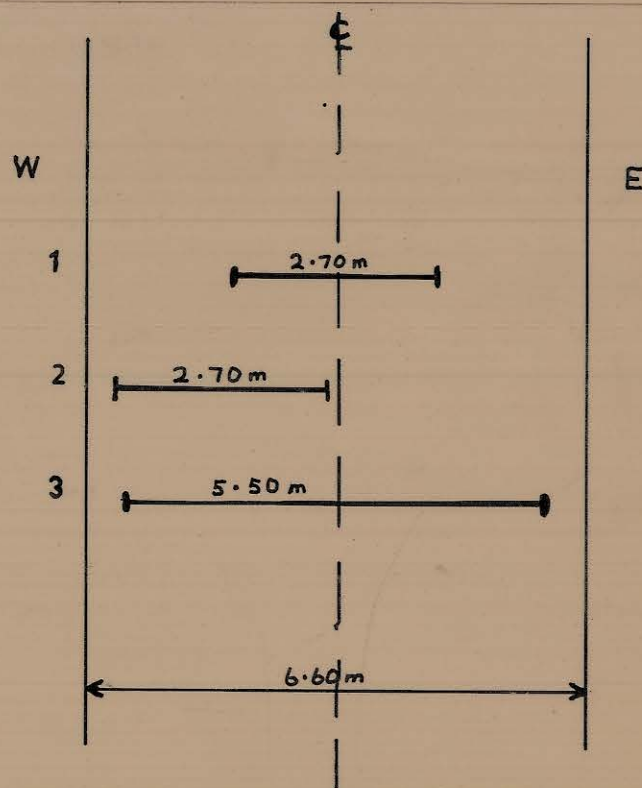

READINGS

0.919 0 -4.47 0.805 0 -7.47

DATE		ROD 1			ROD 2			ROD 3			ROD		
		V	ΔV	Δmm	V	ΔV	Δmm	V	ΔV	Δmm			
6-9-78	1912	0.905	-0.014	-4.89	0.795	-0.010	-7.77						
9-9-78	1915	0.906	-0.013	-4.86	0.797	-0.008	-7.71						
19-9-78	1925	0.902	-0.017	-4.98	0.793	-0.012	-7.83						
26-9-78	1932	0.900	-0.019	-5.04	0.792	-0.013	-7.86						
10-10-78	1945	0.898	-0.021	-5.10	0.792	-0.013	-7.86						
3-11-78	1970	0.895	-0.024	-5.19	0.790	-0.015	-7.92						
16-11-78	1983	0.893	-0.026	-5.25	0.788	-0.017	-7.98						
29-11-78	1996	0.893	-0.024	-5.19	0.784	-0.021	-8.10						
20-12-78	2017	0.883	-0.036	-5.55	0.778	-0.027	-8.28						
3-1-79	2031	0.880	-0.039	-5.64	0.776	-0.029	-8.34						
12-1-79	2040	0.879	-0.040	-5.67	0.776	-0.029	-8.34						
30-1-79	2058	0.879	-0.040	-5.67	0.773	-0.032	-8.42						
30-5-79	2178	0.845	-0.074	-6.69	0.746	-0.059	-9.24						
14-6-79	2193	0.842	-0.077	-6.78	0.744	-0.061	-9.30						
27-6-79	2206	0.837	-0.082	-6.93	0.745	-0.060	-9.27						
6-9-79	2277	0.833	-0.086	-7.05	0.741	-0.064	-9.39						
26-9-79	2297	0.842	-0.077	-6.78	0.749	-0.056	-9.15						
8-11-79	2340	0.832	-0.087	-7.08	0.742	-0.063	-9.36						
29-11-79	2361	0.830	-0.089	-7.14	0.742	-0.063	-9.36						
27-12-79	2389	0.827	-0.092	-7.23	0.738	-0.067	-9.48						
4-6-80	2549	0.812	-0.107	-7.68	0.717	-0.088	-10.11						
22/7/80	2598	0.798	-0.121	-8.10	0.704	-0.101	-10.50						
25/7/80	2601	0.788	-0.131	-8.40	0.693	-0.112	-10.83						
28/7/80	2604	0.815	-0.090	-7.17	0.724	-0.081	-9.90						
5/8/80	2612	0.797	-0.122	-8.13	0.703	-0.102	-10.53						
12/8/80	2619	0.798	-0.121	-8.10	0.704	-0.101	-10.50						
19/8/80	2626	0.808	-0.111	-7.80	0.710	-0.095	-10.32						
26/8/80	2633	0.815	-0.104	-7.59	0.720	-0.085	-10.02						
3/9/80	2640	0.798	-0.121	-8.10	0.707	-0.098	-10.41						
28/10/80	2695	0.804	-0.115	-7.92	0.717	-0.088	-10.11						
12/11/80	2710	0.820	-0.099	-7.44	0.725	-0.080	-9.87						
1/12/80		0.792	-0.127	-8.28	0.692	-0.113	-10.86						