

0374\_3046

5 cm

NUMBER 3 (LOWER PIT)

INSTALLATION DETAILS:

PILLAR 34161  
 LIFT 2nd  
 R.L. -219.64  
 BEARING 315°  
 DATE 10.6.1980

CALIBRATION


2.3  
~~3.2~~ mm / Volt

ROD LENGTHS

NUMBER LENGTH

TRANSVERSE  
 MONITORING  
 UNIT

DIAGRAM

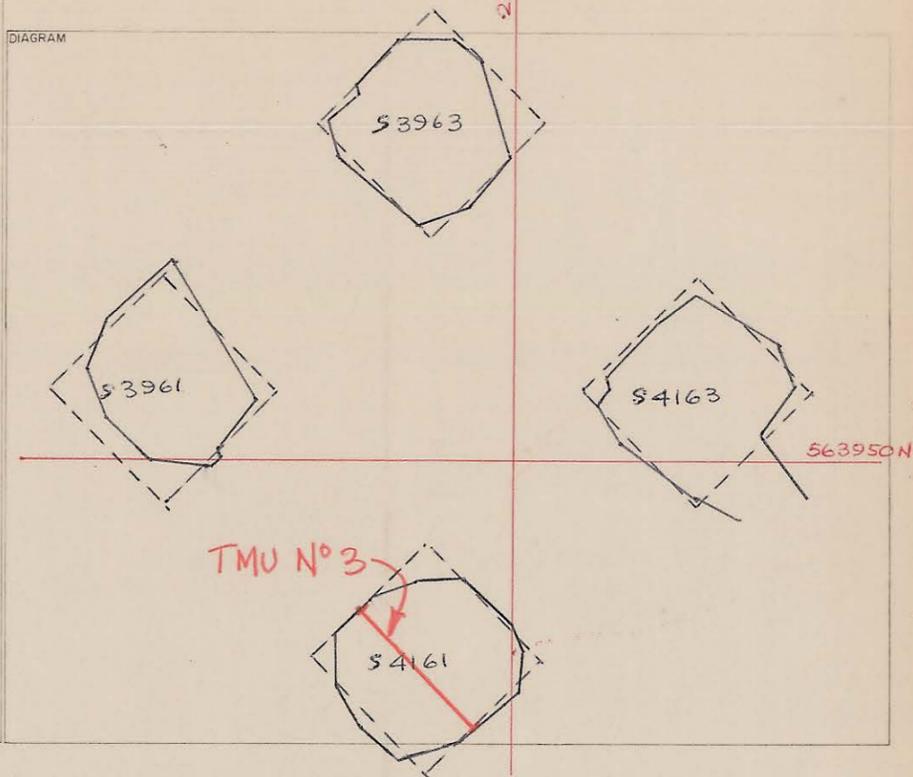

READINGS

DATE	ROD			DATE	ROD			DATE	TIME	ROD		
	V	ΔV	Δmm		V	ΔV	Δmm			V	ΔV	Δmm
15.7.80	1.994 ?			8.9.80 15:45	1.534	-0.055	+1.17	24.10.80	15:30	1.519	-0.070	+1.49
15.7.80	1.994 ?			9.9.80 16:00	1.533	-0.056	+1.19	27.10.80	15:30	1.519	-0.070	+1.49
16.7.80	1.589	0		10.9.80 15:45	1.533	-0.056	+1.19	28.10.80	09:00	1.518	-0.071	+1.51
17.7.80	1.593	+0.004	+0.09	11.9.80 16:00	1.532	-0.057	+1.21	29.10.80	13:45	1.517	-0.072	+1.53
18.7.80	1.589	0	0	12.9.80 16:15	1.532	-0.057	+1.21	30.10.80	13:00	1.519	-0.070	+1.49
21.7.80	1.579	-0.010	+0.21	15.4.80 15:15	1.531	-0.058	+1.24	31.10.80	10:00	1.519	-0.070	+1.49
22.7.80	1.576	-0.013	+0.28	16.9.80 15:45	1.530	-0.059	+1.26	4.11.80	13:05	1.517	-0.072	+1.53
23.7.80	1.575	-0.014	+0.30	17.9.80 16:15	1.528	-0.061	+1.30	6.11.80	10:15	1.516	-0.073	+1.56
24.7.80	1.574	-0.015	+0.32	18.9.80 16:25	1.527	-0.062	+1.32	10.11.80	09:30	1.516	-0.073	+1.56
25.7.80	1.570	-0.019	+0.40	19.9.80 16:00	1.527	-0.062	+1.32	12.11.80	07:45	1.516	-0.073	+1.56
28.7.80	1.569	-0.020	+0.43	22.9.80 16:00	1.525	-0.064	+1.36	13.11.80	11:00	1.518	-0.071	+1.51
29.7.80	1.569	-0.020	+0.43	23.9.80 15:45	1.525	-0.064	+1.36	14.11.80	10:30	1.514	-0.075	+1.60
4.8.80	1.568	-0.021	+0.45	24.9.80 15:45	1.525	-0.064	+1.36	25.11.80	09:00	1.514	-0.075	+1.60
5.8.80	1.567	-0.022	+0.47	25.9.80 16:00	1.525	-0.064	+1.36	28.11.80	14:00	0.479	-0.087	+1.85
6.8.80	1.567	-0.022	+0.47	26.9.80 15:45	1.524	-0.065	+1.38	1.12.80	10:15	0.479	-0.087	1.85
11.8.80	1.539	-0.050	+1.07	29.9.80 16:00	1.522	-0.067	+1.43	3.12.80	08:45	0.479	-0.087	1.85
12.8.80	1.539	-0.050	+1.07	30.9.80 16:45	1.523	-0.066	+1.41	4.12.80	09:00	0.479	-0.087	1.85
13.8.80	1.539	-0.050	+1.07	1.10.80 15:45	1.522	-0.067	+1.43	9.12.80	10:00	0.479	-0.087	1.85
14.8.80	1.540	-0.049	+1.074	2.10.80 14:45	1.522	-0.067	+1.43	16.12.80	09:30	0.483	-0.091	1.94
15.8.80	1.539	-0.050	+1.07	3.10.80 15:45	1.519	-0.070	+1.49	17.12.80	08:15	0.484	-0.092	1.96
18.8.80	1.538	-0.051	+1.09	6.10.80 15:30	1.509	-0.080	+1.70	18.12.80	08:45	0.493	-0.101	2.15
19.8.80	1.538	-0.051	+1.09	7.10.80 15:45	1.515	-0.074	+1.58	22.12.80	11:00	0.496	-0.104	2.22
20.8.80	1.538	-0.051	+1.09	8.10.80 16:00	1.521	-0.068	+1.45	24.12.80	08:30	0.498	-0.106	2.26
21.8.80	1.538	-0.051	+1.09	9.10.80 15:45	1.521	-0.068	+1.45	29.12.80	10:50	0.497	-0.105	2.24
22.8.80	1.538	-0.051	+1.09	10.10.80 15:30	1.521	-0.068	+1.45	2.1.81	13:30	0.498	-0.106	2.26
25.8.80	1.538	-0.051	+1.09	13.10.80 11:00	1.521	-0.068	+1.45	6.1.81	08:45	0.498	-0.106	2.26
26.8.80	1.538	-0.051	+1.09	15.10.80 15:45	1.521	-0.068	+1.45	7.1.81	08:15	0.498	-0.106	2.26
27.8.80	1.537	-0.052	+1.11	16.10.80 11:00	1.521	-0.068	+1.45	12.1.81	09:15	0.498	-0.106	2.26
28.8.80	1.536	-0.053	+1.13	17.10.80 16:00	1.520	-0.069	+1.47	14.1.81	10:15	0.498	-0.106	2.26
24.8.80	1.536	-0.053	+1.13	20.10.80 15:45	1.520	-0.069	+1.47	19.1.81	13:00	0.499	-0.107	2.28
1.9.80	1.535	-0.054	+1.15	21.10.80 16:00	1.518	-0.071	+1.51	21.1.81	09:00	0.504	-0.112	2.39
3.9.80	1.533	-0.056	+1.19	22.10.80 15:45	1.518	-0.071	+1.51	27.1.81	13:30	0.513	-0.121	2.58
4.9.80	1.533	-0.056	+1.19	23.10.80 15:45	1.519	-0.070	+1.49	30.1.81	09:45	0.513	-0.121	2.58