

0374_3049

5 cm

NUMBER 3

Located on
-150 m Level.

INSTALLATION DETAILS:


PILLAR C.1965
LIFT 2
R.L. 140.80
BEARING 13°
DATE 14-11-77

CALIBRATION 0.001 volts = 0.04 m.m.

ROD LENGTHS

NUMBER	LENGTH
1	4.08 m
2	2.26 m
3	2.25 m

TRANSVERSE
MONITORING
UNIT

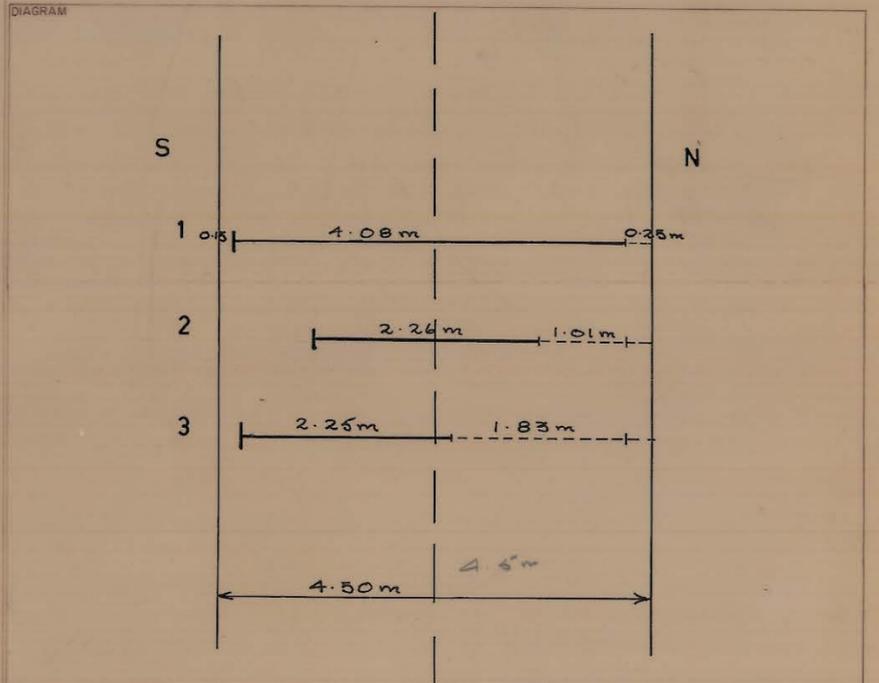

READINGS

DATE	ROD 1 V	ΔV	Δmm	ROD 2 V	ΔV	Δmm	ROD 3 V	ΔV	Δmm	ROD	
											Notes
22-11-77	1624	2.018	0	0	1.816	0	0	1.839	0	0	TRU FULLY EXTENDED 0.0V
19-1-78	1682	2.067	0.049	1.96	1.826	0.010	0.40	1.827	-0.012	-0.48	" " IN 2.0V
23-1-78	1686	2.083	0.065	2.60	1.833	0.017	0.68	1.890	0.051	2.040	PLUGS DAMP?
11-4-78	1764	1.861	-0.157	-6.28	1.829	0.013	0.52	1.712	-0.127	-5.08	"
17-4-78	1770	1.855	-0.163	-6.52	1.798	-0.018	-0.72	1.721	-0.118	-4.72	Before Extending
19-4-78	1772	1.854	-0.164	-6.56	1.795	-0.021	-0.84	1.719	-0.120	-4.80	AFTER EXTENDING
9-5-78	1792	1.772	-0.246	-9.84	1.797	-0.019	-0.76	1.790	-0.049	-1.96	PLUGS DAMP?
10-5-78	1793	1.770	-0.248	-9.92	1.797	-0.019	-0.76	1.796	-0.043	-1.72	"
22-5-78	1805	1.804	-0.214	-8.56	1.730	-0.086	-3.44	1.804	-0.035	-1.40	
4-7-78	1848	1.744	-0.274	-10.96	1.820	+0.004	+0.16	1.818	-0.021	-0.84	Last reading old meter
6-6-78	1820	1.716	0	-11.20	1.790	0	-0.16	1.788	0	-1.00	New Panel Meter Datum
4-7-78	1848	1.722	+0.006	-10.96	1.798	+0.008	+0.16	1.792	+0.004	-0.84	↓
13-7-78	1857	1.746	+0.030	-10.00	1.799	+0.009	+0.20	1.775	-0.013	-0.52	
25-8-78	1900	1.716	0	-11.20	1.815	+0.025	+0.84	1.845	+0.057	+1.28	Nº3 DAMP?
7-9-78	1913	1.716	0	-11.20	1.817	+0.027	+0.92	1.855	+0.077	+2.08	Nº3 WET VERY UNSTEADY
19-9-78	1917	1.722	+0.006	-10.96	1.830	+0.040	+1.44	-	-	-	Nº2+3 WET Nº3 NO GOOD
26-9-78	1932	~1.712	-0.004	-11.36	1.827	+0.037	+1.32	~1.842	+0.054	+1.16	Nº1+3 WET
10-10-78	1945	1.744	+0.028	-10.08	1.825	+0.035	+1.24	1.825	+0.037	+0.48	Plug 3 wet all drifting
3-11-78	1970	-	-	-	-	-	-	-	-	-	Water in System
16-11-78	1983	-	-	-	-	-	-	-	-	-	Water in System - R/S
20-12-78	2017	-	-	-	-	-	-	-	-	-	Still wet but possible future readings
30-5-79	2178	2.05			2.15			1.90			All readings v. doubtful
14-6-79	2193	1.791	+0.075	-8.20	2.100	+0.310	+12.24	1.910	+0.122	+3.88	Variation in readings ± 0.01
28-6-79	2207	1.720	+0.004	-11.04				1.940	+0.152	+5.08	some variation
3-8-79	2243	1.745	+0.029	-10.04	2.600	+0.810	+32.24	2.050	+0.262	+9.48	2+3 unstable.
6-9-79	2277	1.720	+0.004	-11.04	1.290	-0.500	-20.16				2+3 very wet
28-11-79	2360										
7/7/80		2.166	+0.450	-26.80	1.505	-0.285	-11.56	2.127	+0.339	+12.56	wet.
18/7/80		1.375	-0.341	-24.84	1.410	-0.380	-15.36	1.983	+0.195	+6.80	"
22/7/80		1.910	+0.194	-3.44	2.190	+0.480	+15.84	1.888	+0.100	+3.00	"
28/7		1392			2.401			1.914			} see next sheet.
5/8		1720			2.560			1.877			