

TRANSVERSE MONITORING UNIT

NUMBER ↑ (LOWER PIT)

INSTALLATION DETAILS:

PILLAR S 4163
 LIFT 2nd
 R.L. -219.95
 BEARING 45°
 DATE 12-6-1980


CALIBRATION

2.0 mm/Volt

ROD LENGTHS

NUMBER LENGTH

DIAGRAM

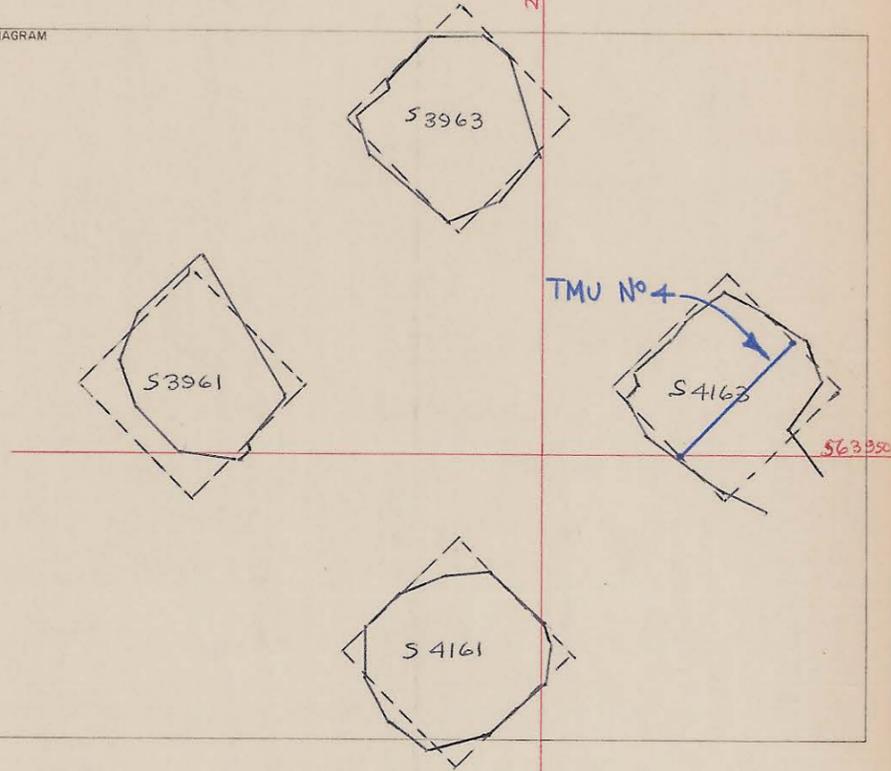

READINGS

DATE	ROD			DATE	ROD			DATE	TIME	ROD		
	V	ΔV	Δmm		V	ΔV	Δmm			V	ΔV	Δmm
15-7-80	1.838 ?			8-9-80 ^{15:45}	1.252	-0.166	-3.49	24-10-80	15:30	1.261 ⁷⁹	-0.157	-3.30
15-7-80	1.843 ?			9-9-80 ^{16:00}	1.253	-0.165	-3.47	27-10-80	15:30	? 0.46		
16-7-80	1.418 ⁹	0		10-9-80 ^{15:45}	1.253	-0.165	-3.47	28-10-80	09:00	? 0.46		
17-7-80	1.436 ¹⁰	+0.018	+0.38	11-9-80 ^{16:00}	1.253	-0.165	-3.47	29-10-80	13:45	0.291 ?		
18-7-80	1.464	+0.046	+0.97	12-9-80 ^{16:15}	1.253	-0.165	-3.47	30-10-80	1300	1.449	+0.031?	
21-7-80	1.452	+0.034	+0.71	15-9-80 ^{15:45}	1.252	-0.166	-3.49	31-10-80	10:00	1.396	-0.022	-0.46
22-7-80	1.430	+0.012	+0.25	16-9-80 ^{15:45}	1.253	-0.165	-3.47	4-11-80	13:05	1.414	-0.004	-0.084
23-7-80	1.429	+0.011	+0.23	17-9-80 ^{16:15}	1.253	-0.165	-3.47	6-11-80	10:15	1.492	+0.074	+1.55
24-7-80	1.436	+0.018	+0.38	18-9-80 ^{13:45}	1.253	-0.165	-3.47	10-11-80	09:30	1.362	-0.056	-1.18
25-7-80	1.405	-0.013	-0.27	19-9-80 ^{16:00}	1.254	-0.164	-3.44	12-11-80	07:45	1.157 ⁸⁰	-0.261	-5.48
28-7-80	1.408	-0.010	-0.21	22-9-80 ^{16:00}	1.254	-0.164	-3.44	13-11-80	11:00	1.158 ⁸¹	-0.260	-5.46
29-7-80	1.417 ¹⁸	-0.001	-0.02	23-9-80 ^{15:45}	1.255	-0.163	-3.42	19-11-80	10:30	0.667?	-0.751	-15.77?
4-8-80	1.417 ²²	-0.001	-0.02	24-9-80 ^{15:45}	1.257	-0.161	-3.38	25-11-80	09:00	0.835?	-0.583	-12.24?
5-8-80	1.379	-0.039	-0.82	25-9-80 ^{16:00}	1.258	-0.160	-3.36	26-11-80	08:30	open circuit		
6-8-80	1.361 ²⁴	-0.057	-1.20	26-9-80 ^{15:45}	1.258	-0.160	-3.36	1-12-80 ^{16:00}	10:15	"		
11-8-80	1.352 ²⁷	-0.066	-1.39	29-9-80 ^{15:40}	1.257	-0.161	-3.38	3-12-80 ^{16:00}		"		
12-8-80	1.375	-0.043	-0.90	30-9-80 ^{10:45}	1.257	-0.161	-3.38	17-12-80 ^{14:48}		0.056		
13-8-80	1.299	-0.119	-2.50	1-10-80 ^{15:45}	1.259	-0.159	-3.34	14-4-81		1.251		
14-8-80	1.290	-0.128	-2.69	2-10-80 ^{14:15}	1.261	-0.157	-3.30	30-4-81		1.060		
15-8-80	1.249	-0.169	-3.55	3-10-80 ^{15:45}	1.259	-0.159	-3.34	11-5-81		1.145 ²⁵ 147		
18-8-80	1.312	-0.106	-2.23	6-10-80 ^{15:30}	1.256	-0.162	-3.40			1.062 149?		
19-8-80	1.314	-0.104	-2.18	7-10-80 ^{15:35}	1.262	-0.156	-3.28	3-6-81		1.275		
20-8-80	1.307	-0.111	-2.33	8-10-80 ^{16:00}	1.265	-0.153	-3.21	29-6-81		1.521		
21-8-80	1.295	-0.123	-2.58	9-10-80 ^{15:45}	1.265	-0.153	-3.21	13-7-81		0.154	1.264	26.544
22-8-80	1.289	-0.129	-2.71	10-10-80 ^{15:30}	1.264	-0.154	-3.23	23-7-81		0.6034		
23-8-80	1.281	-0.137	-2.88	13-10-80 ^{11:00}	1.265	-0.153	-3.21					
26-8-80	1.283	-0.135	-2.84	15-10-80 ^{15:45}	1.264	-0.154	-3.23					
27-8-80	1.272	-0.146	-3.07	16-10-80 ^{11:00}	1.265	-0.153	-3.21					
28-8-80	1.271	-0.147	-3.09	17-10-80 ^{16:00}	1.264	-0.154	-3.23					
29-8-80	1.253	-0.165	-3.47	20-10-80 ^{15:45}	1.263	-0.155	-3.26					
1-9-80	1.251	-0.167	-3.51	21-10-80 ^{16:00}	1.261	-0.157	-3.30					
3-9-80	1.252	-0.166	-3.49	22-10-80 ^{15:45}	1.262	-0.156	-3.28					
4-9-80	1.251	-0.167	-3.51	23-10-80 ^{15:45}	1.260 ⁷⁸	-0.158	-3.32					