

Located in Central slope

NUMBER 4

INSTALLATION DETAILS:

PILLAR C 1567
 LIFT 8
 R.L. ~117
 BEARING dip ~11°
 DATE 07 02 80

CALIBRATION


0.001 = 0.05

ROD LENGTHS

NUMBER	LENGTH
1	2.15 m
2	2.15 m

TRANSVERSE
MONITORING
UNIT

DIAGRAM

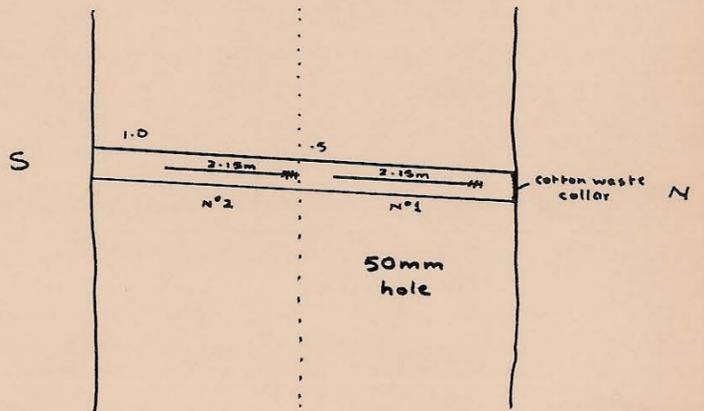

READINGS

DATE	v	ROD 1			ROD 2			ROD	ROD
		v	AV	Δmm	v	AV	Δmm		
4-2-80	surface initial	1.562	-	-	1.330	-	-		
7-2-80	1.45	1.623	0		1.354	0			
7-2-80	4.05	1.624	+0.001	+0.05	1.353	-0.001	-0.05		
7-2-80	4.30	1.625	+0.002	+0.10	1.353	-0.001	-0.05		
8-2-80	10.50	1.627	+0.004	+0.20	1.351	-0.003	-0.15		
9-2-80	3.30	1.628	+0.005	+0.25	1.342	-0.012	-0.60		
11-2-80	2.30	1.635	+0.012	+0.60	1.337	-0.017	-0.85		
14-2-80	10.30	1.638	+0.015	+0.75	1.334	-0.020	-1.00		
21-2-80	1.30	1.644	+0.021	+1.05	1.322	-0.032	-1.60		
26-2-80	10.30	1.646	+0.023	+1.15	1.312	-0.042	-2.10		
13-3-80	8.30	1.642	+0.019	+0.95	1.282	-0.072	-3.60		
13-3-80	2.00	1.642	+0.019	+0.95	1.281	-0.073	-3.65		
14-3-80	10.00	1.627	+0.004	+0.20	1.279	-0.075	-3.75		
17-3-80	3.00	1.628	+0.005	+0.25	1.277	-0.077	-3.85		
21-3-80	4.00	1.627	+0.004	+0.20	1.273	-0.081	-4.05		
6-5-80	2.00	1.602	-0.021	-1.05	1.150	-0.204	-10.20		
16-5-80	2.30	1.595	-0.028	-1.40	1.133	-0.221	-11.05		
21-5-80	2.00	1.583	-0.040	-2.00	1.119	-0.235	-11.75		
28-5-80	2.00	1.629	+0.006	+0.30	1.082	-0.272	-13.60		