


CALIBRATION T.M.U. 4 N° 142
- installed in pillar 1567 on 7/2/80



T.M.U. 4 N°1
T.M.U. 4 N°2

GAF A4 2mm.

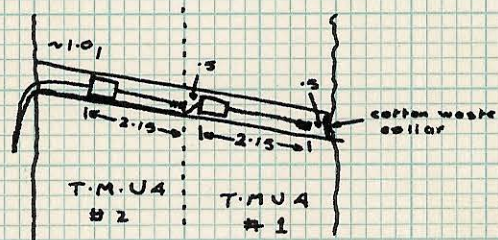