


# EARTH PRESSURE CELL

INSTALLATION N° 32  
 DATE 8.6.1980  
 ID small CSIRO  
 UNIT N° 0998  
 CABLE LENGTH = 30m  
 ZERO STRESS READING -9340  $\mu\epsilon$   
 SENSITIVITY ~~= 1.20~~  $\mu\epsilon$  / kPa  
 INITIAL STRESS \_\_\_\_\_  
 ORIENTATION HORIZONTAL

LOCATION 2nd Lift Lower Pit

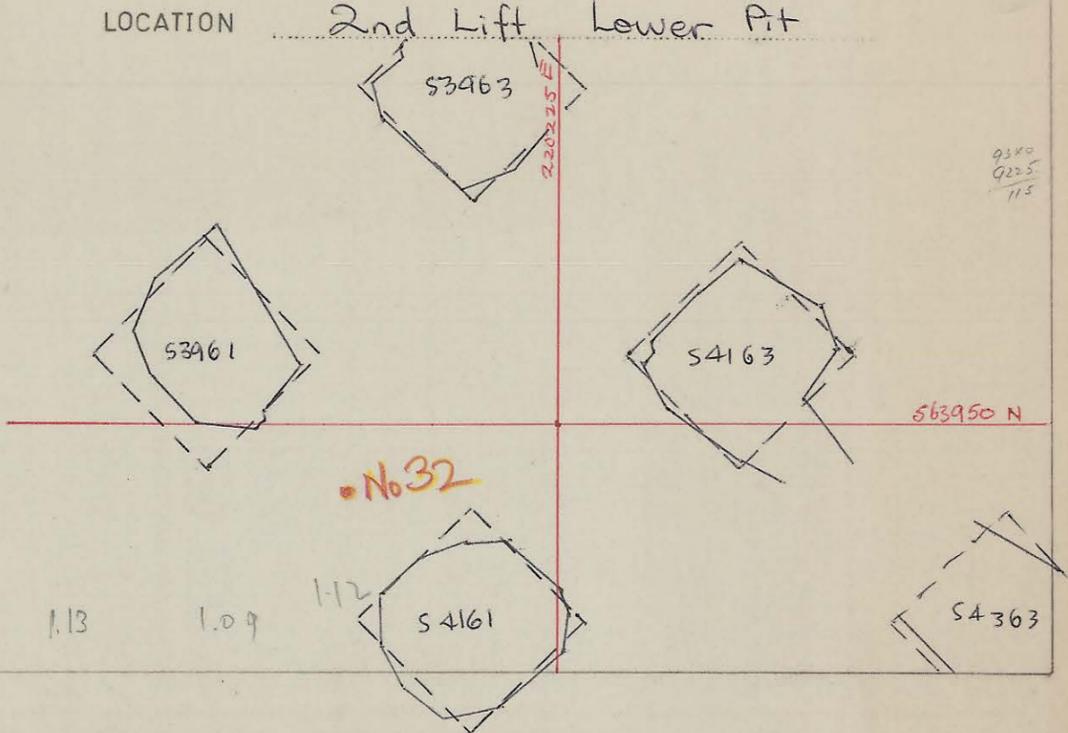

Date	Day	Reading $\mu\epsilon$	$\Delta$ Stress kPa	Stress kPa	Remarks	Date	Day	Reading $\mu\epsilon$	$\Delta$ Stress kPa	Stress kPa	Remarks
25.6.1980		-9340	1		Filling of S4062 commenced.	26.8.80	63 15:20	-9240		89.6	
7.7.1980						27.8.80	64 15:30	-9250		79.3	
8.7.1980	A				2nd Lift Filled	28.8.80	65 15:35	-9250	40	79.3	
9.7.1980	15	-9305	4	34.0		29.8.80	66 13:50	-9280		55.2	
10.7.1980	16	-9300	5	31.9		1.9.80	69 15:45	-9245		82.7	
11.7.1980	17	-9290	6	44.8		2.9.80	70 15:45	-9225		100.0	( <del>92.5</del> )
14.7.1980	20	-9295	7	41.4	Further filling in 2nd Lift.	4.9.80	72 15:30	-9235		93.1	
15.7.1980	21	-9265	8	65.5		5.9.80	73 11:00	-9230		96.5	
15.7.1980	21	-9235	8	93.6	Readout access point changed from mounting strip to ampere plug	8.9.80	76 15:45	-9235		93.1	
16.7.1980	22	+9200	9	120.7		9.9.80	77 16:00	-9240		89.6	
17.7.1980	23	+9230		96.5	S4062 has been mined.	10.9.80	78 15:45	-9240		89.6	
18.7.1980	24	+9245		82.7	Jumbo operating in S4062.	11.9.80	79 16:00	-9260		72.4	
21.7.1980	27	+9260		72.4	S4161 - 4363 MINED	12.9.80	80 16:15	-9245	50	82.7	
22.7.1980	28	+9275		58.6		15.9.80	83 15:15	-9240		89.6	
23.7.1980	29	+9270	14	62.0	S4161 - 3461 MINED	16.9.80	84 15:45	-9240		89.6	
24.7.1980	30	+9265		65.5		17.9.80	85 16:15	-9235		93.1	
25.7.1980	31	+9250		79.3	Room S4060 mined	18.9.80	86 13:45	-9235		93.1	
28.7.1980	34	+9285		49.8		19.9.80	87 16:00	-9230		96.5	
29.7.1980	35	+9280		55.2		22.9.80	90 16:00	-9235		93.1	
30.7.1980	36	-9280		55.2	S+ and S- swapped	23.9.80	91 15:45	-9240		89.6	
31.7.1980	37	-9280	20	55.2		24.9.80	92 15:45	-9240		89.6	
4.8.80	41	-9295	22	41.4		25.9.80	93 16:00	-9235?		93.1	
5.8.80	42	-9280		55.2		26.9.80	94 15:45	-9230	60	96.5	
6.8.80	43	-9280		55.2		29.9.80	97 15:40	-9225		100.0	
7.8.80	44	-9275		58.6		30.9.80	98 10:45	-9280?		55.2	
8.8.80	45	-9280		55.2		1.10.80	99 15:45	-9255		75.8	
11.8.80	48	-9280		55.2		2.10.80	100 14:15	-9225		100.0	
12.8.80	49	-9275		58.6		3.10.80	101 15:45	-9240		89.6	
13.8.80	50	-9270		62.0		6.10.80	104 15:30	-9235		93.1	
14.8.80	51	-9250	30	79.3		7.10.80	105 15:45	-9230		93.1	?
15.8.80	52	-9235		93.1		8.10.80	106 16:00	+9650		?	?
18.8.80	55	-9240		89.6		9.10.80	107 15:45	-9265		65.5	?
19.8.80	56	-9240		89.6		10.10.80	108 15:30	-9290	70	42.4.8	?
20.8.80	57	-9250		79.3		13.10.80	111 11:00	-9270		62.0	
21.8.80	58	-9240		89.6		15.10.80	113 15:45	-9285		49.8	
22.8.80	59	-9250		79.3		16.10.80	114 11:00	-9260		72.4	
25.8.80	62	-9240	37	89.6		17.10.80	115 16:00	-9295		41.4	
						20.10.80	118 15:45	-9285	75	49.8	