


EARTH PRESSURE CELL

INSTALLATION N° 33
 DATE 8.6.1980
 ID small CSIRO.
 UNIT N° 0989
 CABLE LENGTH ≈ 30m
 ZERO STRESS READING +2375 μE
 SENSITIVITY ≈ 1.22 μE/kPa.
 INITIAL STRESS _____
 ORIENTATION HORIZONTAL

LOCATION 2nd Lift Lower Pit

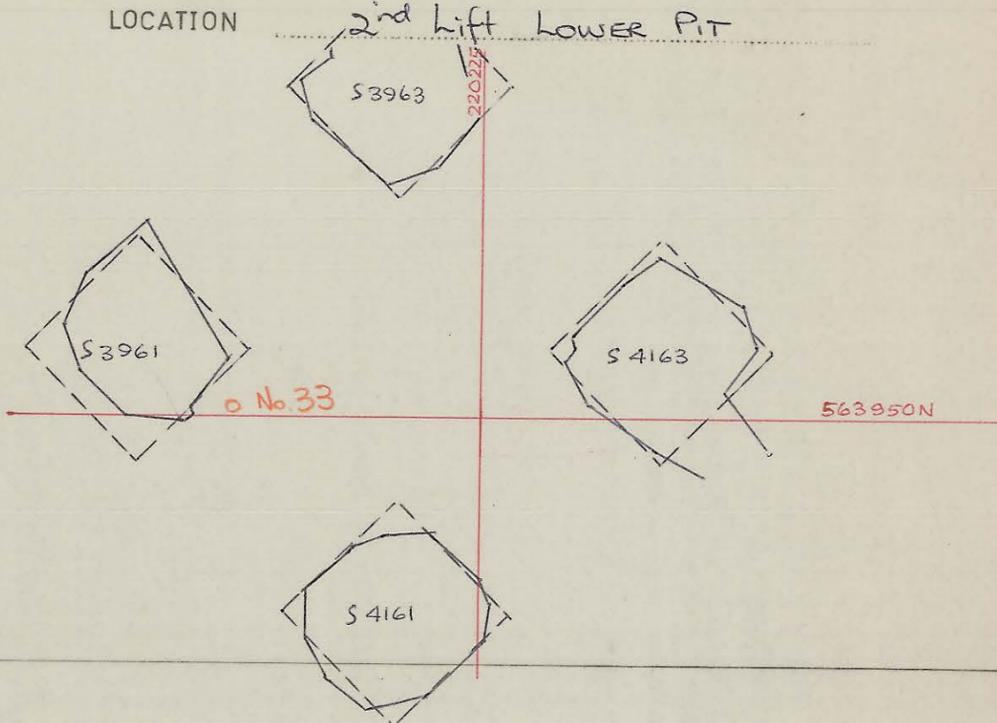

Date	Day	Reading μE	Δ Stress kPa	Stress kPa	Remarks	Date	Day	Reading μE	Δ Stress kPa	Stress kPa	Remarks
25.6.1980		2375	0		Filling of S4062 commenced	25.8.80	62 15:50	+2430		51.7	
7.7.1980		850 (250.52)				26.8.80	63 15:20	+2430		51.7	
8.7.1980					2nd Lift Filled	27.8.80	64 15:30	+2440		58.6	sh
9.7.1980	15	+2400		27.6		28.8.80	65 15:35	+2430	40	51.7	Strike at Dolphin
10.7.1980	16	+2410		34.5		29.8.80	66 13:50	+2430		51.7	
11.7.1980	17	+2410		34.5		1.9.80	69 15:45	+2430		51.7	
14.7.1980	20	+2430		51.7	Further Filling in 2nd Lift	3.9.80	70 15:45	+2435		55.2	
15.7.1980	21 14:00	+2425		44.8		4.9.80	72 15:30	+2430		51.7	
15.7.1980	21 20:00	+2430		51.7	Readout access point changed from mounting strap to amphenol plug	5.9.80	73 11:00	+2435		55.2	
16.7.1980	22	+2435		55.2		8.9.80	76 15:45	+2430		51.7	
17.7.1980	23 16:00	+2430		51.7	S4062 has been mined.	9.9.80	77 16:00	+2425		48.3	
18.7.1980	24 15:30	+2430		51.7	Jumbo operating in S4062	10.9.80	78 15:45	+2430		51.7	Strike finished.
21.7.1980	27 15:30	+2410	✓	34.5		11.9.80	79 16:00	+2430	60	51.7	
22.7.1980	28 16:00	+2420		44.8		12.9.80	80 16:15	+2430	50	51.7	
23.7.1980	29 16:00	+2420		44.8		15.9.80	83 15:15	+2425		48.3	
24.7.1980	30 15:45	+2420		44.8		16.9.80	84 15:45	+2430		51.7	
25.7.1980	31 16:00	+2420		44.8		17.9.80	85 16:15	+2430		51.7	
28.7.1980	34 15:30	+2415		41.4		18.9.80	86 13:45	+2430		51.7	
29.7.1980	35 16:00	+2410		34.5		19.9.80	87 16:00	+2435		55.2	
30.7.1980	36 15:30	+2415		41.4	S4 and S-leads swapped	22.9.80	90 16:00	+2425		48.3	
31.7.1980	37 16:00	+2425		48.3		23.9.80	91 15:45	+2430		51.7	
1.8.80	38 15:30	+2425		48.3		24.9.80	92 15:45	+2430		51.7	
4.8.80	41 16:15	+2420		44.8		25.9.80	93 16:00	+2430		51.7	
5.8.80	42 16:00	+2415		41.4		26.9.80	94 15:45	+2435	60	55.2	
6.8.80	43 15:45	+2415		41.4		29.9.80	97 15:40	+2435		55.2	
7.8.80	44 16:00	+2415		41.4		30.9.80	98 10:45	+2430		51.7	
8.8.80	45 16:00	+2420		44.8		1.10.80	99 15:45	+2435		55.2	
11.8.80	48	+2415		41.4		2.10.80	100 14:15	+2435		55.2	
12.8.80	49 16:00	+2425		48.3		3.10.80	101 15:45	+2430		51.7	
13.8.80	50 15:30	+2420		44.8		6.10.80	104 15:30	+2430		51.7	
14.8.80	51 15:30	+2435		55.2		7.10.80	105 15:45	+2465		79.3	?
15.8.80	52 16:00	+2435		55.2		8.10.80	106 16:00	+2365 2465?		<0	?
18.8.80	55 15:30	+2430		51.7		9.10.80	107 15:45	+2450		67.2	
19.8.80	56 16:00	+2435		55.2		10.10.80	108 15:30	+2425	70	48.3	←
20.8.80	57 15:30	+2440		58.6		13.10.80	111 11:00	+2415		41.4	
21.8.80	58 15:30	+2420		44.8		15.10.80	113 15:45	+2430		51.7	
22.8.80	59 13:30	+2410		34.5		16.10.80	114 11:00	+2425		48.3	
						17.10.80	115 16:00	+2425	74	48.3	