

0374_3074

5 cm

TAPE EXTENSOMETER

STATION No. **TES 1**

LOCATION -200mRL W64

TYPE **INTERFELS CONV. METER**

220323.0 EAST


DATE OF INSTALLATION **2 Nov 1981**

564019.0 NORTH

ANCHORAGE SYSTEM **FULLY GROUTED ✓**
 or
POINT ANCHORED

..... R.L.

..... **12°** BEARING

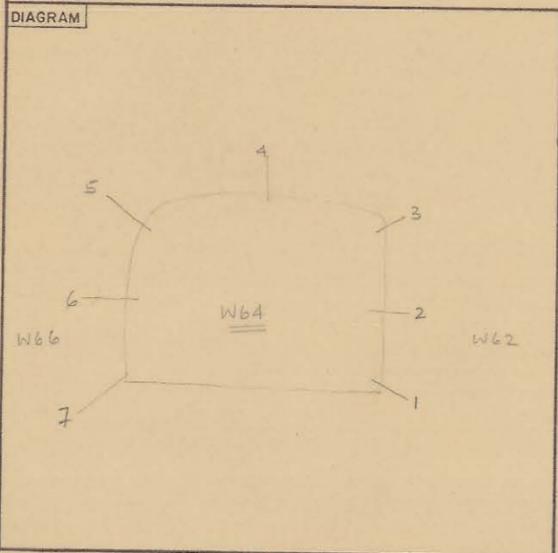

NOTE: * Base Data.

PINS

DATE	DAY	DISTANCE BETWEEN STATIONS IN METRES								CALIBRATION		REMARKS	
		1-7	1-6	1-5	1-4	7-1	7-2	7-3	7-4	AT START	AT END		
11.11.1981	(2-6)	* 3.28115	* 3.67401	* 3.69683	* 3.85497	* 2.61591	* 3.67377	* 3.60865	* 3.60753	* 2.75589	0.22702	0.22695	
9.12.81		3.30324	3.67396	3.6967	3.85504	2.61649	3.67392	3.6071	3.6071	2.75583	0.22697	0.22691	
13.1.82		3.30423	3.67404	3.69675	3.85540	2.61533	3.67401	3.65477	3.60733	2.75662	0.22700	0.22664	
21.1.82		3.28346	3.67423	3.69789	3.85598	2.61833	3.67420	3.63526	3.60844	2.75826	0.22791	0.22788	No2. bolt straightened 2-6 & 7-2 applied.
9-2-82		3.28342	3.67425	3.69780	3.85586	2.61712	3.67427	3.62421	3.60839	2.75702	0.22780	0.22783	
19-2-82		3.27189	3.67505	3.69755	3.85599	2.61745	3.67503	3.62491	3.60822	2.75598	0.22785	0.22782	
26-2-82		3.27236	3.67491	3.69766	3.85583	2.61800	3.67494	3.62570	3.60826	2.75799	0.22798	0.22769	
8-3-82		3.27226	3.67515	3.69755	3.85582	2.61780	3.67518	3.62501	3.60827	2.75601	0.22781	0.22779	
15-3-82		3.28278	3.67597	3.69701	3.85533	2.61678	3.67593	3.62427	3.60788	2.75656	0.22765	0.22760	(Tape has been cut off 0.1m).
22-3-82		3.28193	3.67498	3.69726	3.85566	2.61758	3.67493	3.62442	3.60826	2.75720	0.22751	0.22746	Dial gauge jumped up.
29-3-82		3.27435	3.67717	3.69964	3.85895	2.61956	3.67719	3.62739	3.61042	2.76099	0.23060	0.23061	Gauge was recalibrated.
5-4-82		3.27537	3.67872	3.70091	3.85947	2.62018	3.67877	3.62856	3.60144	2.75924	0.23040	0.23040	
15-4-82		3.27436	3.67751	3.69937	3.85812	2.61793	3.67746	3.62736	3.61017	2.75856	0.22987	0.22996	
20-4-82		3.27465	3.67692	3.69914	3.85775	2.61960	3.67697	3.62744	3.60967	2.75944	0.22880	0.22887	cut-off slot 220-220 was fixed on 14-4-82
26-4-82		3.27400	3.67552	3.69840	3.85762	2.61875	3.67537	3.62682	3.61009	2.75892	0.22986	0.22992	
3-5-82		3.27423	3.67731	3.69948	3.85820	2.61906	3.67736	3.62692	3.60992	2.75848	0.22972	0.22971	Slot blasting (240-220) completed on 27-4-82
10-5-82		3.27436	3.67700	3.69921	3.85816	2.61996	3.67706	3.62701	3.61011	2.75944	0.22986	0.22979	W62, Rings 3,4,5 were fixed on 3-5-82
17-6-82		3.27395	3.67572	3.69867	3.85769	2.61786	3.67642	3.62631	3.60984	2.75822	0.2288 ?	0.22968	
29-6-82		3.28395	3.67644	3.69877	3.85758	2.61910	3.67612	3.60958	3.60958	2.75958	0.22977	0.22970	6,7,8,9 fixed on 21/6
7-7-82		3.28353	3.67560	3.69851	3.85764	2.61886	3.67629	3.60960	3.60960	2.75840	0.22978	0.22971	10,11 fixed on 6/7
13-7-82		3.28367	3.67557	3.69837	3.85721	2.61930	3.67625	3.60972	3.60972	2.75883	0.22958	0.22956	
21-7-82		3.28390	3.67541	3.69831	3.85740	2.61860	3.67629	3.60932	3.60932	2.75910	0.22955	0.22955	
28-7-82		3.27337	3.67610	3.69854	3.85807	2.61856	3.67643	3.60983	3.60983	2.75734	0.22972	0.22971	
4-8-82		3.27367	3.67573	3.69837	3.85765	2.61858	3.67641	3.60951	3.60951	2.75807	0.22945	0.22945	
17-8-82		3.27406	3.67603	3.69845	3.85741	2.61936	3.67608	3.60967	3.60967	2.75891	0.22955	0.22955	