


PORE PRESSURE CELL

INSTALLATION N° 24
 DATE 8.6.1980
 TYPE KYOWA BP-2KC
 UNIT N° YE 3072
 CABLE LENGTH ≈ 30m
 ZERO STRESS READING -68 μE
 SENSITIVITY 1718 μE
 CALIBRATION CONSTANT 1164 kg/cm²
 ORIENTATION

LOCATION LOWER PIT STAGE, 2ND LIFT

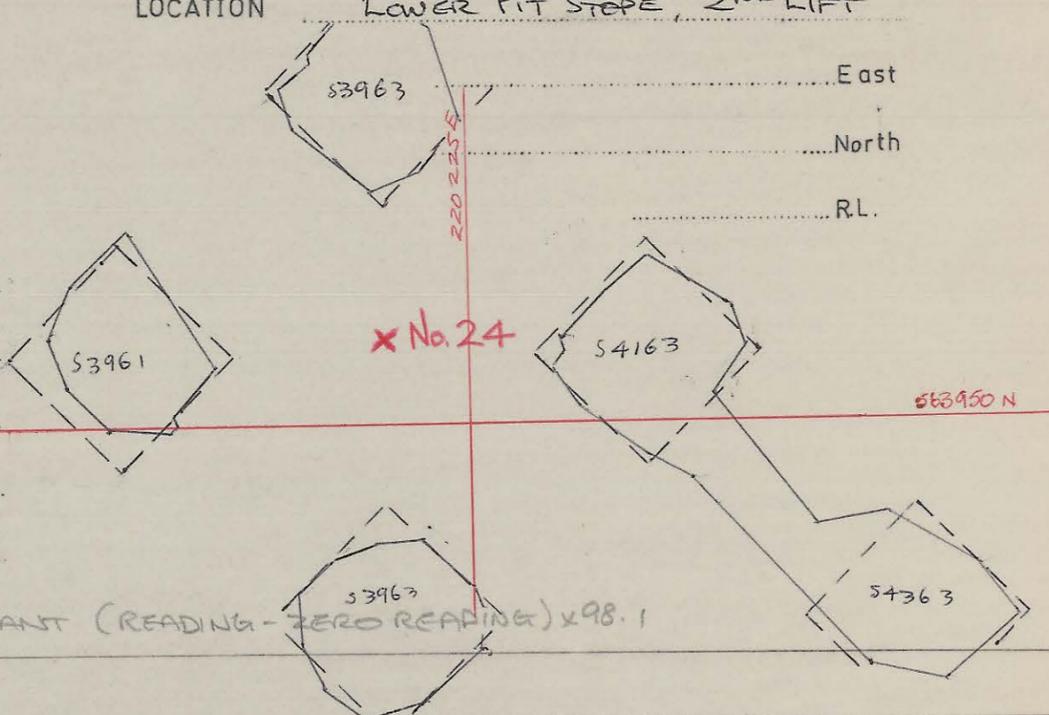

NOTE: PRESSURE [kPa] = CAL. CONSTANT (READING - ZERO READING) x 98.1

Date	Day	Reading μE	Δ Stress kPa	Stress kPa	Remarks	Date	Day	Reading μE	Δ Stress kPa	Stress kPa	Remarks
8.6.1980					Installation	25.8.80	62 15:50	-30		4.3	
25.6.1980	0	-68	1		Filling of S4062 commenced	26.8.80	63 15:20	-10		6.6	
7.7.1980	13	0	2	7.8	2nd lift Filled	27.8.80	64 15:30	-30		4.3	
8.7.1980	14	-5	3	7.2		28.8.80	65 15:35	-10	40	6.6	
9.7.1980	15	-5		7.2		29.8.80	66 13:50	-20		5.5	
10.7.1980	16	0		7.8		1.9.80	69 15:45	-30		4.3	
11.7.1980	17	-20		5.5		3.9.80	71 15:45	-20		5.5	
14.7.1980	20	-15		6.1	Further filling in 2nd lift	4.9.80	72 15:30	-40		3.2	
15.7.1980	21	-25	30	4.9	Readings new taken from original plug	5.9.80	73 11:00	-30		4.3	
15.7.1980	21	+35		3.8		8.9.80	76 15:45	-50		2.1	
16.7.1980	22	+35		3.8		9.9.80	77 16:00	-55		1.5	
17.7.1980	23	+45	10	2.6		10.9.80	78 15:45	-35		3.8	
18.7.1980	24	+35		3.8		11.9.80	79 16:00	-40		3.2	
21.7.1980	27 15:30	+45		2.8		12.9.80	80 16:15	-30	50	4.3	
22.7.1980	28 16:00	+25		4.9	Further filling in 2nd lift	15.9.80	83 15:15	-40		3.2	
23.7.1980	29 16:00	+25		4.9		16.9.80	84 15:45	-30		4.3	
24.7.1980	30 15:45	+25		4.9		17.9.80	85 16:15	-5		7.2	
25.7.1980	31 16:00	+25		4.9		18.9.80	86 13:15	+30		4.3	
28.7.1980	34 15:30	+50		2.1		19.9.80	87 16:00	-20		5.5	
29.7.1980	35 16:00	+40		3.2		22.9.80	90 16:00	-20		5.5	
30.7.1980	36 15:30	+30		4.3	S+ and S- swapped.	23.9.80	91 15:45	-10		6.6	
31.7.1980	37 16:00	+30	20	4.3		24.9.80	92 15:45	+5		7.2	
1.8.1980	38 15:30	+30		4.3		25.9.80	93 16:00	0		7.8	
4.8.80	41 16:15	+25		4.9		26.9.80	94 15:45	+15	60	9.5	Junction boxes wet from drainage pipe. Flow from drainage pipe. Large water flow from drainage pipe
5.8.80	42 16:00	+25		4.9		29.9.80	97 15:40	+20		10.0	
6.8.80	43 15:45	+30		4.3		30.9.80	98 10:45	+15		9.5	
7.8.80	44 16:00	+35		3.8		1.10.80	99 15:45	+45		12.9	
8.8.80	45 16:00	+25		4.9		2.10.80	100 14:45	+35		11.8	
11.8.80	48	+20		5.5		3.10.80	101 15:45	+55		11.8	
12.8.80	49 16:00	+5		7.2	Additional 1m of cable placed on S4062	6.10.80	104 15:30	+30		11.2	
13.8.80	50 15:30	+20		10.0		7.10.80	105 15:45	+40		12.3	
14.8.80	51 15:30	+15	30	9.5		8.10.80	106 16:00	+80		16.9	
15.8.80	52 16:00	+40		12.3		9.10.80	107 15:45	+30		4.3	
18.8.80	55 15:30	+15		9.5	S64 - 3rd lift filling commenced	10.10.80	108 15:30	+20	70	10.0	
19.8.80	56 16:00	+5		8.3		13.10.80	111 11:00	+10		8.9	
20.8.80	57 15:30	-10		6.6		15.10.80	113 15:45	+40		12.3	
21.8.80	58 15:30	-10		6.6		16.10.80	114 11:00	+30		11.2	
22.8.80	59 13:30	-10		6.6		17.10.80	115 16:00	+25	74	10.6	