

0374_3160

5 cm

INCLINOMETER RESULTS


NUMBERS 12, 12, 6, 10.

INSTALLATION DETAILS:

LOCATION Lower Pit
 LIFT 2nd
 R.L. -220.2
 DATE 25.6.1980
 SHEET # 2

CALIBRATION

1 Volt = 1° (linear)
over range 0 to ± 0.4V.

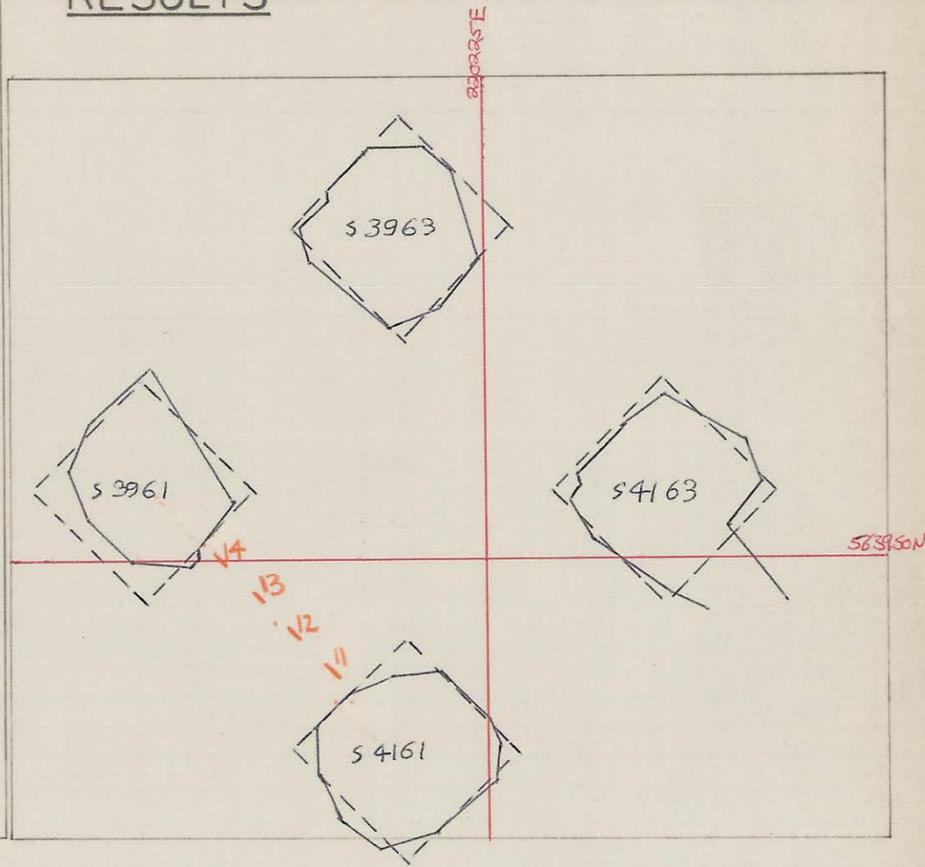

DATE	<u>12</u>			<u>6</u>			<u>10</u>		
	Reading	Δ Angle	Inclination	Reading	Δ Angle	Inclination	Reading	Δ Angle	Inclination
5-9-1980	0.00			0.839	(45)		0.493		
8-9-80	0			0.836			0.490		
9-9-80	0			0.837			0.492		
10-9-80	0			0.835			0.487		
11-9-80	0			0.836			0.483		
12-9-80	0			0.835			0.483		
15-9-80				0.835			0.478		
16-9-80				0.834			0.474		
17-9-80				0.832			0.468		
18-9-80				0.836			0.470		
19-9-80				0.832			0.459		
22-9-80				0.835			0.443		
23-9-80				0.832			0.436		
24-9-80				0.787			0.437		
25-9-80				0.801			0.433		
26-9-80				0.804			0.432		
29-9-80				0.809			0.427		
30-9-80	0.0022			0.809			0.426		
1-10-80	0.0014			0.806			0.423		
2-10-80	0.0011			0.805			0.426		
3-10-80	0.0015			0.809	(65)		0.423		
8-10-80	0.0006			0.700	(68)		0.424		
9-10-80	0.0010			0.725			0.424		
10-10-80	0.0008			0.728			0.423		
13-10-80	0.0008			0.730			0.422		
15-10-80	0.0006			0.705			0.414		
16-10-80	0.0004			0.714			0.413		
17-10-80	0.0008			0.726			0.413		
20-10-80	0.0006			0.651			0.409		
21-10-80	0.0005			0.665			0.407		
22-10-80	0.0005			0.711			0.402		
23-10-80	0.0004			0.700			0.395		
24-10-80	0.0004			0.692			0.390		
27-10-80	0.0004			0.688			0.381		
28-10-80	0.0003			0.641			0.378		
29-10-80	0.0002			0.655			0.379		
30-10-80	0.0003			0.649			0.370		
31-10-80	0.0003			0.635			0.357		
4-11-80	0.0005			0.930			0.355		
6-11-80	0.0006			0.927	(80)		0.352		

NOT CONNECTED