

NUMBERS ~~9, 8, 7~~ 9, 8, 7.


INSTALLATION DETAILS:

LOCATION Lower Pit
 LIFT 2ND
 R.L. -220.2
 DATE 25.6.1980
 SHEET #2

CALIBRATION

1 volt = 1°
 Linear other range
 0 to ± 0.4V.

INCLINOMETER RESULTS

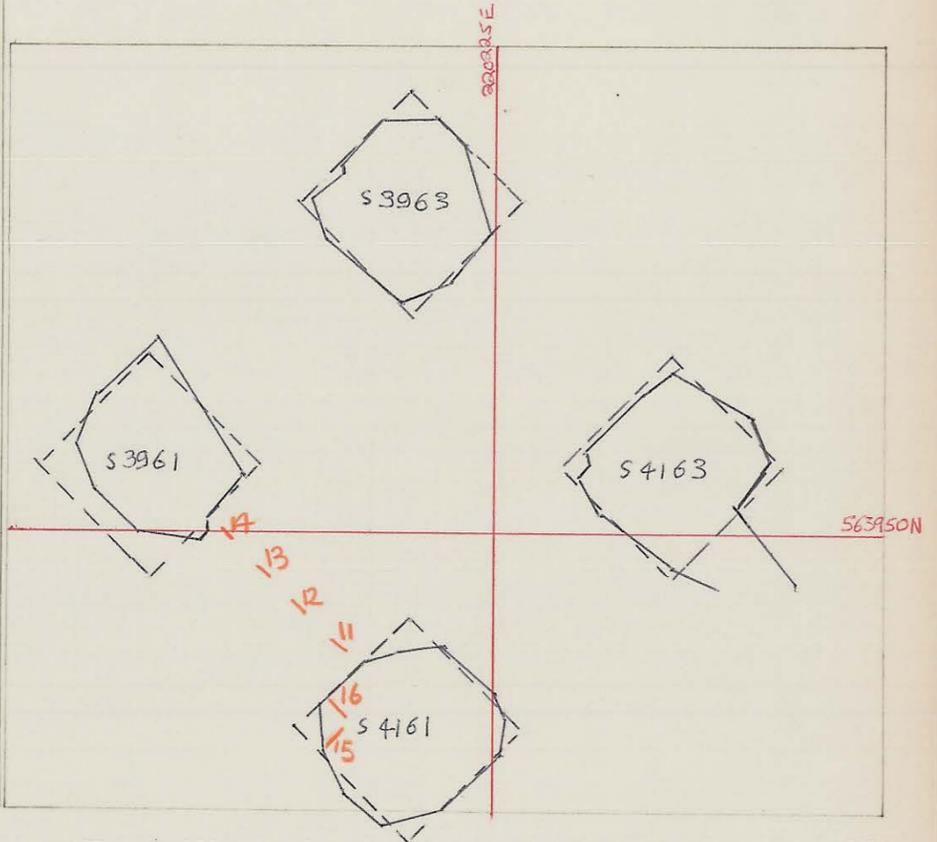

DATE	# 9			# 8			# 7		
	Reading	Δ Angle	Inclination	Reading	Δ Angle	Inclination	Reading	Δ Angle	Inclination
5.9.80	-0.398			0.860	(49)		0.258		
8.9.80	-0.397			0.858			0.254		
9.9.80	-0.398			0.858			0.256		
10.9.80	-0.397			0.857			0.253		
11.9.80	-0.397			0.858			0.256		
12.9.80	-0.398			0.856			0.255		
15.9.80	-0.397			0.857			0.256		
16.9.80	-0.398			0.855			0.256		
17.9.80	-0.397			0.854			0.256		
18.9.80	-0.398			0.857			0.261		
19.9.80	-0.397			0.854			0.258		
22.9.80	-0.398			0.857			0.261		
23.9.80	-0.397			0.853			0.257		
24.9.80	-0.397			0.806			0.261		
25.9.80	-0.397			0.821			0.262		
26.9.80	-0.398			0.824			0.260		
29.9.80	-0.396			0.830			0.254		
30.9.80	-0.396			0.829			0.254		
1.10.80	-0.396			0.825			0.258		
2.10.80	-0.397			0.823			0.261		
3.10.80	-0.396			0.828	(65)		0.261		
8.10.80	-0.396			0.717	(66)		0.260		
9.10.80	-0.396			0.743			0.259		
10.10.80	-0.397			0.746			0.258		
13.10.80	-0.397			0.749			0.262		
15.10.80	-0.396			0.723			0.261		
16.10.80	-0.395			0.734			0.261		
17.10.80	-0.397			0.745			0.262		
20.10.80	-0.396			0.672			0.266		
21.10.80	-0.396			0.685			0.261		
22.10.80	-0.396			0.731			0.260		
23.10.80	-0.396			0.722			0.261		
24.10.80	-0.396			0.713			0.260		
27.10.80	-0.395			0.709			0.260		
28.10.80	-0.394			0.663			0.253		
29.10.80	-0.396			0.674			0.258		
30.10.80	-0.396			0.668			0.256		
31.10.80	-0.395			0.655			0.255		
4.11.80	-0.397			0.972			0.256		
6.11.80	-0.397			0.978	(86)		0.258		