

NUMBERS 11, 5, 16, 8


INSTALLATION DETAILS:

LOCATION LOWER PIT  
 LIFT 2ND  
 R.L. -220.2  
 DATE 25.6.1980  
 SHEET #2

CALIBRATION

Linear over  
the range  
0 to 0.4V  
i.e. 1V = 10

INCLINOMETER  
RESULTS

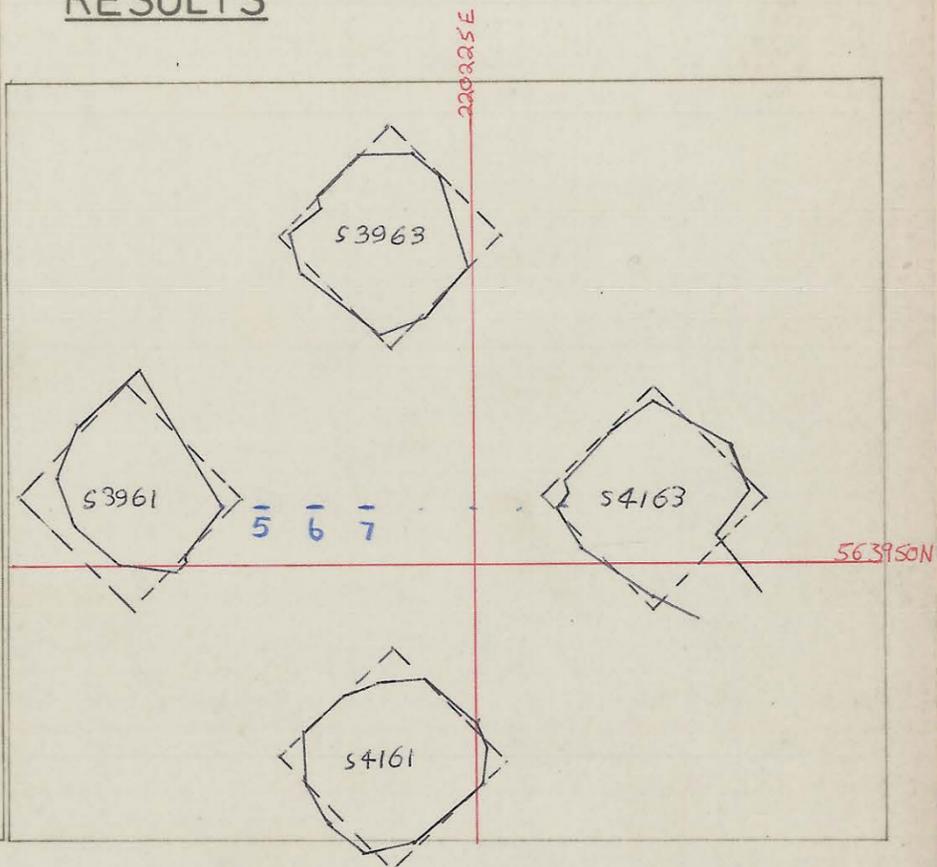

DATE	<u>11</u>			<u>5</u>			<u>16</u>		
	Reading (V)	$\Delta$ Angle	Inclination	Reading	$\Delta$ Angle	Inclination	Reading (V)	$\Delta$ Angle	Inclination
5.9.1980	0.0884			-0.420	(45)		-0.446		
8.9.80	0.0878			-0.404			-0.445		
9.9.80	0.0897			-0.404			-0.446		
10.9.80	0.0880			-0.404			-0.447		
11.9.80	0.0892			-0.404			-0.446		
12.9.80	0.0896			-0.403	(50)		-0.448		
15.9.80	0.0897			-0.404			-0.447		
16.9.80	0.0905			-0.404			-0.446		
17.9.80	0.0869			-0.404			-0.447		
18.9.80	0.0899			-0.404			-0.447		
19.9.80	0.0906			-0.404			-0.449		
22.9.80	0.0905			-0.404			-0.449		
23.9.80	0.0901			-0.403			-0.449		
24.9.80	0.0897			-0.403			-0.437		
25.9.80	0.0904			-0.403			-0.438		
26.9.80	0.0933			-0.403	(60)		-0.437		
29.9.80	0.0928			-0.403			-0.434		
30.9.80	0.0938			-0.403			-0.429		
1.10.80	0.0939			-0.403			-0.428		
2.10.80	0.0942			-0.403			-0.434		
3.10.80	0.0939			-0.403	(65)		-0.434		
8.10.80	0.0948			-0.403	(68)		-0.449		
9.10.80	0.0951			-0.403			-0.449		
10.10.80	0.0951			-0.403	(70)		-0.449		
13.10.80	0.0960			-0.403			-0.449		
15.10.80	0.0977			-0.403	(72)		-0.449		
16.10.80	0.0987			-0.403			-0.446		
17.10.80	0.0968			-0.403			-0.445		
20.10.80	0.0987			-0.402			-0.445		
21.10.80	0.1015			-0.402			-0.444		
22.10.80	0.1029			-0.402			-0.446		
23.10.80	0.1021			-0.402			-0.446		
24.10.80	0.1020			-0.402			-0.446		
27.10.80	0.1040			-0.402	(80)		-0.446		
28.10.80	0.1034			-0.401			-0.447		
29.10.80	0.1058			-0.401			-0.447		
30.10.80	0.1062			-0.402			-0.447		
31.10.80	0.1070			-0.403			-0.447		
4.11.80	0.1052			-0.404			-0.450		
6.11.80	0.1081			-0.406	(86)		-0.450		