

5 cm

NUMBERS ~~8, 9, 10~~ 15, 14, 13


INSTALLATION DETAILS:

LOCATION Lower Pit  
 LIFT 2<sup>ND</sup>  
 R.L. -220.2  
 DATE 25.6.1980  
 SHEET # 2

CALIBRATION

1 volt = 1° (Linear over range 0-0.4V)

INCLINOMETER RESULTS

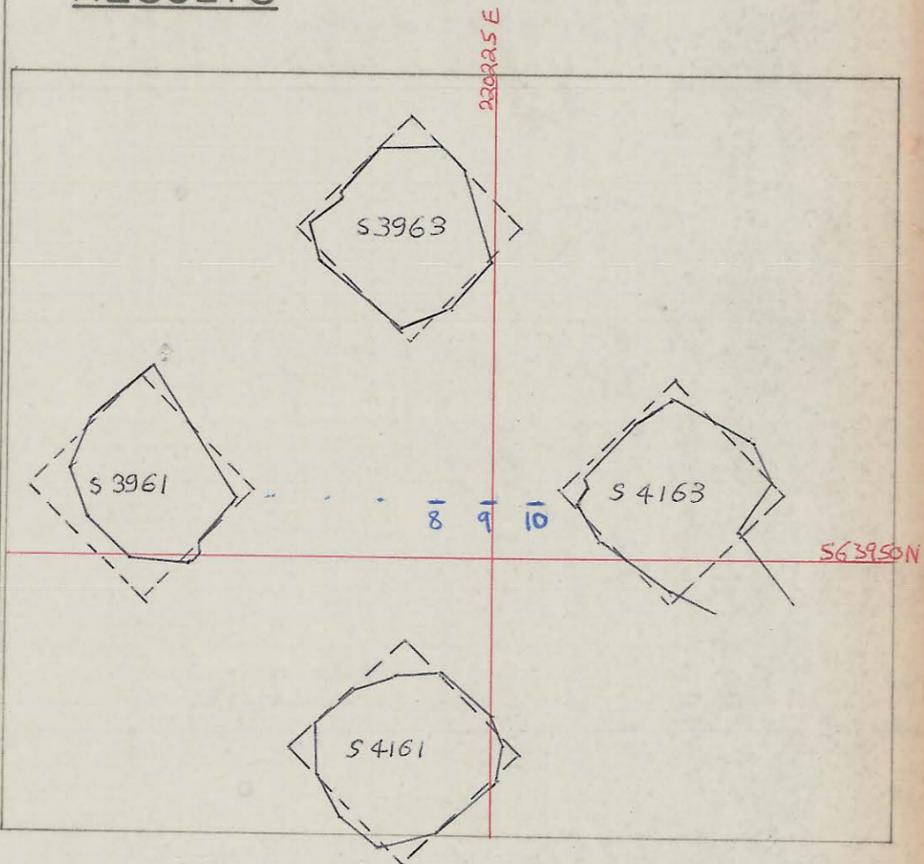

DATE	15			14			13		
	Reading (6)	Δ Angle	Inclination	Reading	Δ Angle	Inclination	Reading	Δ Angle	Inclination
5.9.80	-0.410			-0.142	(45)		-0.448		
8.9.80	-0.411			-0.137			-0.448		
9.9.80	-0.411			-0.155			-0.448		
10.9.80	-0.411			-0.195			-0.447		
11.9.80	-0.412			-0.194			-0.447		
12.9.80	-0.412			-0.196			-0.448		
15.9.80	-0.412			-0.138			-0.448		
16.9.80	-0.412			-0.129			-0.448		
17.9.80	-0.412			-0.127			-0.447		
18.9.80	-0.412			-0.197			-0.448		
19.9.80	-0.413			-0.132			-0.448		
22.9.80	-0.413			-0.138			-0.448		
23.9.80	-0.413			-0.133			-0.448		
24.9.80	-0.413			-0.164			-0.447		
25.9.80	-0.413			-0.153			-0.447		
26.9.80	-0.414			-0.160			-0.447		
29.9.80	-0.413			-0.155			-0.447		
30.9.80	-0.413			-0.191			-0.447		
1.10.80	-0.414			-0.159			-0.446		
2.10.80	-0.414			-0.195			-0.446		
3.10.80	-0.414			-0.193	(65)		-0.446		
8.10.80	-0.415			-0.129	(68)		-0.447		
9.10.80	-0.415			-0.143			-0.447		
10.10.80	-0.415			-0.142			-0.447		
13.10.80	-0.416			<del>0.200</del>			-0.447		
15.10.80	-0.417			-0.261			-0.447		
16.10.80	-0.416			-0.262			-0.447		
17.10.80	-0.417			-0.261			-0.447		
20.10.80	-0.417			-0.255			-0.446		
21.10.80	-0.417			-0.255			-0.446		
22.10.80	-0.418			-0.253			-0.447		
23.10.80	-0.419			-0.251			-0.447		
24.10.80	-0.419			-0.252			-0.447		
27.10.80	-0.419			-0.245			-0.446		
28.10.80	-0.418			-0.212			-0.446		
29.10.80	-0.419			-0.212			-0.447		
30.10.80	-0.419			-0.212			-0.446		
31.10.80	-0.419			-0.215			-0.446		
4.11.80	-0.422			-0.214			-0.449		
6.11.80	-0.422			-0.207	(86)		-0.449		