

5 cm

Universal
Wire
Extensometer

Numbers: 65-69

Installation details


Pillar

Left

RL

Board

Date

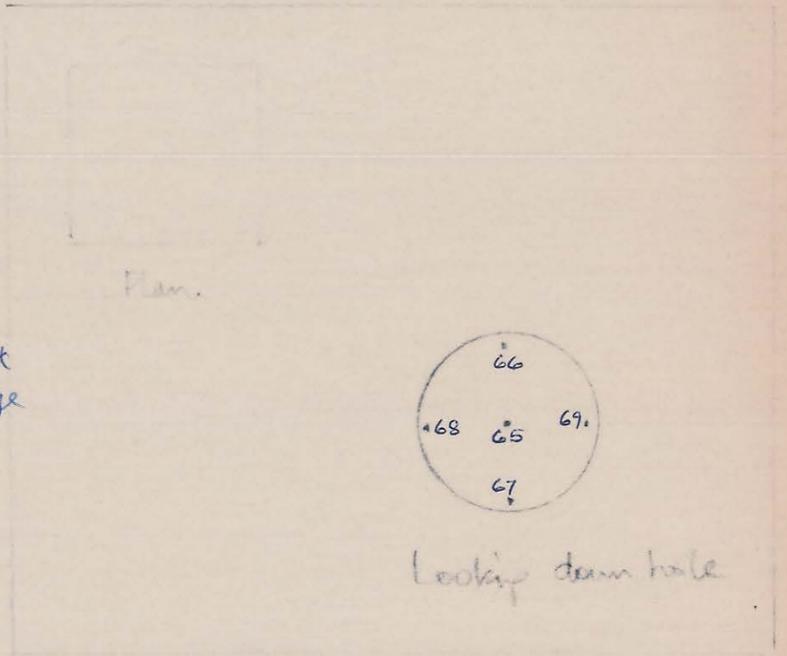

Sensitivity 0.0092 mm/unit change

| Date | Vx100 65 ΔPE mm | Vx100 66 ΔPE mm | Vx100 67 ΔPE mm | Vx100 68 ΔPE mm | Vx100 69 ΔPE mm |
|----------|--------------------|--------------------|--------------------|--------------------|--------------------|
| 22.12.82 | -026 -140 | -070 -73 | -062 -126 | -073 -64 | -072 -56 |
| 24.12.82 | -037 | -084 | -074 | -091 | -089 |
| 5.1.83 | -073 | -085 | -075 | -096 | -090 |
| 10.1.83 | -164 | -331 | -298 | -352 | -349 |
| 14.1.83 | -158 | -337 | -304 | -360 | -355 |
| 24.1.83 | -167 | -341 | -311 | -367 | -359 |
| 2.2.83 | -202 | -343 | -313 | -370 | -361 |
| 7.2.83 | -179 | -349 | -319 | -371 | -365 |
| 15.2.83 | -206 | -347 | -318 | -367 | -362 |
| 22.2.83 | -194 | -355 | -326 | -367 | -368 |
| 4.3.83 | -210 | -379 | -353 | -407 | -396 |
| 9.3.83 | -194 | -354 | -330 | -375 | -369 |
| 14.3.83 | -203 | -360 | -336 | -386 | -376 |
| 21.3.83 | -212 | -365 | -345 | -395 | -381 |
| 6.4.83 | -229 -343 -3.15 | -384 -387 -3.56 | -370 -434 -4.0 | -416 -407 -3.74 | -400 -384 -3.53 |
| 11.5.83 | -237 | -401 | -391 | -430 | -412 |
| 13.5.83 | -242 | -407 | -394 | -435 | -417 |
| 19.5.83 | -238 | -405 | -392 | -426 | -413 |
| 15.6.83 | -2.962 | -411 | -398 | -436 | -417 |
| 15.6.83 | -3.432 | -428 | -418 | -457 | -443 |
| 29.6.83 | -3.358 | -438 | -431 | -3.356 | -447 |
| 6.7.83 | -3076 | -441 | -428 | -3076 | -449 |
| 20.7.83 | -3029 | -447 -450 | -438 | -3026 | -460 |
| 1.8.83 | -3035 | -458 -461 | -452 | -3034 | -470 |

REF PLAN

SCALE 1:

KING ISLAND SCHEMATIC KING ISLAND

GEOLOGY
SURVEY
PLANNING
ROCK MEC.
GRADE CON
DRAFTING
T.S.S.

DRAWING NUMBER