


27 JUN 1981

5 cm

03 DM 07 3007

0374_3230

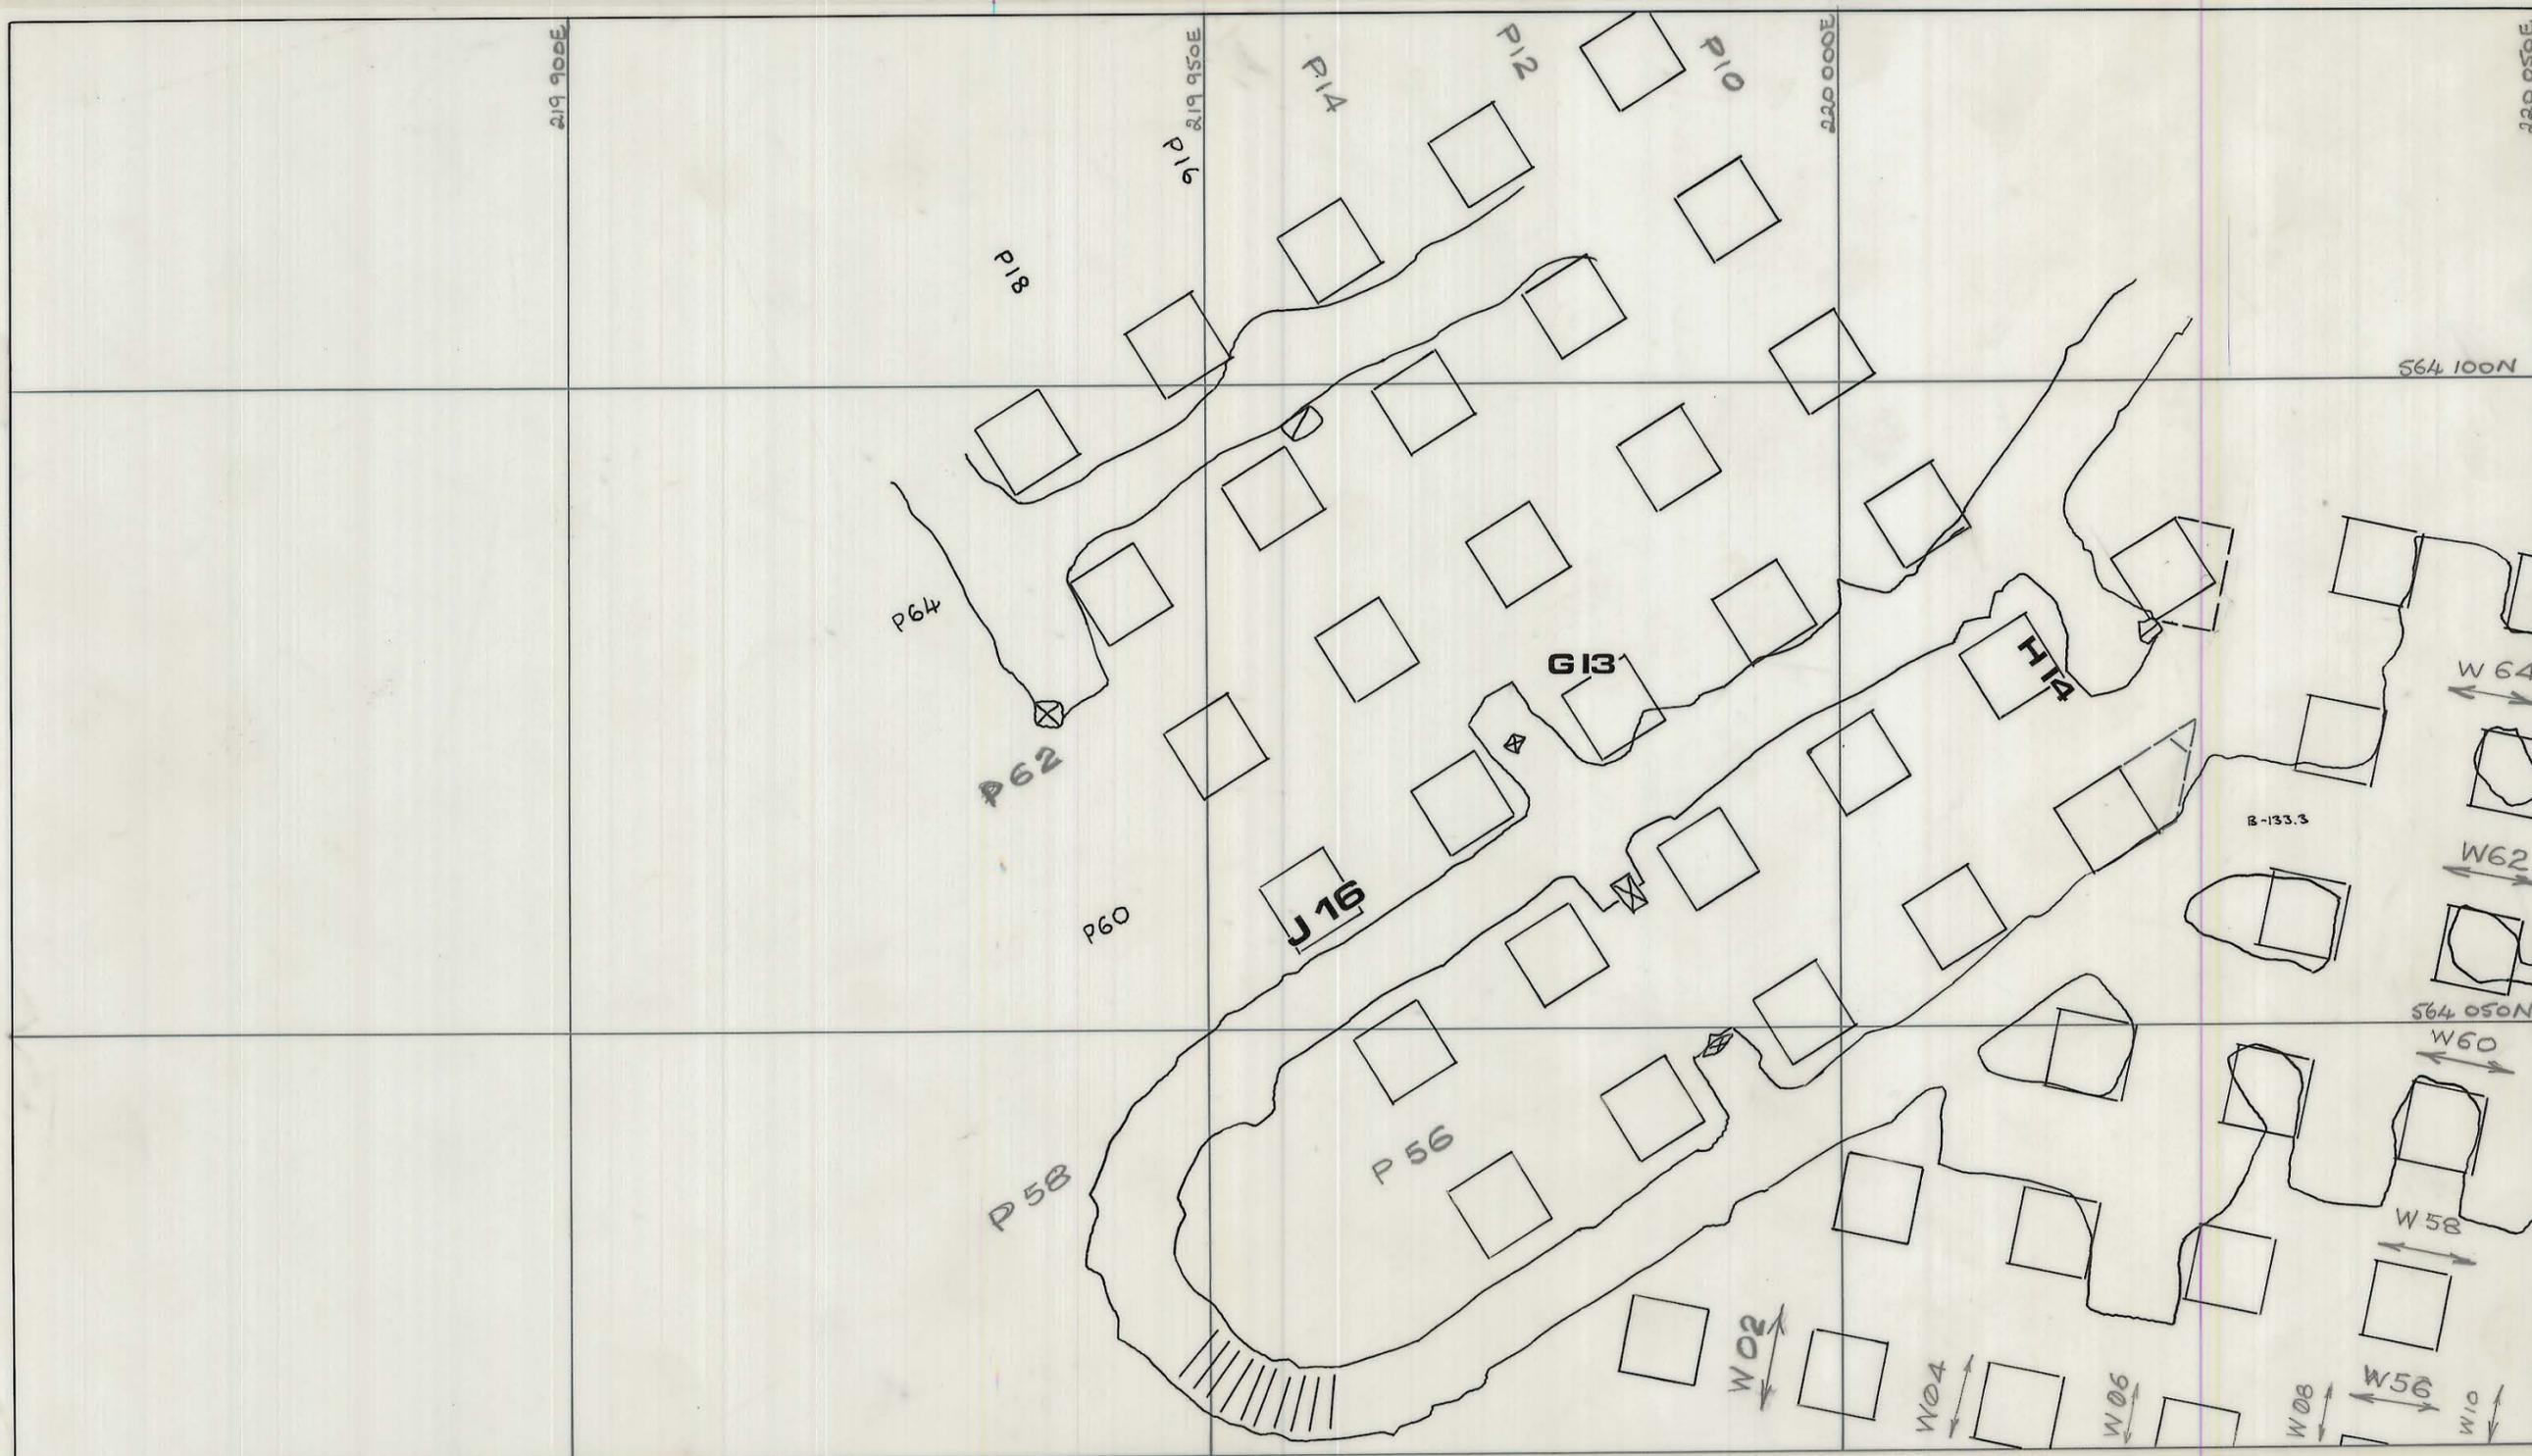

REVISIONS NO	DATE	DESCRIPTION	INITIALS
1	21-12-78	W system stope numbers added	M.G.M.

KING ISLAND SCHEELITE		APPROVAL	COPY
DATE: 24 AUGUST 1978	SCALE: 1:500	PLANNING ENG.: W. 23/8/78	
MINE: DOLPHIN	DWG/NO.: 03 DM 07 3007	SENIOR PLAN. ENG.: ABSENT	1
PIT STOPE PILLAR PATTERN NORTH OF J16		MINE SUPT.: G.E. 24/8/78	2
		G. MINING SUPT.: J. 24/8/78	
		SENIOR SURV'R.: J. 29/8/78	1
		SENIOR GEOLOGIST: J.B. 29/8/78	1
PRELIMINARY	FINAL	SURVEYOR:	1