


0374_3231

03DM07-3009

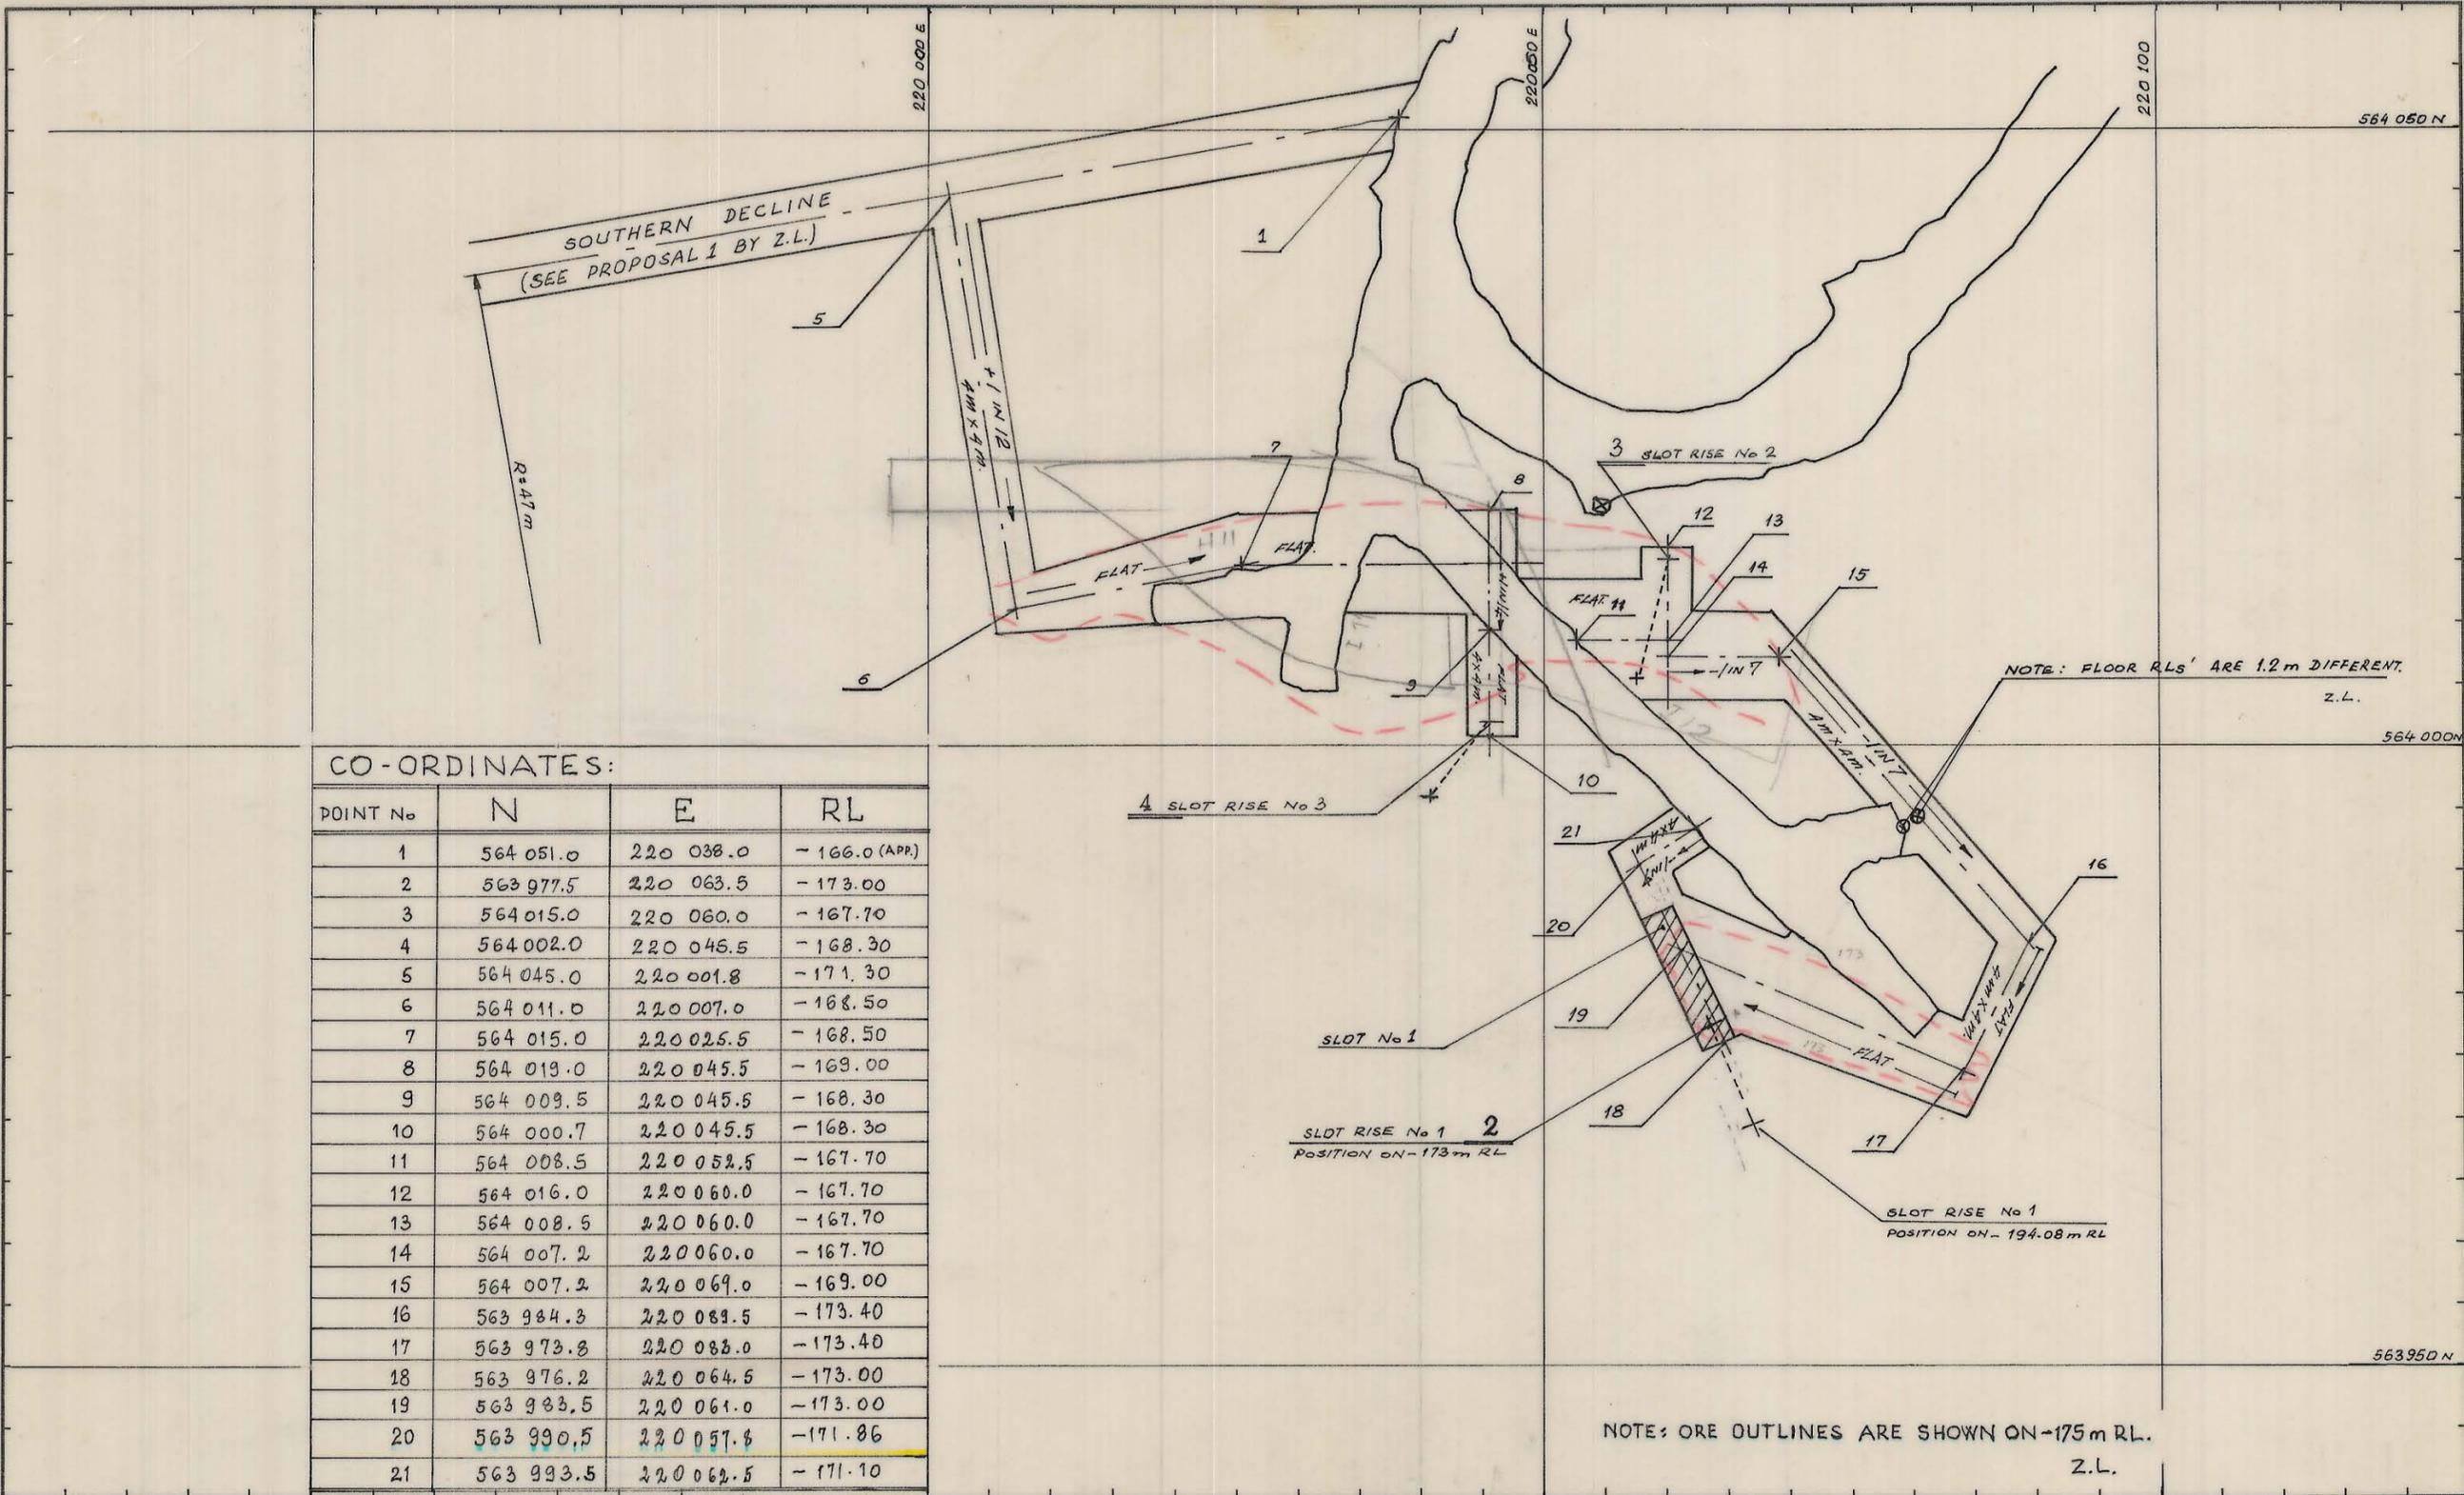

CO-ORDINATES:

POINT No	N	E	RL
1	564 051.0	220 038.0	-166.0 (APP)
2	563 977.5	220 063.5	-173.00
3	564 015.0	220 060.0	-167.70
4	564 002.0	220 046.5	-168.30
5	564 045.0	220 001.8	-171.30
6	564 011.0	220 007.0	-168.50
7	564 015.0	220 025.5	-168.50
8	564 019.0	220 045.5	-169.00
9	564 009.5	220 045.5	-168.30
10	564 000.7	220 045.5	-168.30
11	564 008.5	220 052.5	-167.70
12	564 016.0	220 060.0	-167.70
13	564 008.5	220 060.0	-167.70
14	564 007.2	220 060.0	-167.70
15	564 007.2	220 069.0	-169.00
16	563 984.3	220 089.5	-173.40
17	563 973.8	220 083.0	-173.40
18	563 976.2	220 064.5	-173.00
19	563 983.5	220 061.0	-173.00
20	563 990.5	220 057.8	-171.86
21	563 993.5	220 062.5	-171.10

REF PLAN 042MIA-1006.
 HOLD Dev 1-5-6
 J.B.
 29/1/80

GEOLOGY		
SURVEY		
PLANNING	Z.L.	OCT. 1980.
ROCK MEC.		
GRADE CON.		
DRAFTING		
T.S.S.		29/1/80

SCALE 1: 500
 KING ISLAND SCHEELITE GRASSY KING ISLAND
PIT DAG OREBODY:
-170 LEVEL.
 DRAWING NUMBER 03DM07-3009.