


5 cm

030M07-3001

0374_3236

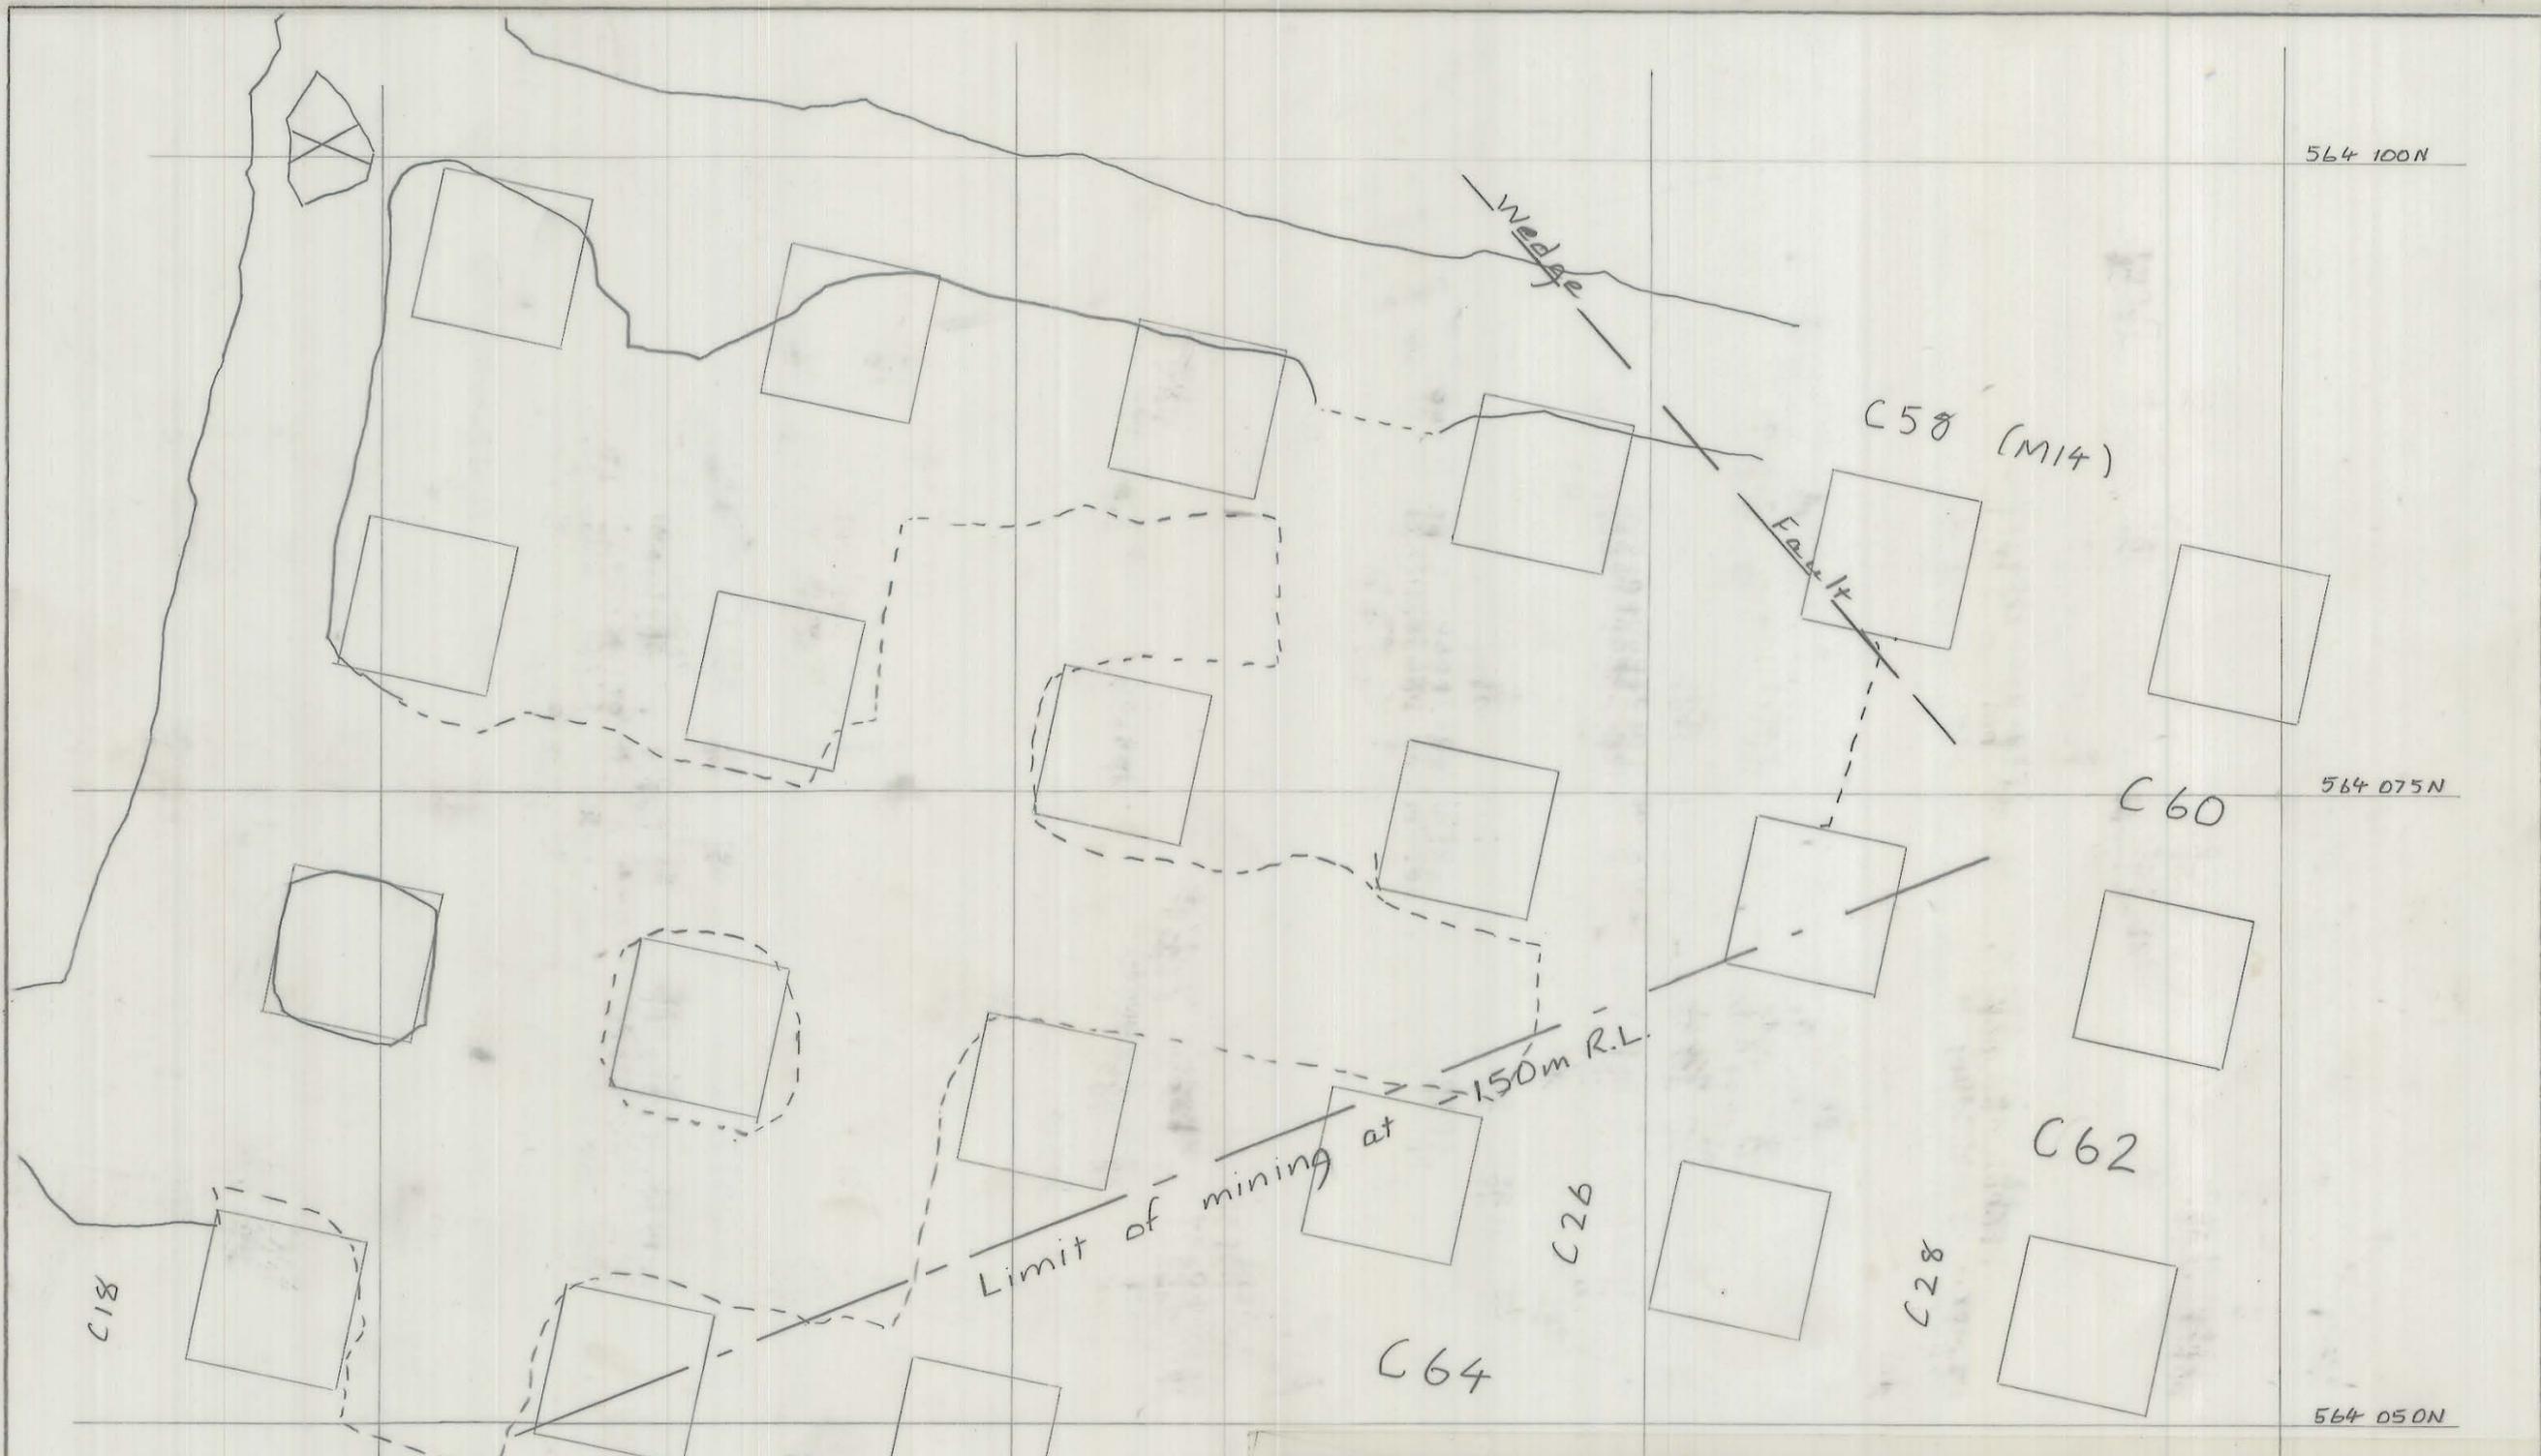

KING ISLAND SCHEELITE		APPROVAL	COPY
DATE: 10/8/76	SCALE: 1:250	PLANNING ENG.: <i>[Signature]</i>	
MINE: DOLPHIN	DWG/NO.: 030M07-3001	SENIOR PLAN. ENG.:	
Stopping Limits -150m R.L. C Lens Central		MINE SUPT.:	
		G. MINING SUPT.:	
		SENIOR SURV'R.:	
		SENIOR GEOLOGIST:	
PRELIMINARY	<input checked="" type="checkbox"/>	FINAL	