


5 cm

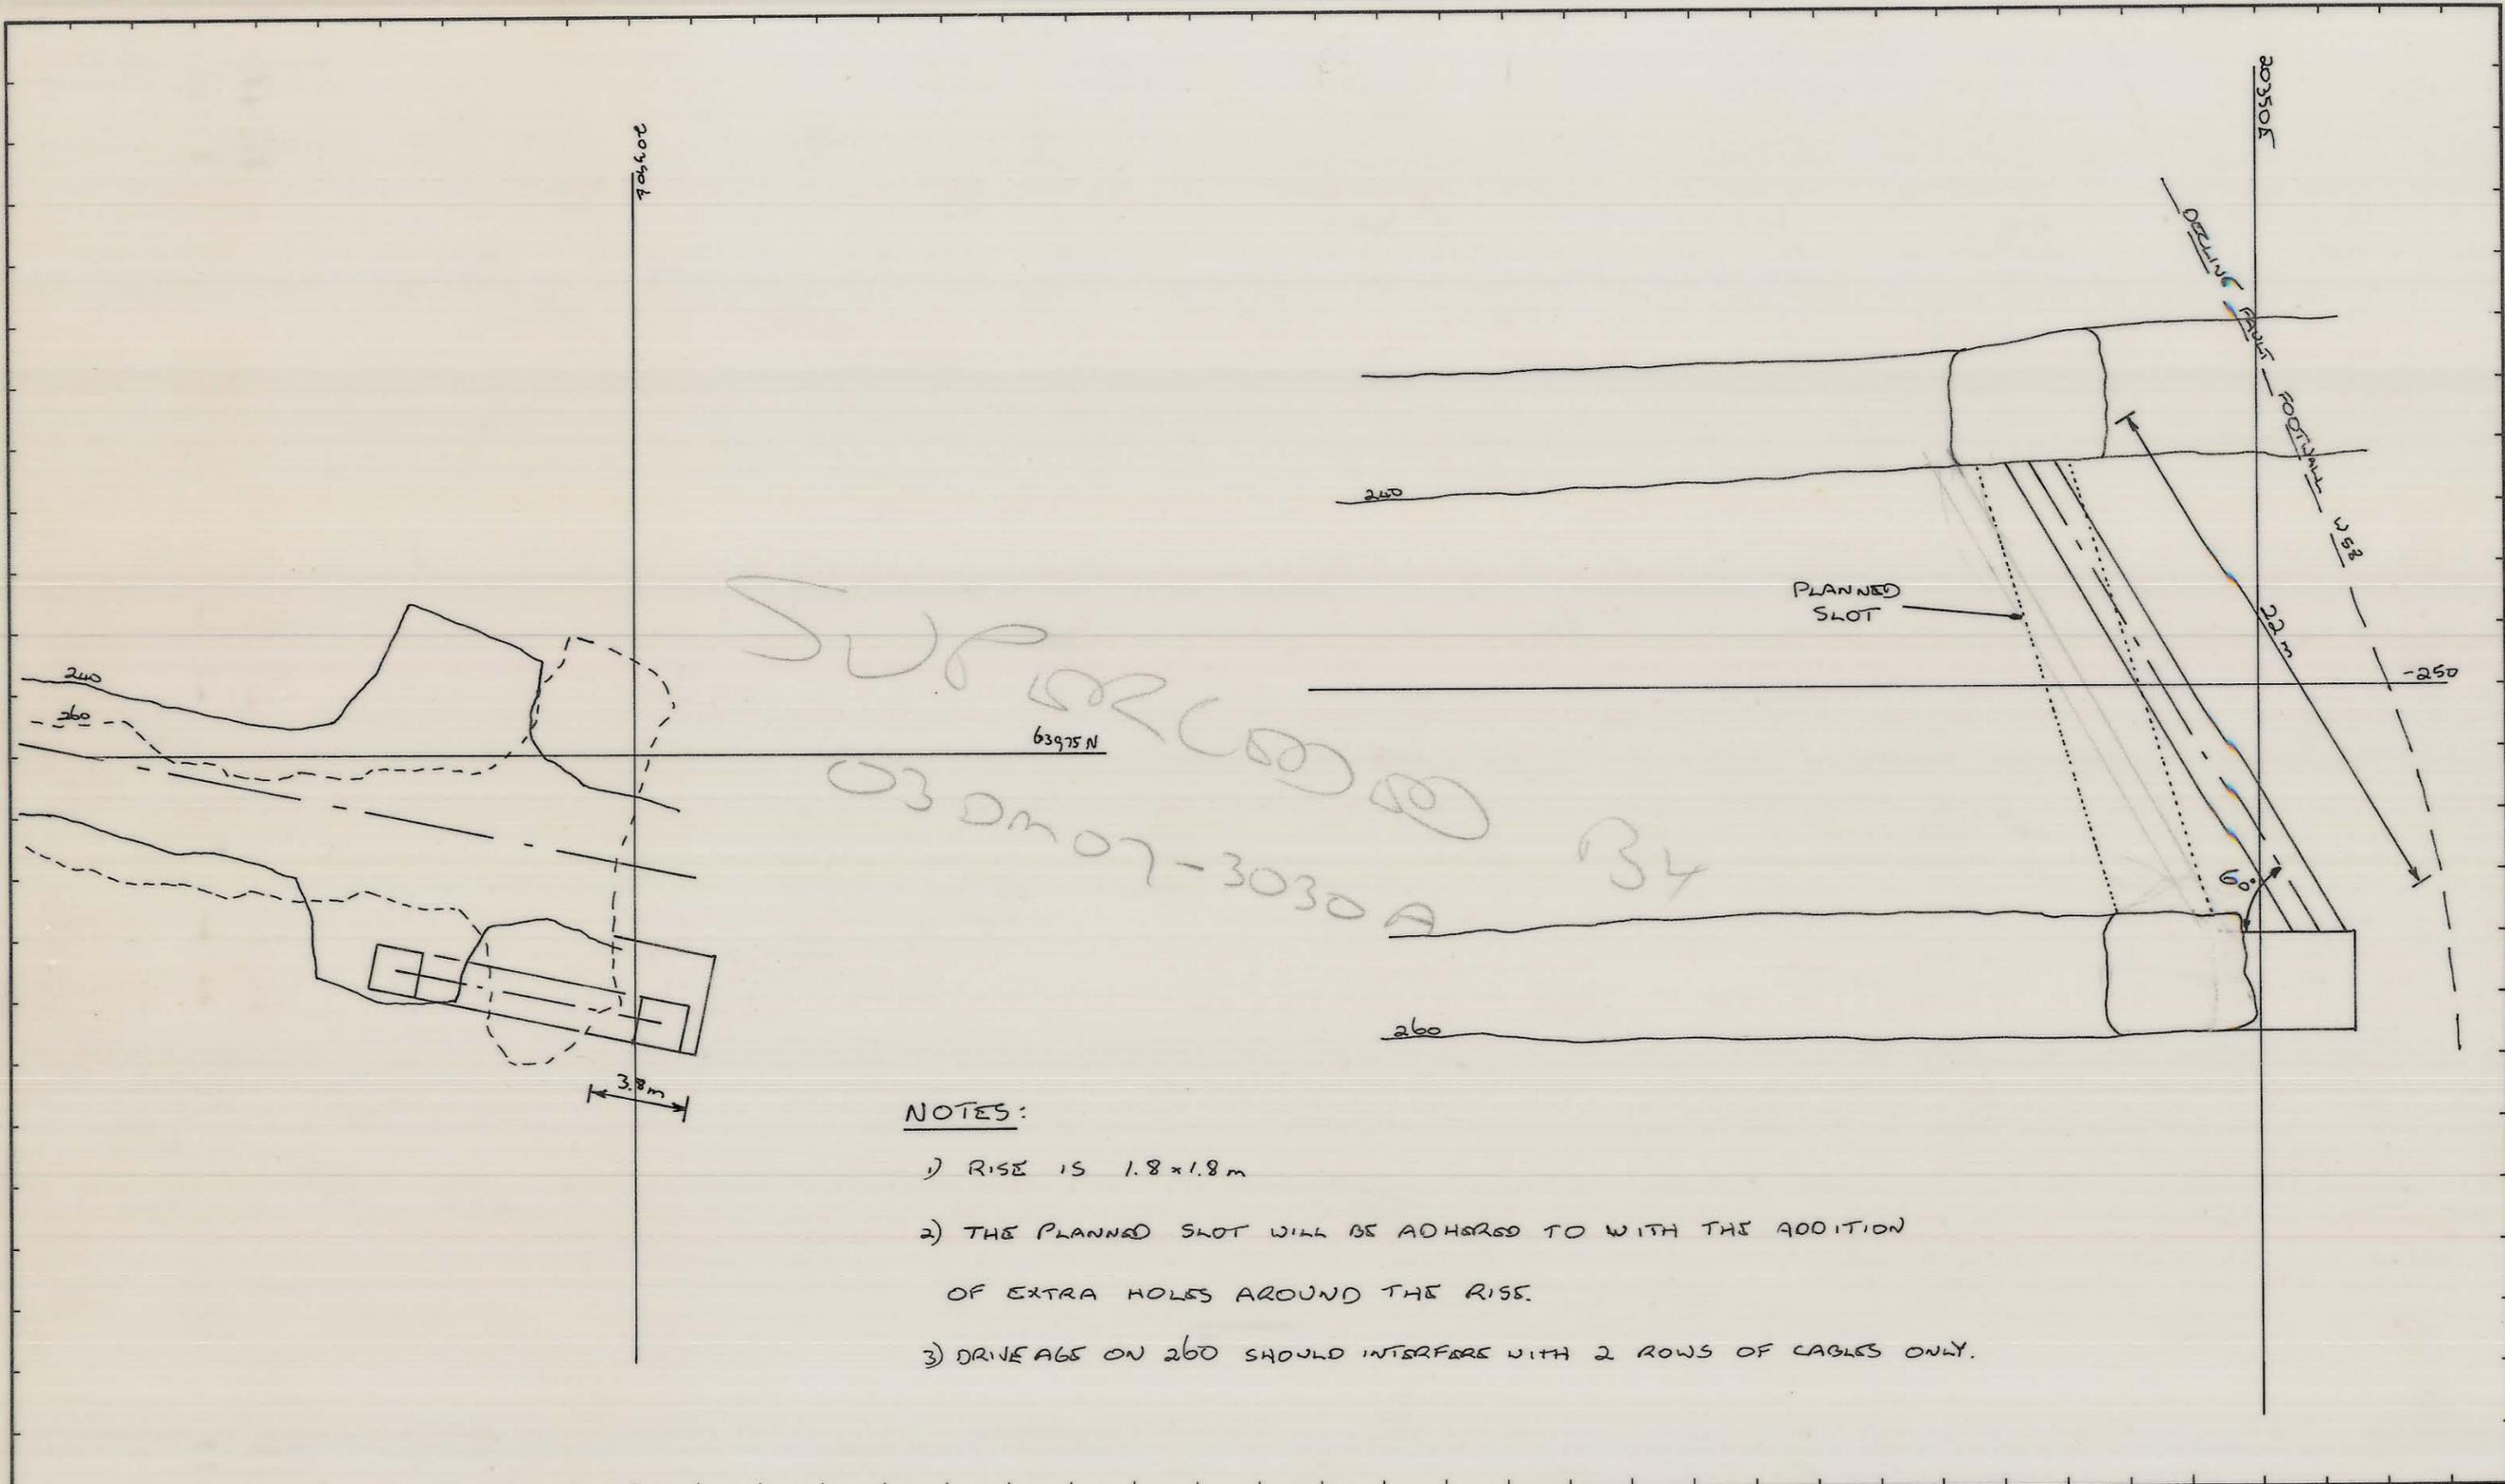


NOTES:

- 1) RISE IS 1.8 x 1.8 m
- 2) THE PLANNED SLOT WILL BE ADHERED TO WITH THE ADDITION OF EXTRA HOLES AROUND THE RISE.
- 3) DRIVE AGE ON 260 SHOULD INTERFERE WITH 2 ROWS OF CABLES ONLY.

REF PLAN 030m07-1023

GEOLOGY	
SURVEY	
PLANNING	
ROCK MEC.	
GRADE CON.	
DRAFTING	
T.S.S.	ap 13/12/82

SCALE 1: 250

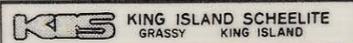

DOLPHIN MINE
 W58
 240-260
 REVISED SLOT RISE
 DRAWING NUMBER
 030m07-3030