


0374_3248

03 PM 07 - 3033
5 cm

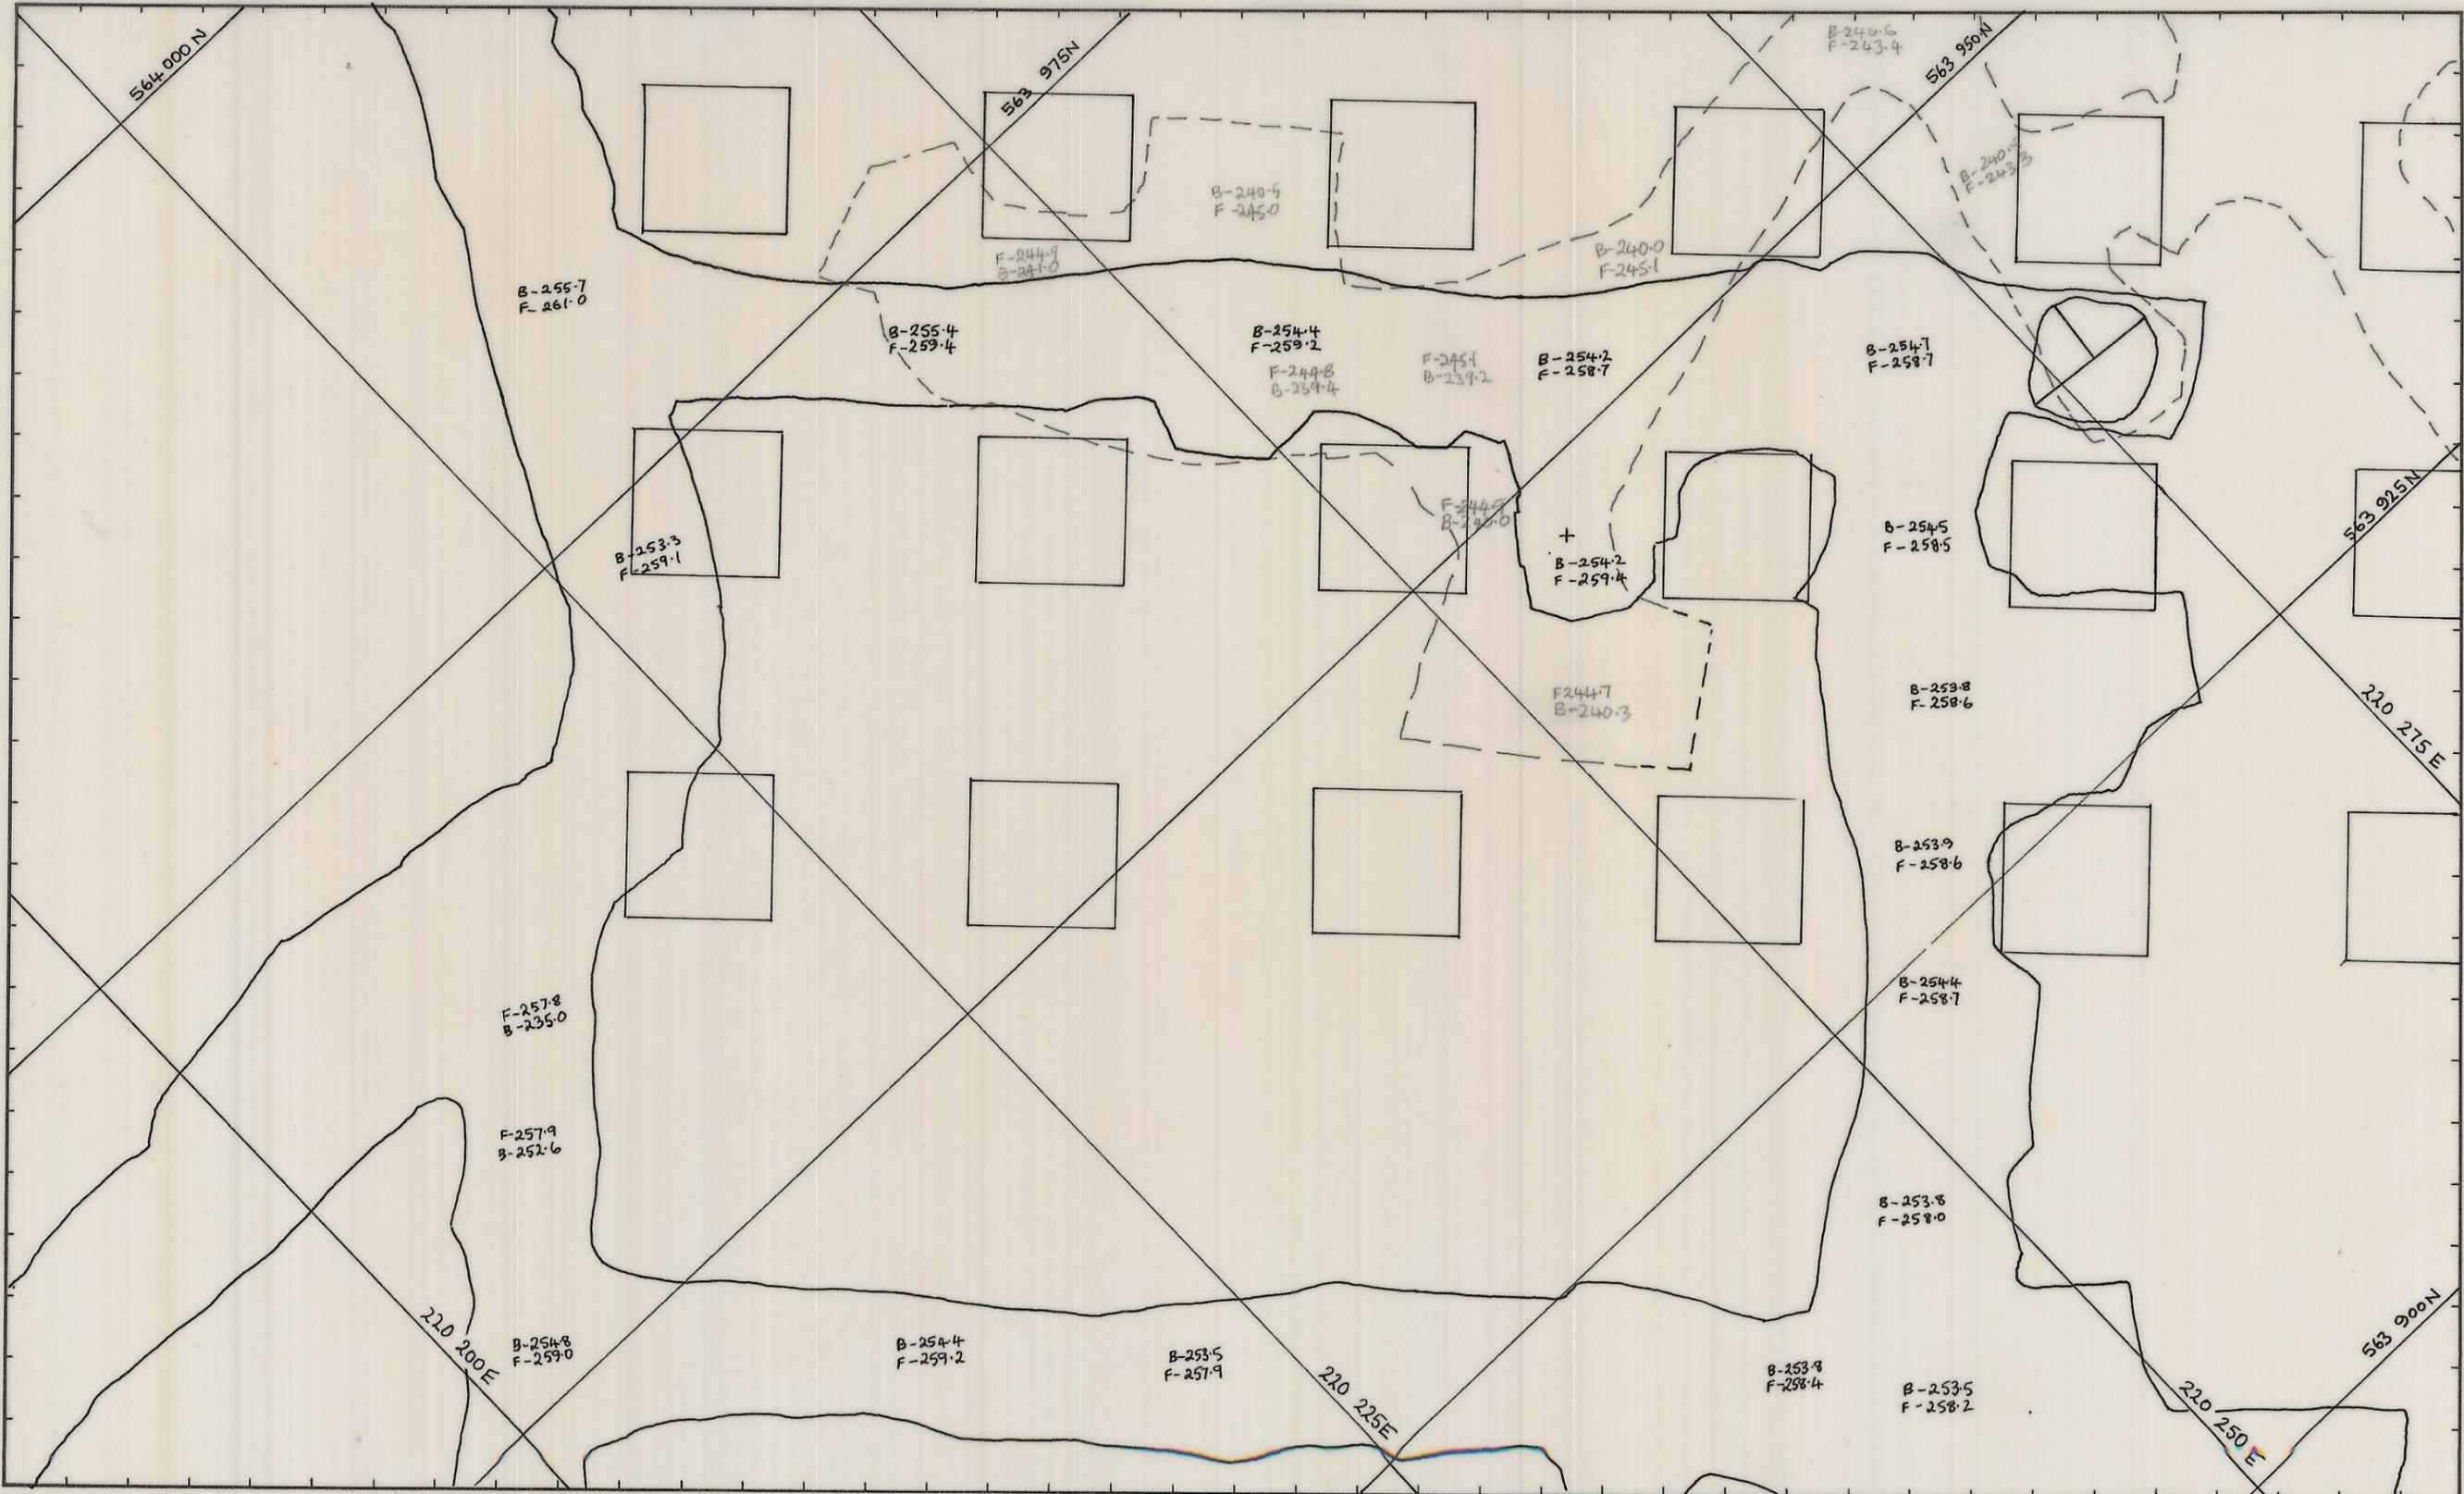

REF. PLAN	GEOLOGY		SCALE 1:	
	SURVEY			
	PLANNING			
	ROCK MEC.			
	GRADE CON.			
	DRAFTING			
T.S.S.			DRAWING NUMBER	