


NOTE:
THIS DEVELOPMENT DEPENDS ON EXISTENCE OF ORE AND HAS TO BE, PERHAPS, ADJUSTED IN ACCORDANCE TO THE BETTER KNOWLEDGE OF OREBODY OF THIS AREA.

Z.L. 24.10.1980.

CO-ORDINATES:

POINT No	N	E	RL
1	563.984.0	220 042.5	-197.5
2	563.984.0	220 012.5	-197.5
3	563.991.5	220 006.0	-197.5
4	564.001.0	220 001.0	-197.5
5	564.001.0	220 006.0	-197.5
6	564.002.5	220 008.7	-197.5
7	564.002.5	220 041.0	-197.8
8	564.008.5	220 041.0	-197.8
9	563.999.0	220 041.0	-197.8
10	563.996.0	220 041.0	-193.6 (back)
11	563.999.0	220 057.5	-197.8
12	564.005.5	220 057.5	-193.6 (back)
13	563.995.0	220 057.5	-197.8
14	563.980.5	220 053.5	-197.5
15	563.981.7	220 057.0	-197.5
16	563.967.0	220 063.5	-197.5
17	563.967.5	220 100.0	-197.8
18	563.967.5	220 106.0	-197.8
19	563.969.8	220 066.5	-194.08 (back)
20	563.970.5	220 062.0	-197.8

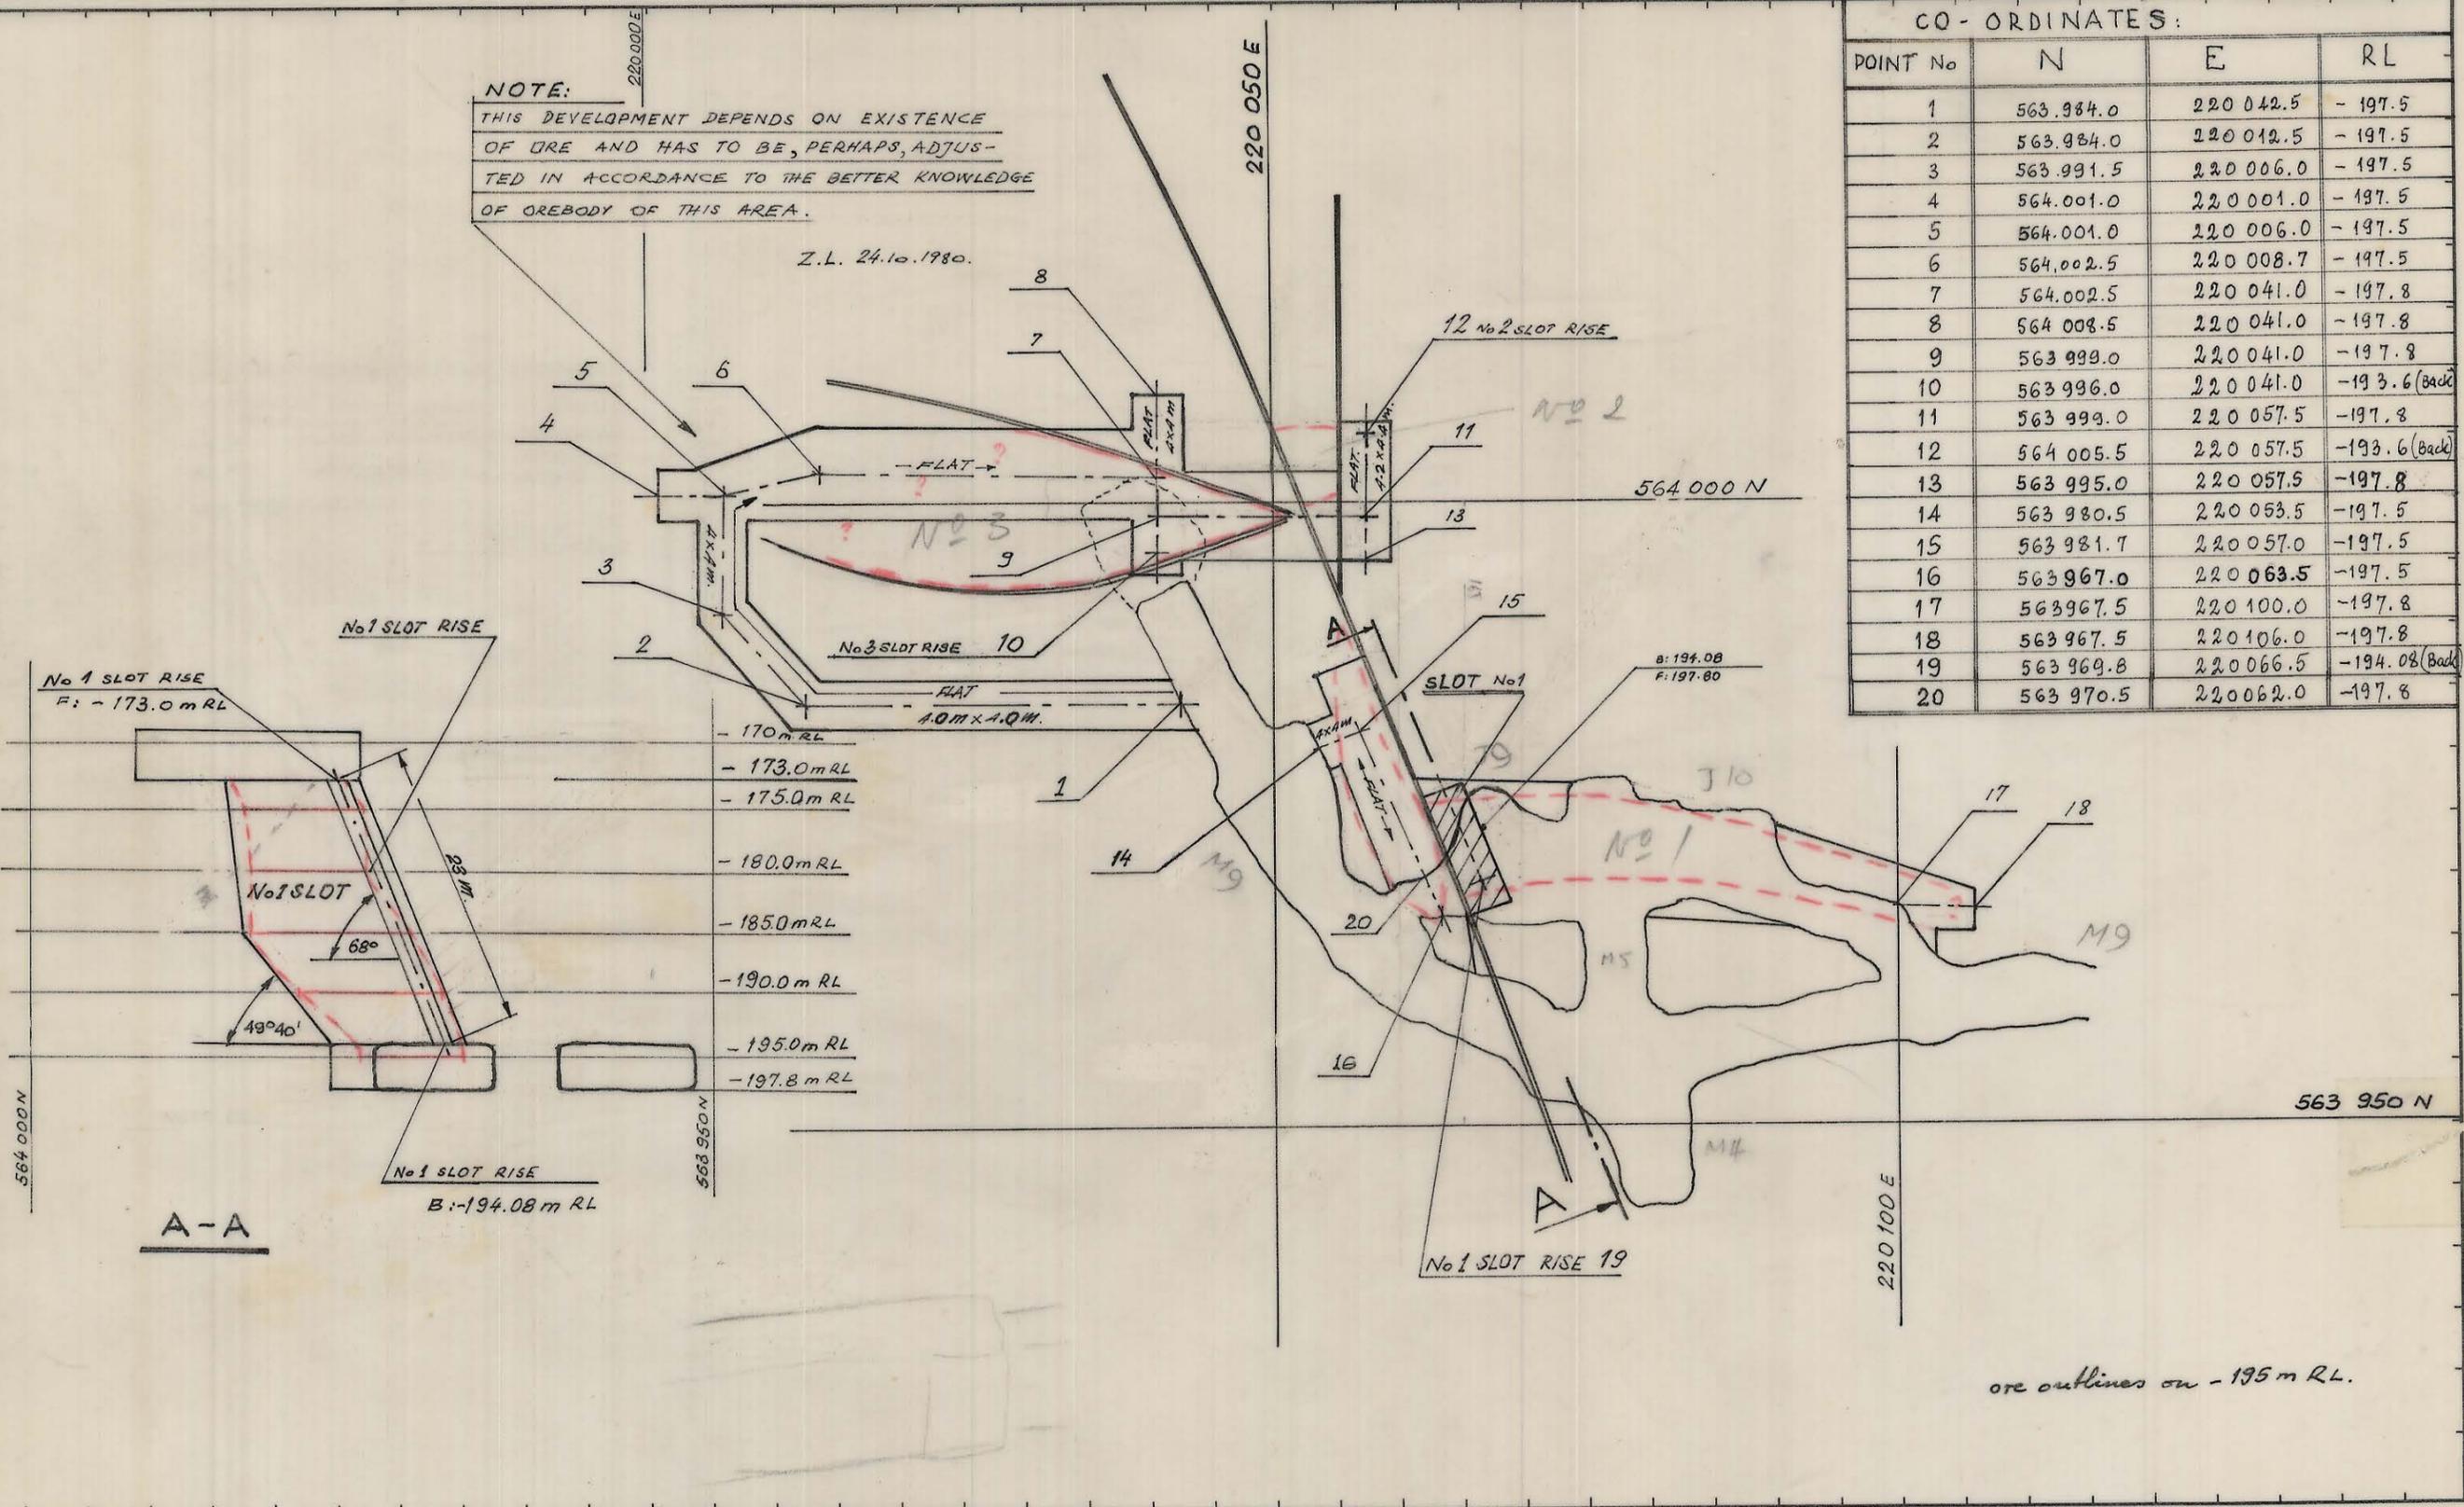


ore outlines on -195 m RL.

REF PLAN 04DM14-1007

Establish Undercut Pod 3 Before any development in Drivage Done

GEOLOGY		
SURVEY		
PLANNING	Z.L.	26.10.80
ROCK MEC.		
GRADE CON.		
DRAFTING		
T.S.S.		

SCALE 1:500

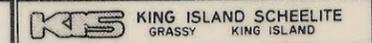

-195 LEVEL

DRAWING NUMBER 03DM07-3011