


03 DM 07 - 3012

0374_3254

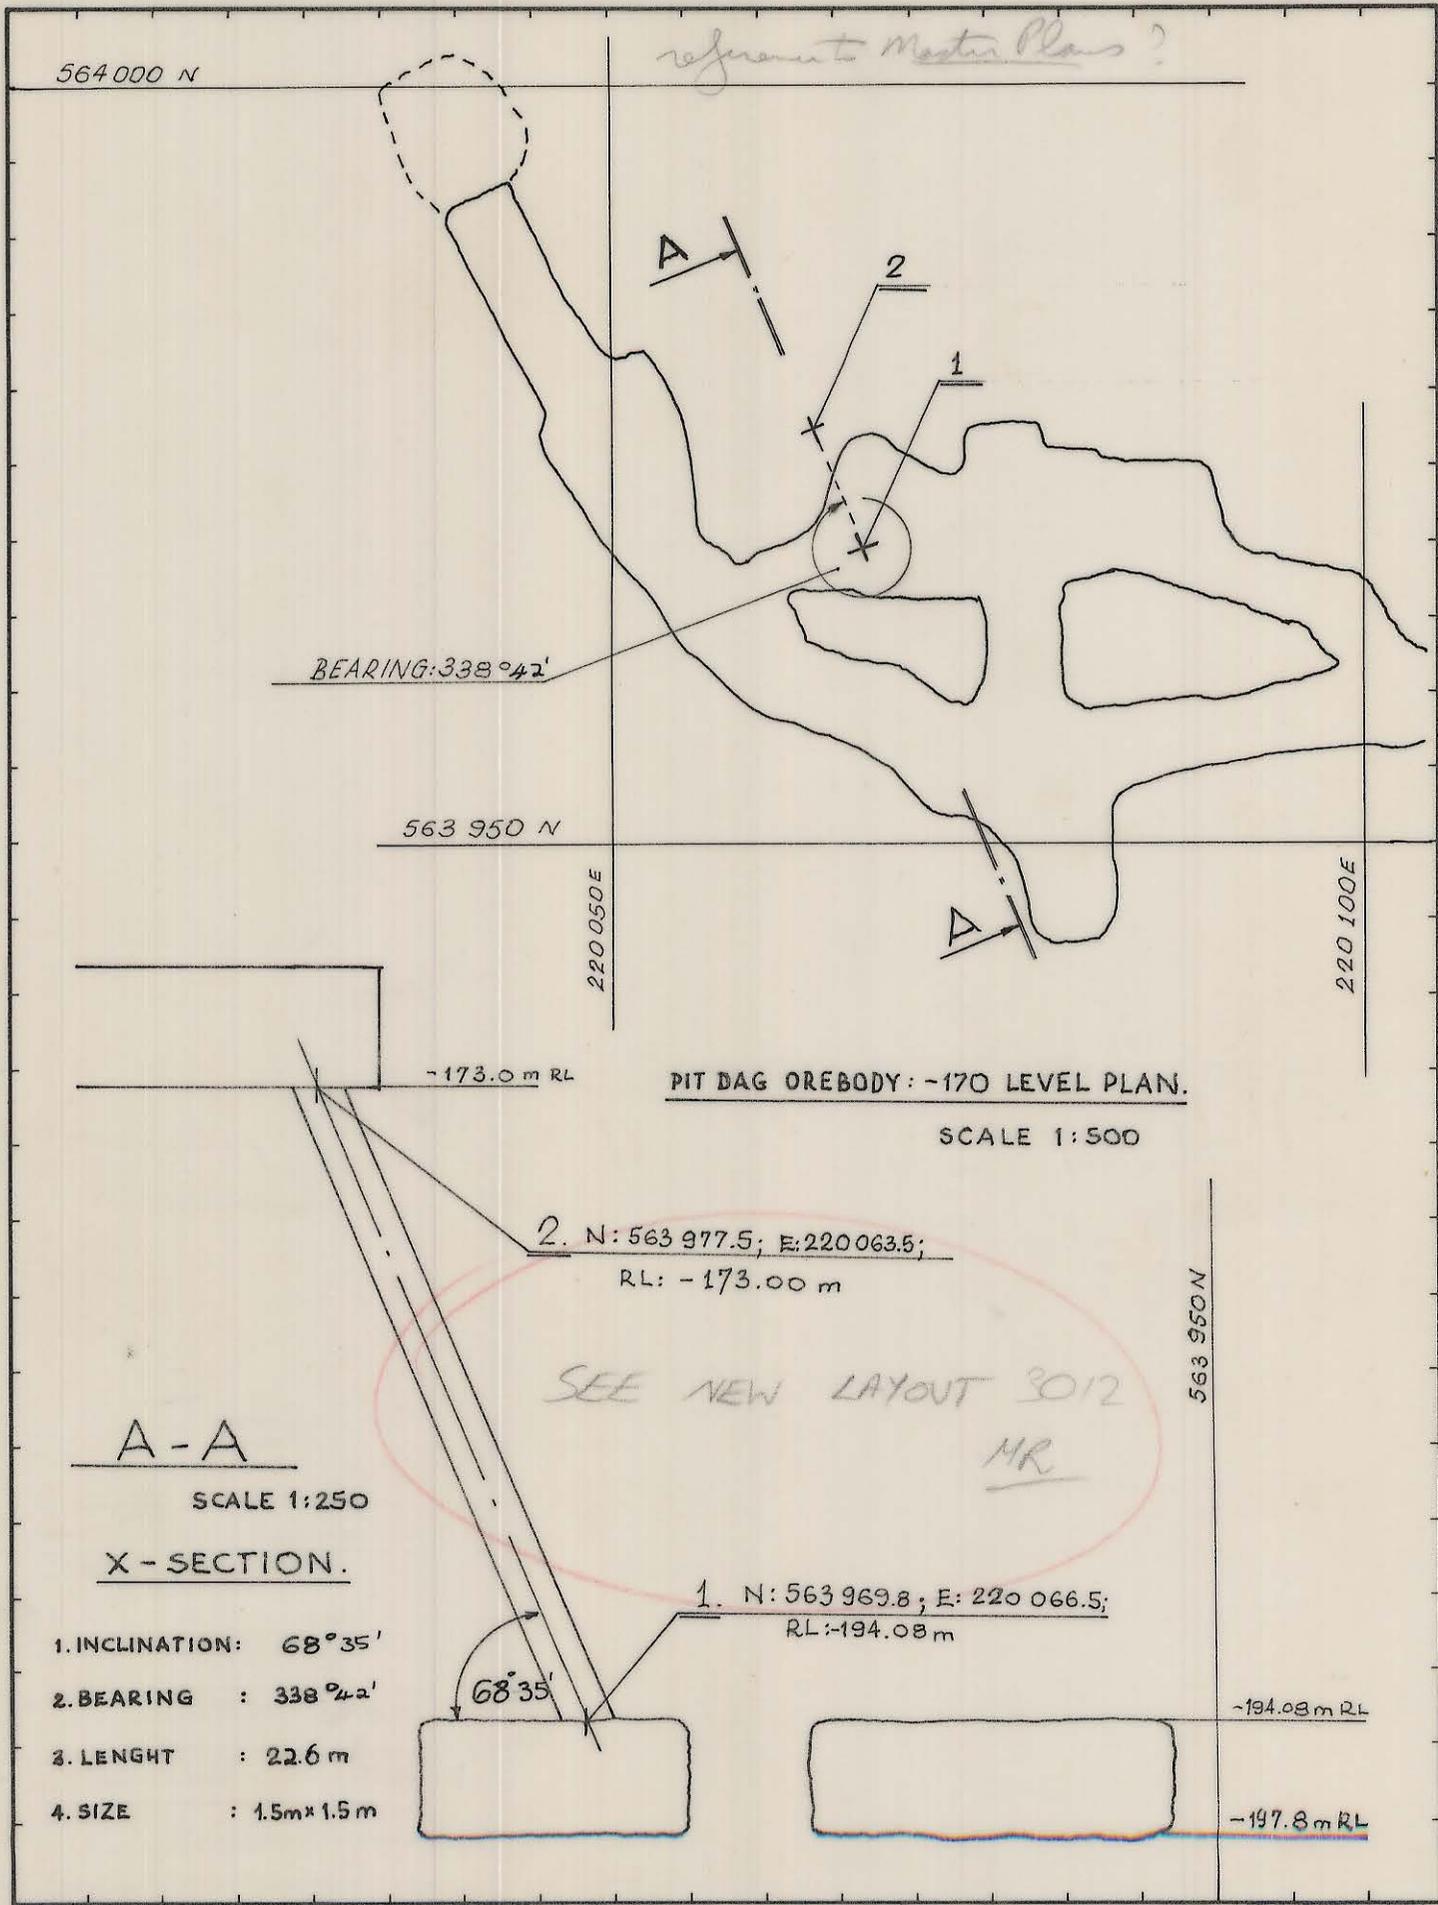

REF PLAN	GEOLOGY			1:500; 1:250 SCALE	KING ISLAND SCHEELITE GRASSY KING ISLAND
	SURVEY	<i>2. 28/10/80</i>	28/10/80		
	PLANNING	Z.L.	27.10.8	PIT DAG OREBODY: <u>No 1 SLOT RISE.</u>	
	ROCK. MEC.				
	GRADE CON.				
	DRAFTING				
T.S.S.	<i>08/29/10/80</i>	29/10/80	DRAWING NUMBER 03 DM 07 - 3012		