


03 DM 07 - 3018

0374_3262

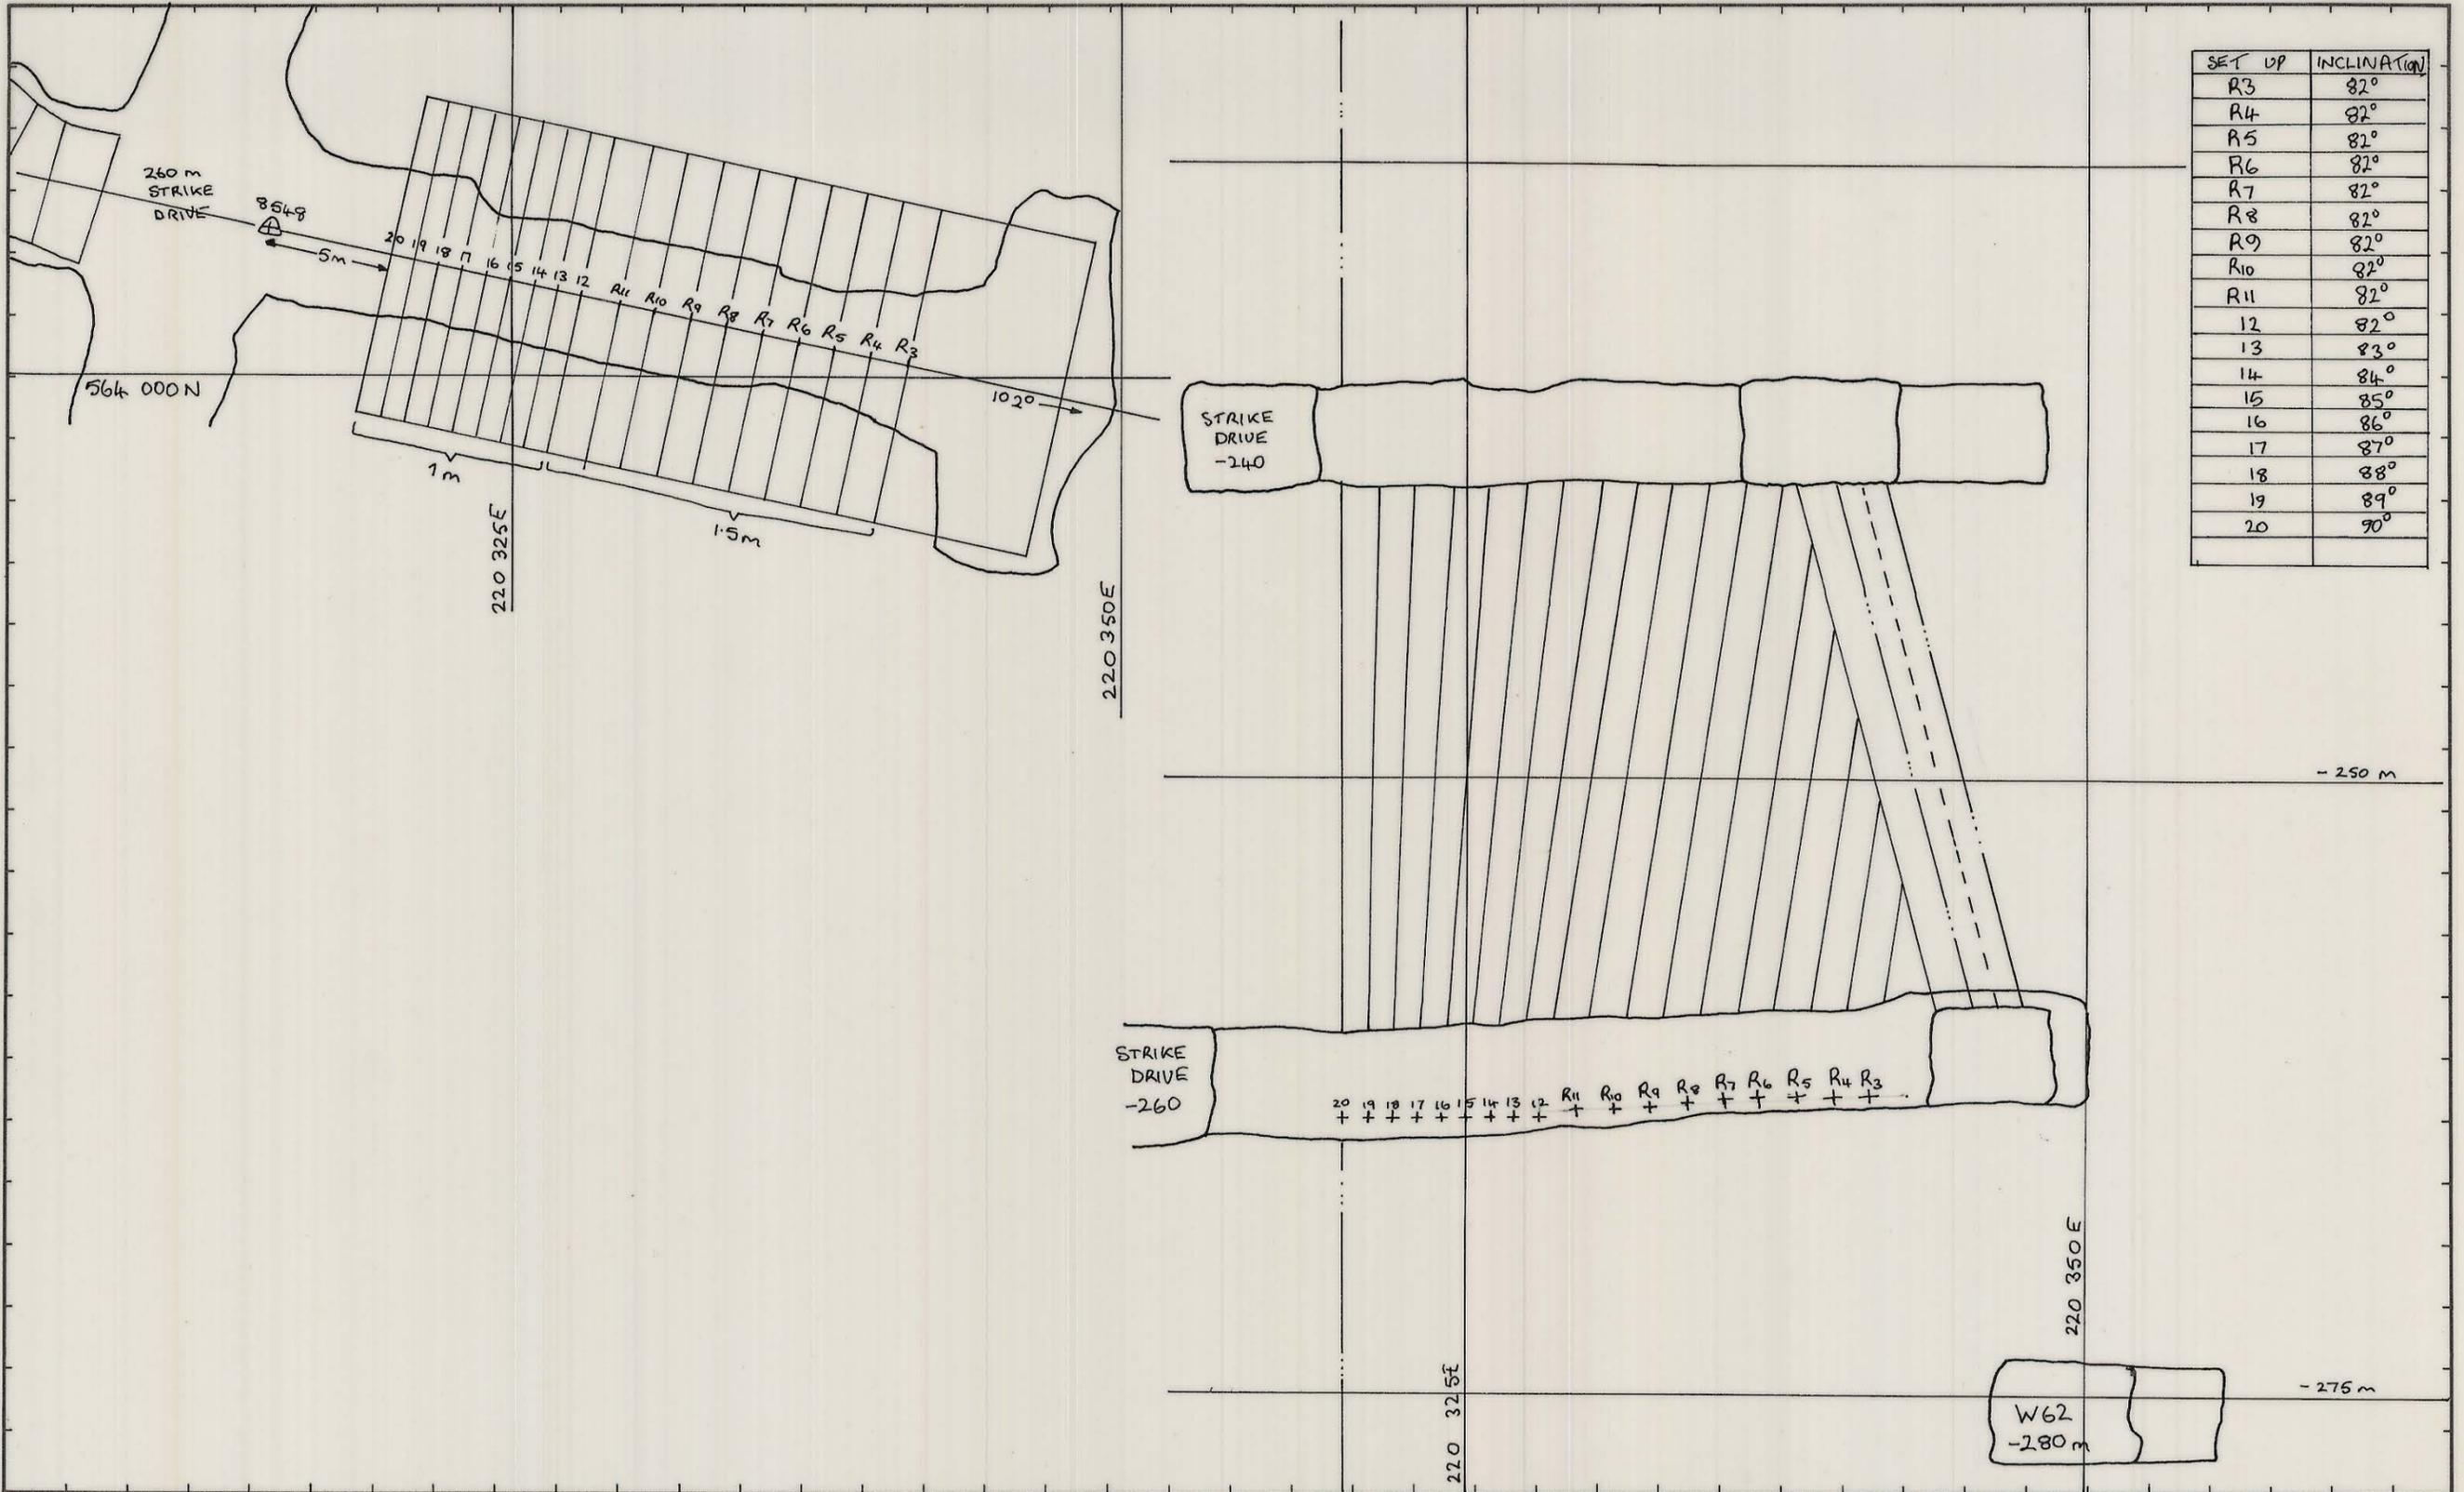

REF PLAN 03 DM 07 - 1022

GEOLOGY	
SURVEY	
PLANNING	ADJ 16-6-82
ROCK MEC.	
GRADE CON.	
DRAFTING	
T.S.S.	

SCALE	1:250
DRAWING NUMBER	03 DM 07 - 3018

KIS KING ISLAND SCHEELITE
GRASSY KING ISLAND

W62 -260m R.L. RING
DRILLING REVISED SET UP
POSITIONS.