


0374\_3270

DOLPHIN MINE  
1:500  
MASTER PLANNING  
TO -80 m RL  
1-22-28-B

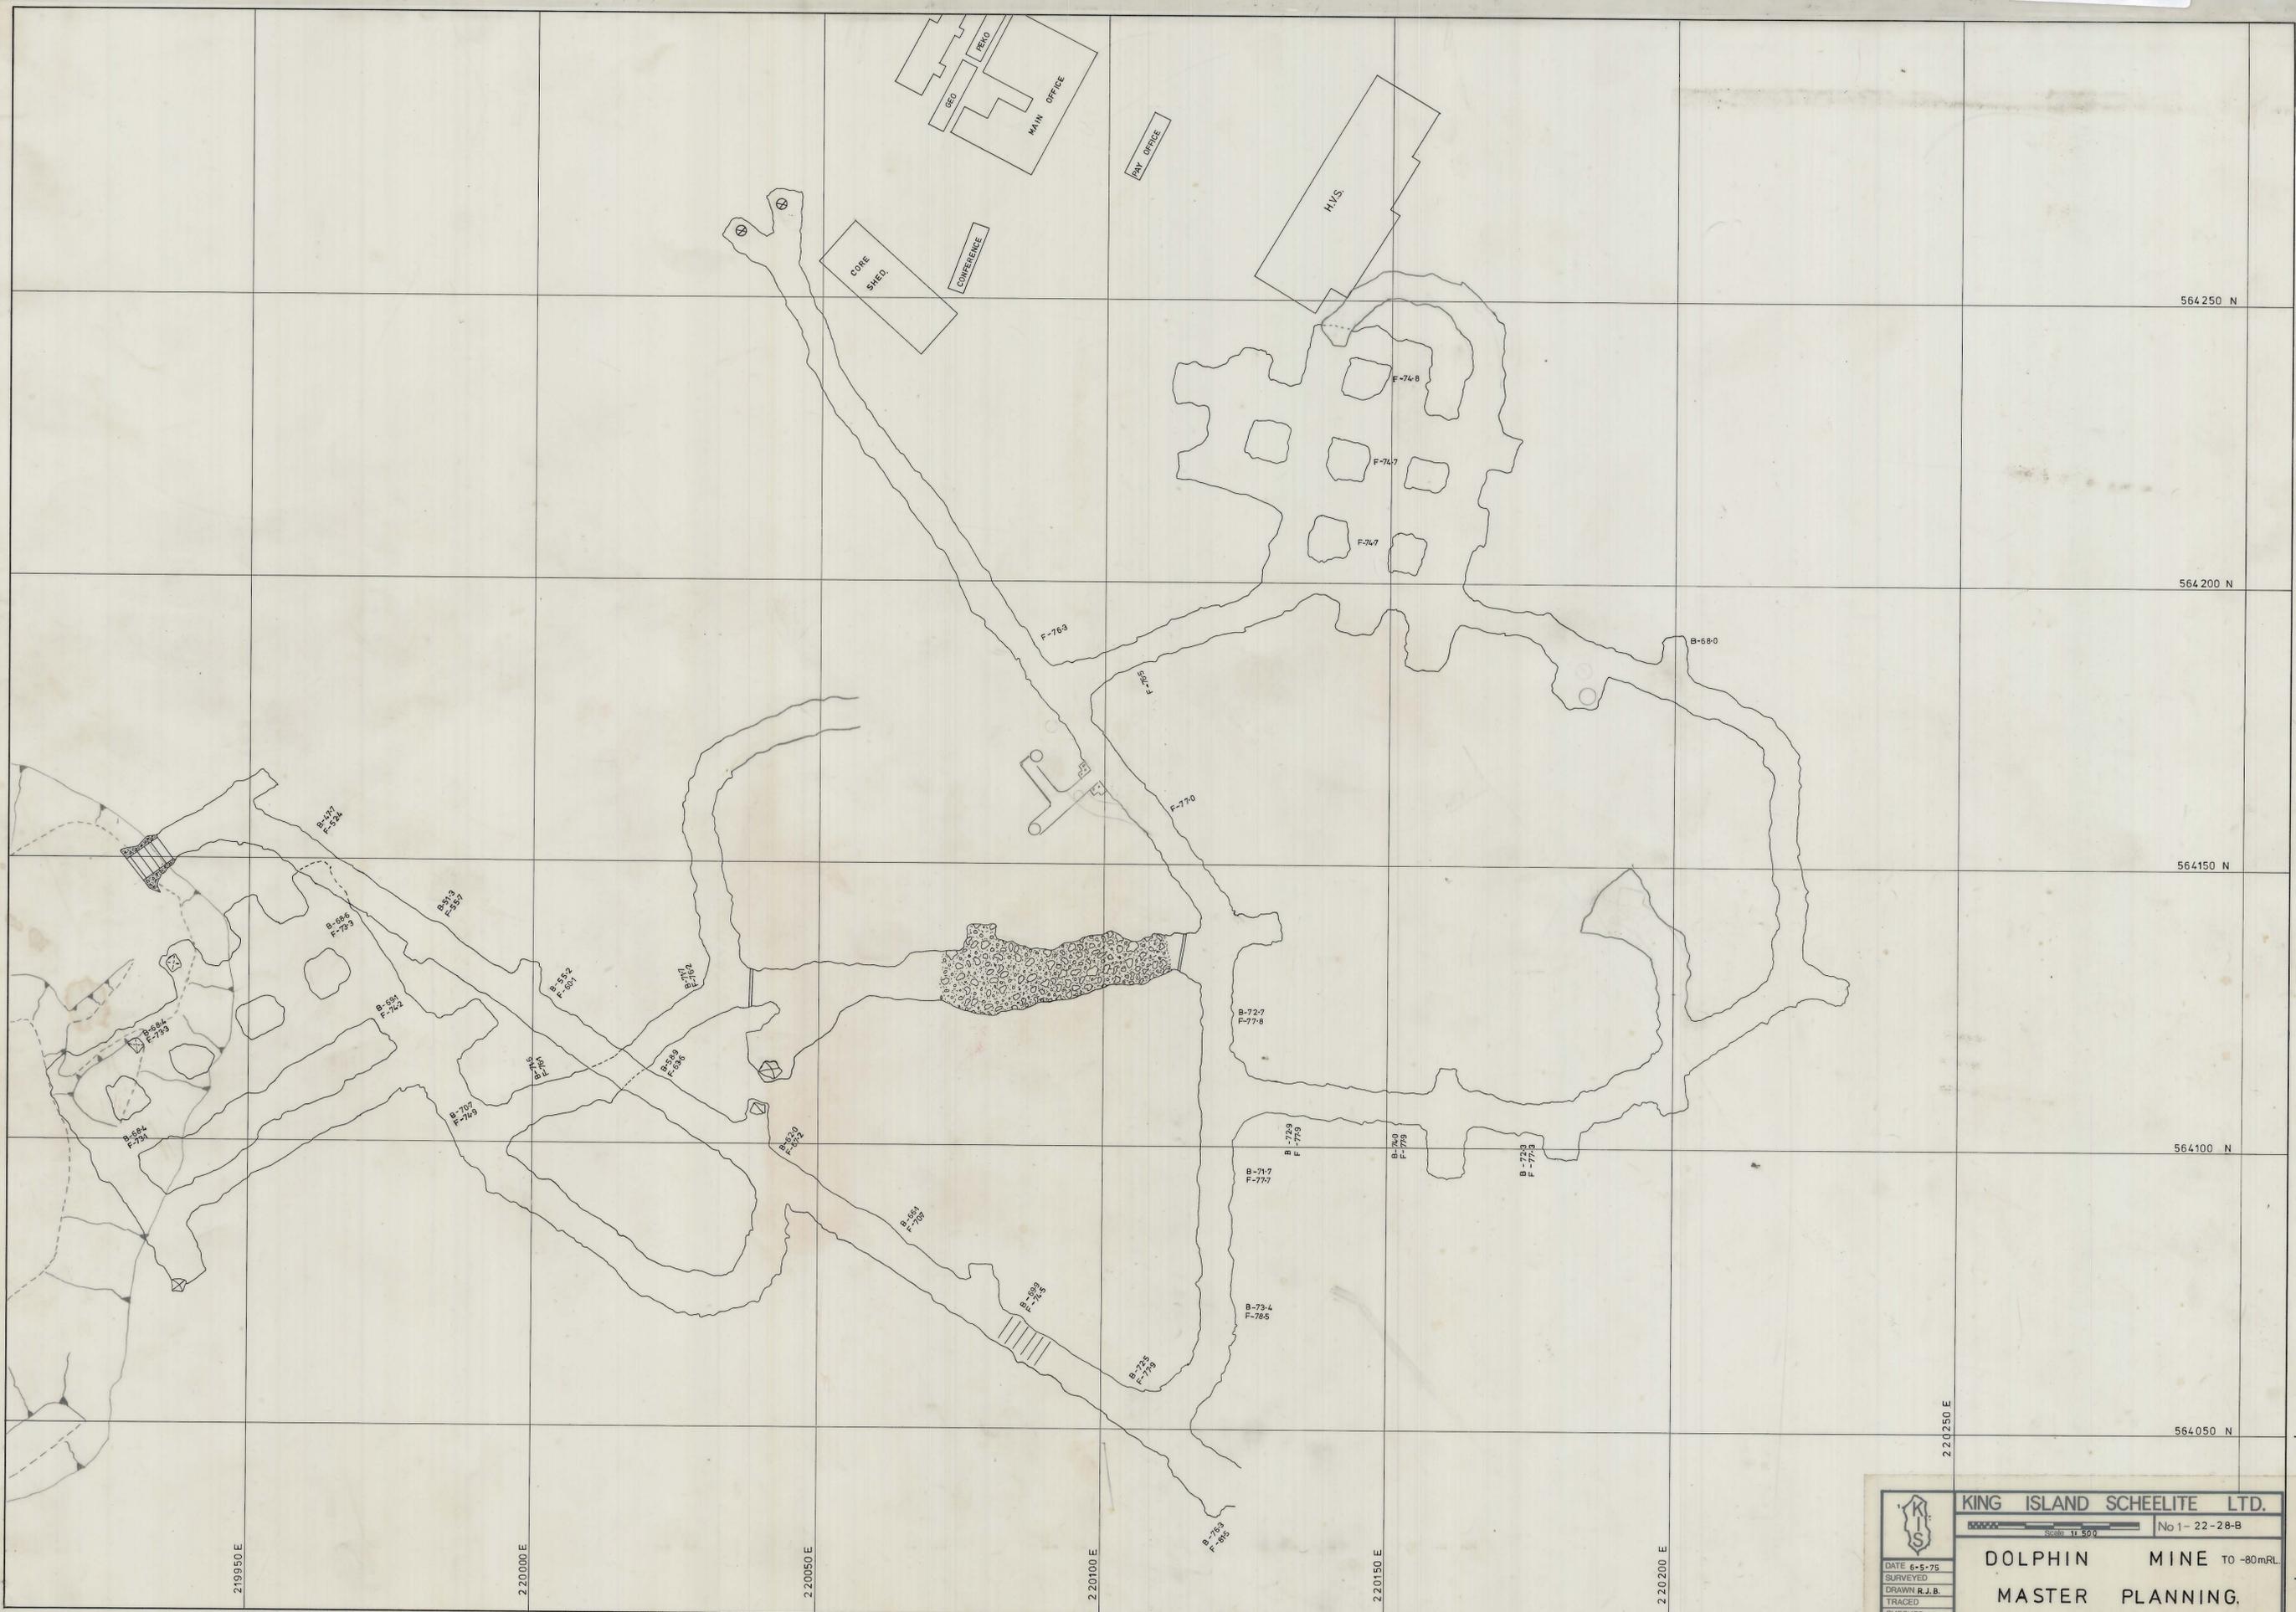

22  
21  
20  
19  
18  
17  
16  
15  
14  
13  
12

**KING ISLAND SCHEELITE LTD.**  
 No 1-22-28-B  
**DOLPHIN MINE TO -80mRL**  
**MASTER PLANNING.**

DATE 6-5-75  
 SURVEYED  
 DRAWN R.J.B.  
 TRACED  
 CHECKED R.Z.