
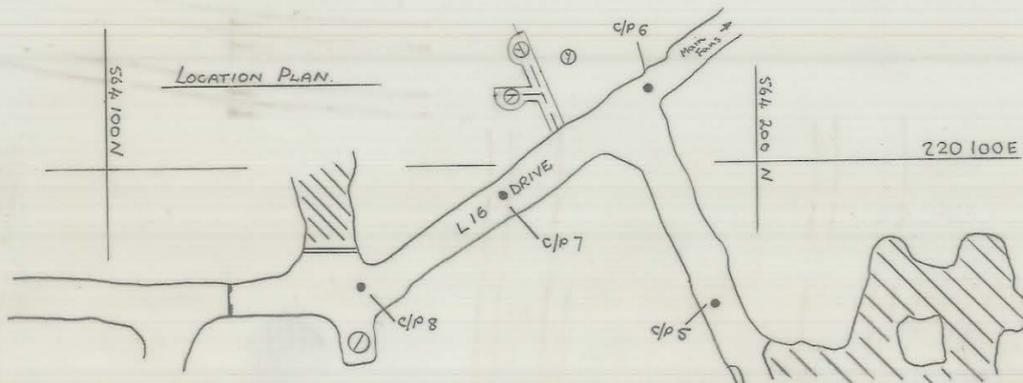


5 cm

03 DM 08 - 3008

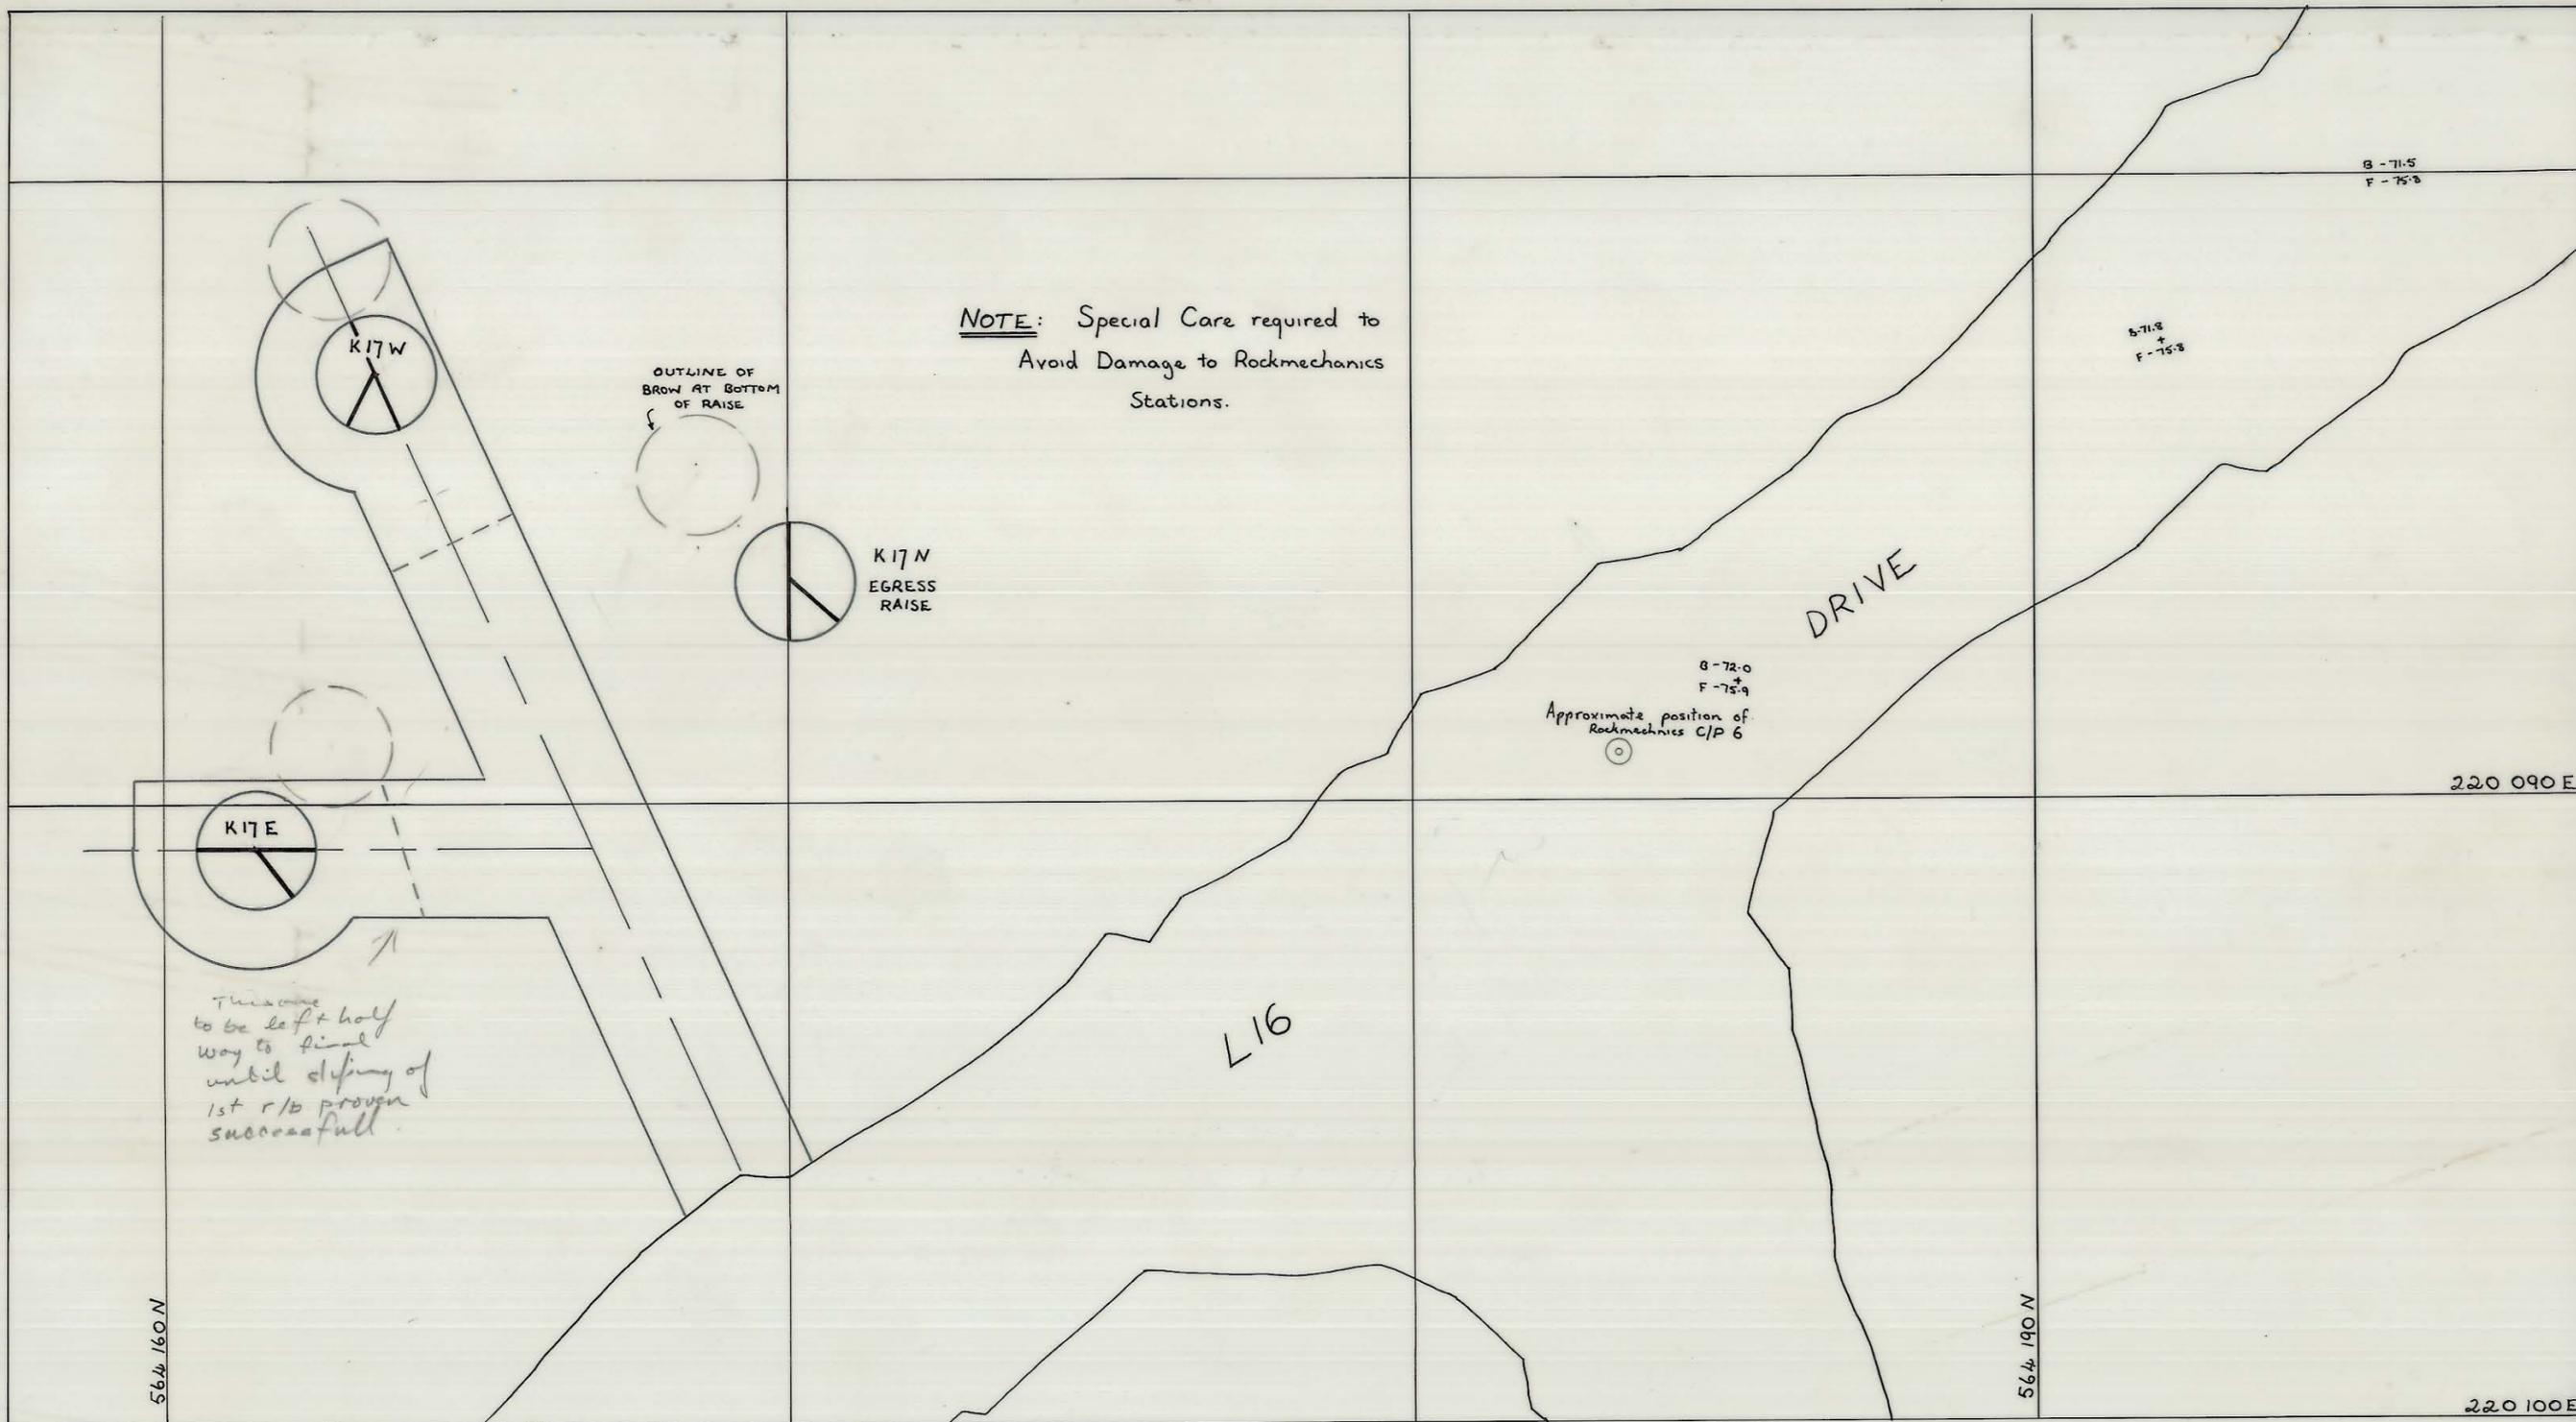

KING ISLAND SCHEELITE		APPROVAL	COPY
DATE: 7 JULY 1977	SCALE: 1:100	PLANNING ENG.:	
MINE: DOLPHIN	DWG/NO.: 03 DM 08 3008	SENIOR PLAN. ENG.:	
PROPOSED LAYOUT OF: X/CUT FOR SLYPING K17 PUMP RAISES (2.3m x 2.2)		MINE SUPT.:	3
		G. MINING SUPT.:	
PRELIMINARY		SENIOR SURV'R.:	
		SENIOR GEOLOGIST:	
FINAL		SURVEYOR:	