


5 cm

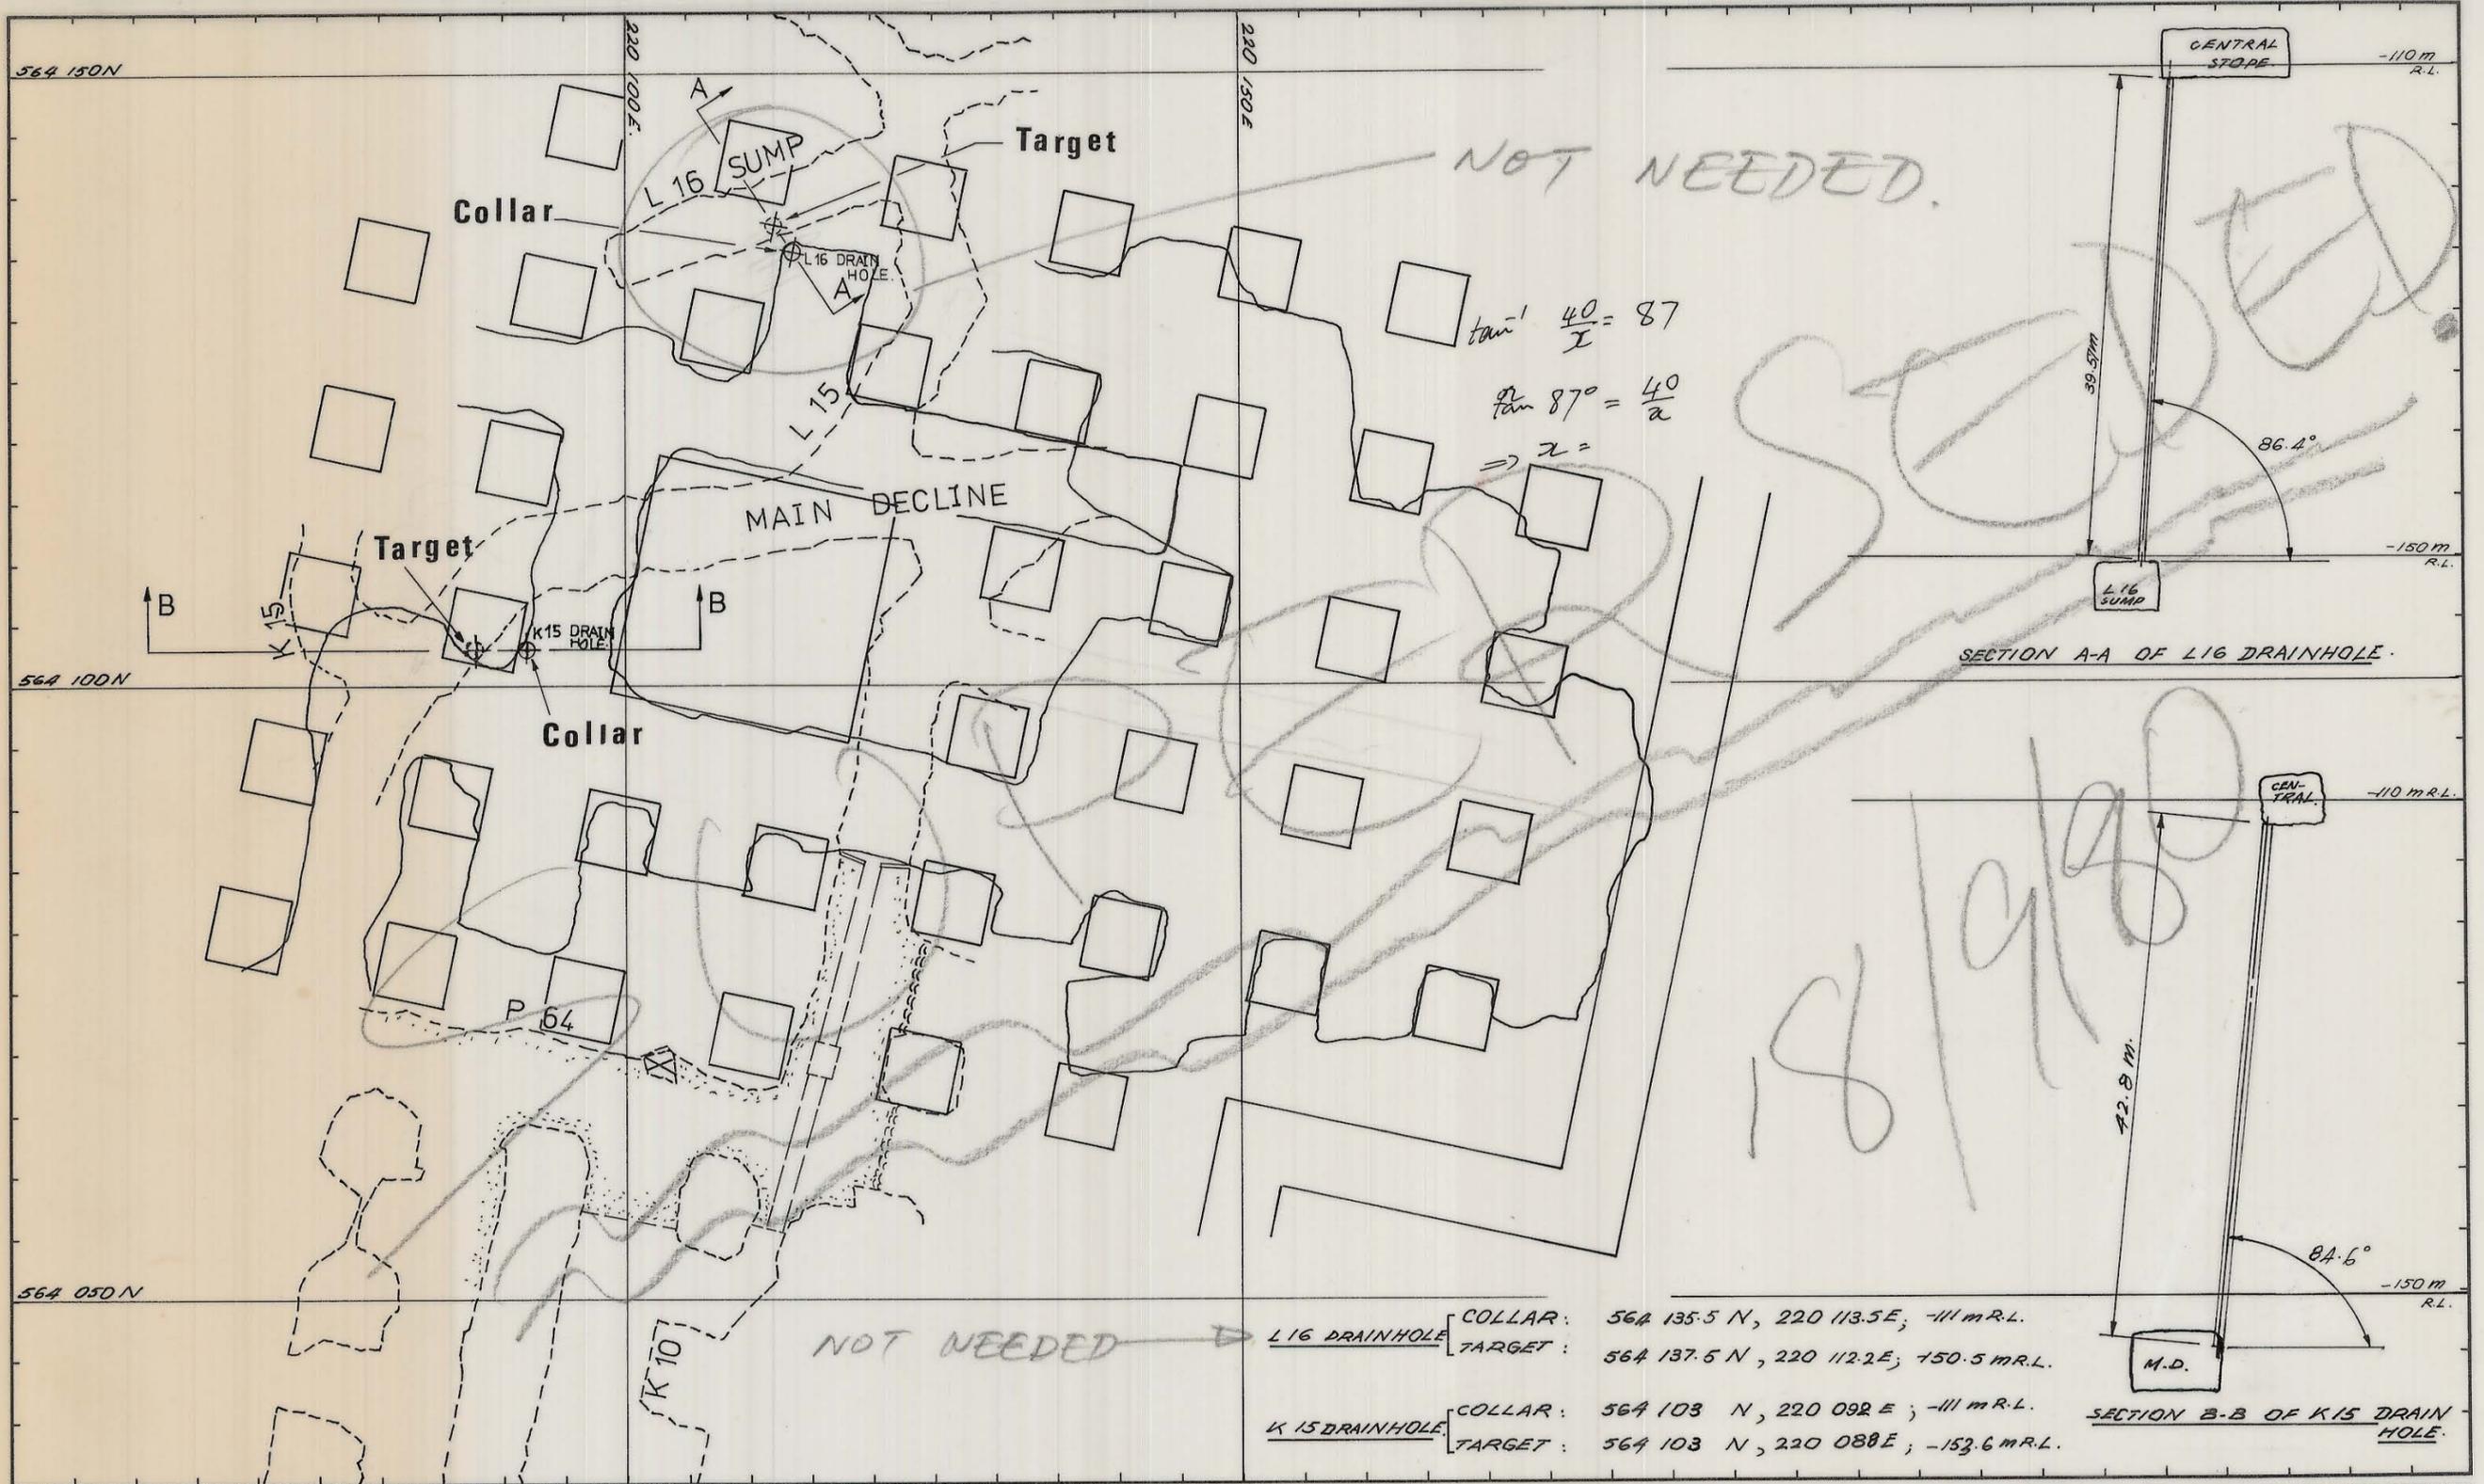

L16 DRAINHOLE COLLAR: 564 135.5 N, 220 113.5 E, -111 m R.L.
 TARGET: 564 137.5 N, 220 112.2 E, -150.5 m R.L.
 K15 DRAINHOLE COLLAR: 564 103 N, 220 092 E, -111 m R.L.
 TARGET: 564 103 N, 220 088 E, -152.6 m R.L.

REF PLAN	GEOLOGY		SCALE 1: 500	KING ISLAND SCHEELITE GRASSY KING ISLAND
	SURVEY			
	PLANNING	P.B. 2/9/81		
	ROCK MEC.			
	MINING SUPR.			
	GENERAL MINING SUPR.			
T.S.S.			DRAWING NUMBER	03DM08-3013

DOLPHIN MINE.
 DRAINHOLES, L16 & K15, FROM
 CENTRAL AREA.