


0374_3288

03 DM08 - 4008

5 cm

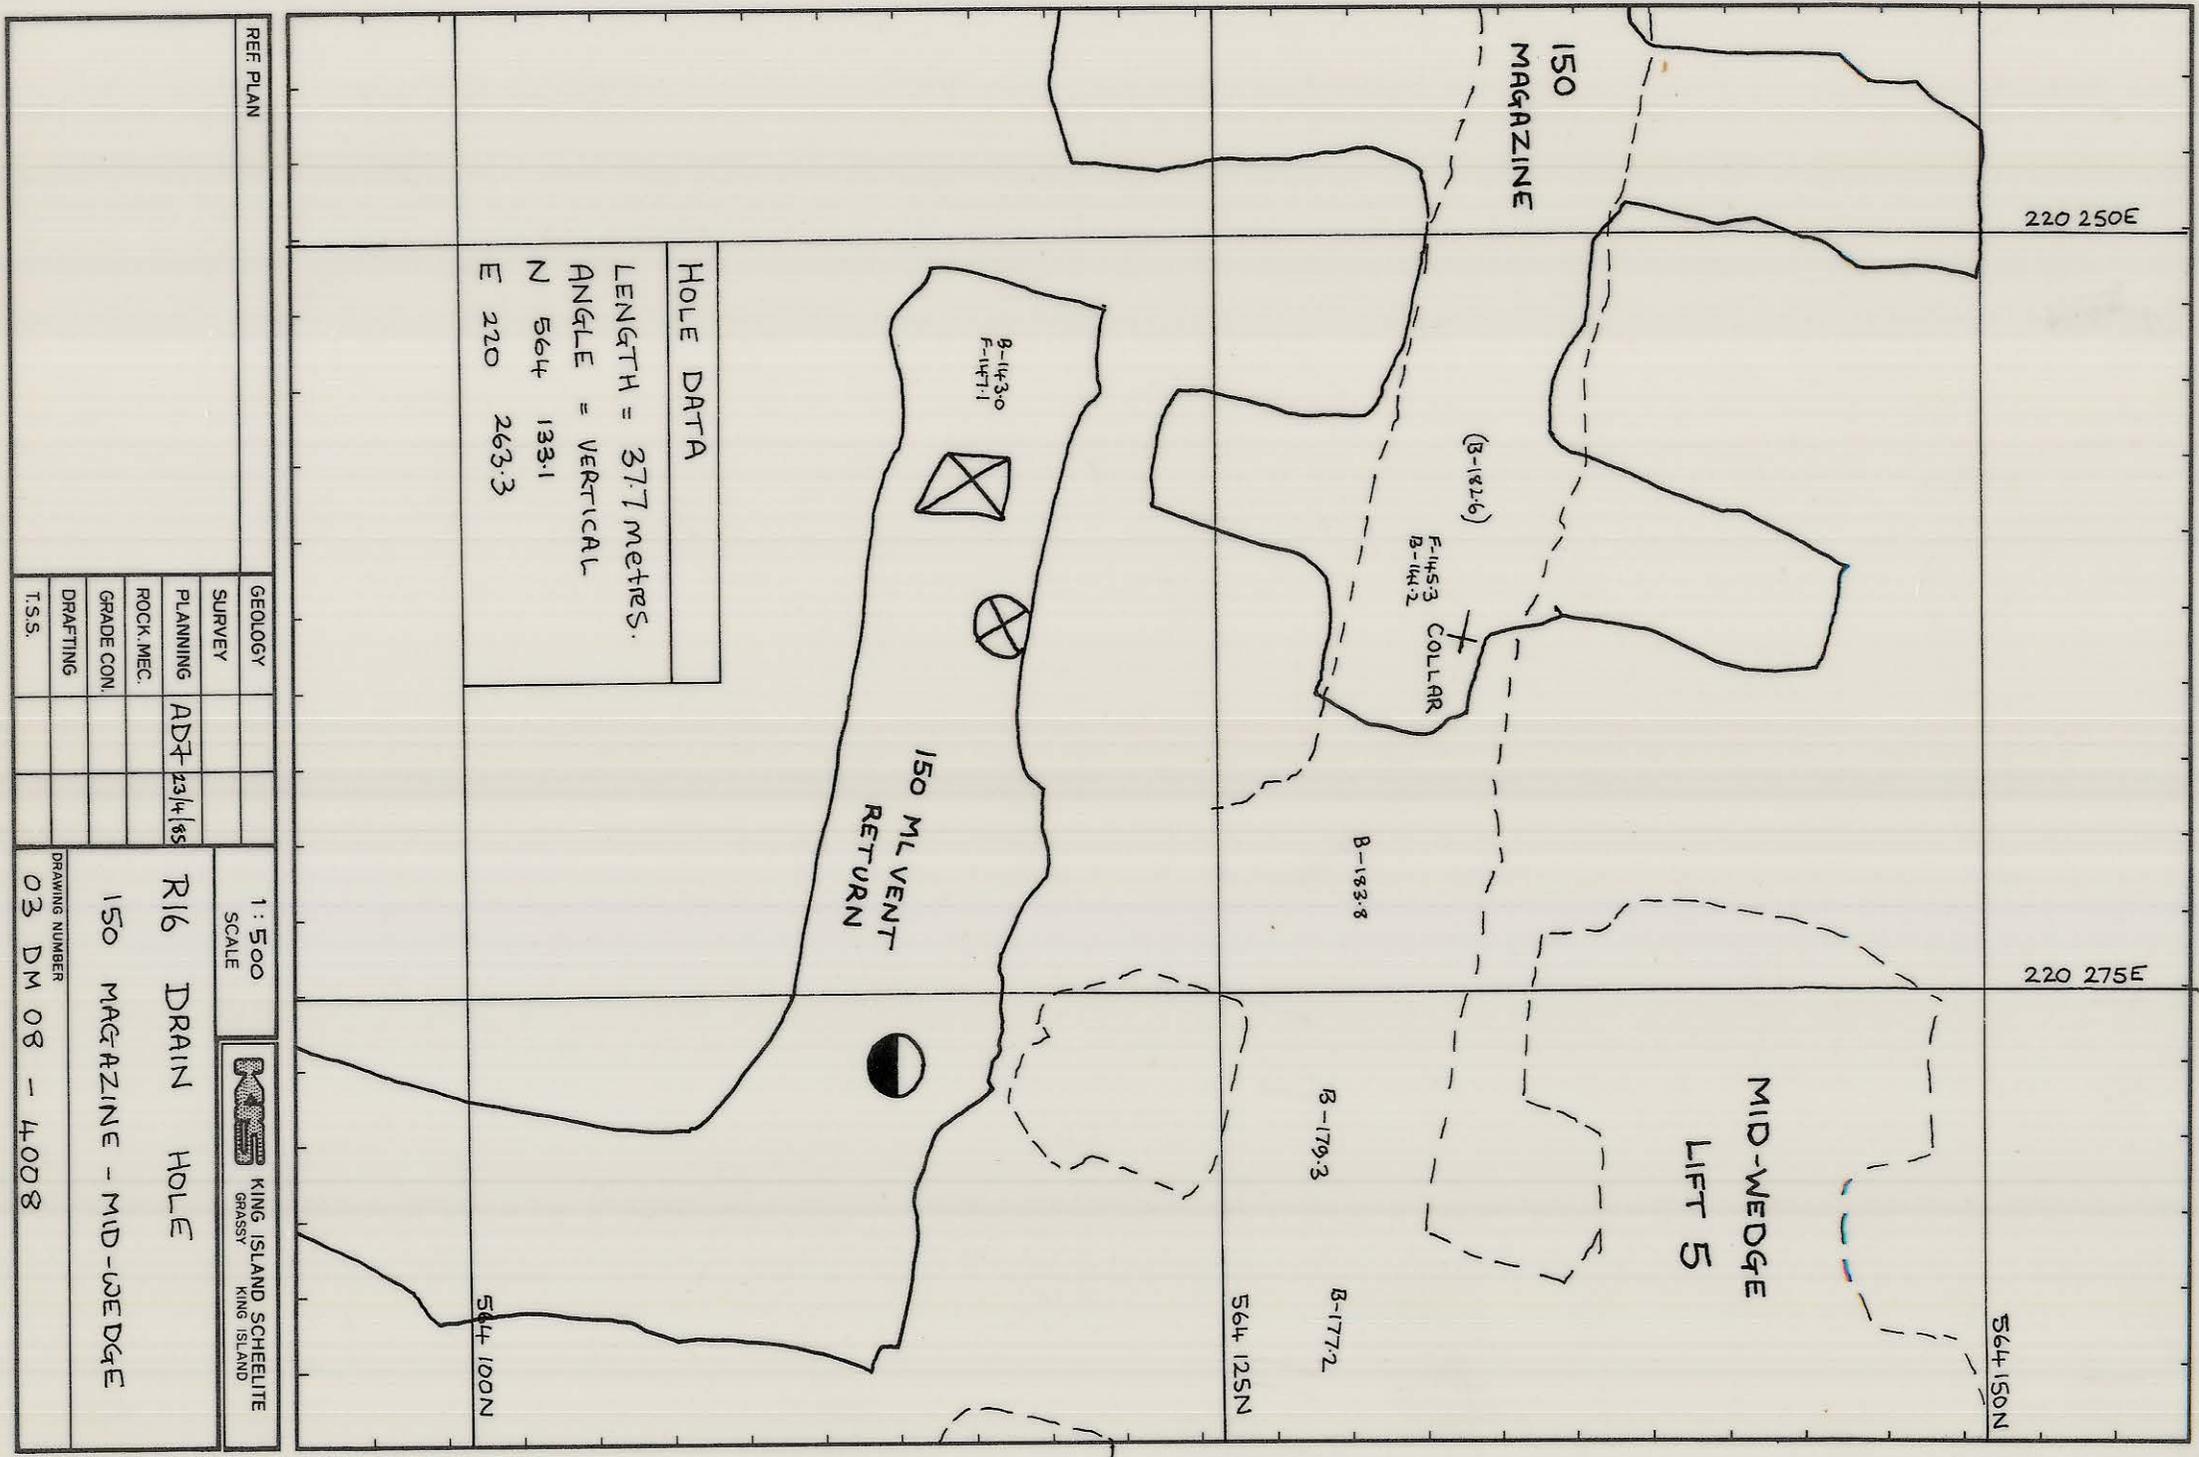

HOLE DATA

LENGTH = 37.7 metres.
 ANGLE = VERTICAL
 N 564 133.1
 E 220 263.3

REF PLAN

GEOLOGY	
SURVEY	
PLANNING	ADT 23/4/85
ROCK. MEC.	
GRADE CON.	
DRAFTING	
T.S.S.	

1 : 500
 SCALE



KING ISLAND SCHEELITE
 GRASSY KING ISLAND

R16 DRAIN HOLE

150 MAGAZINE - MID-WEDGE

DRAWING NUMBER
 03 DM 08 - 4008