


03DM08-4002

0374\_3293

5 cm

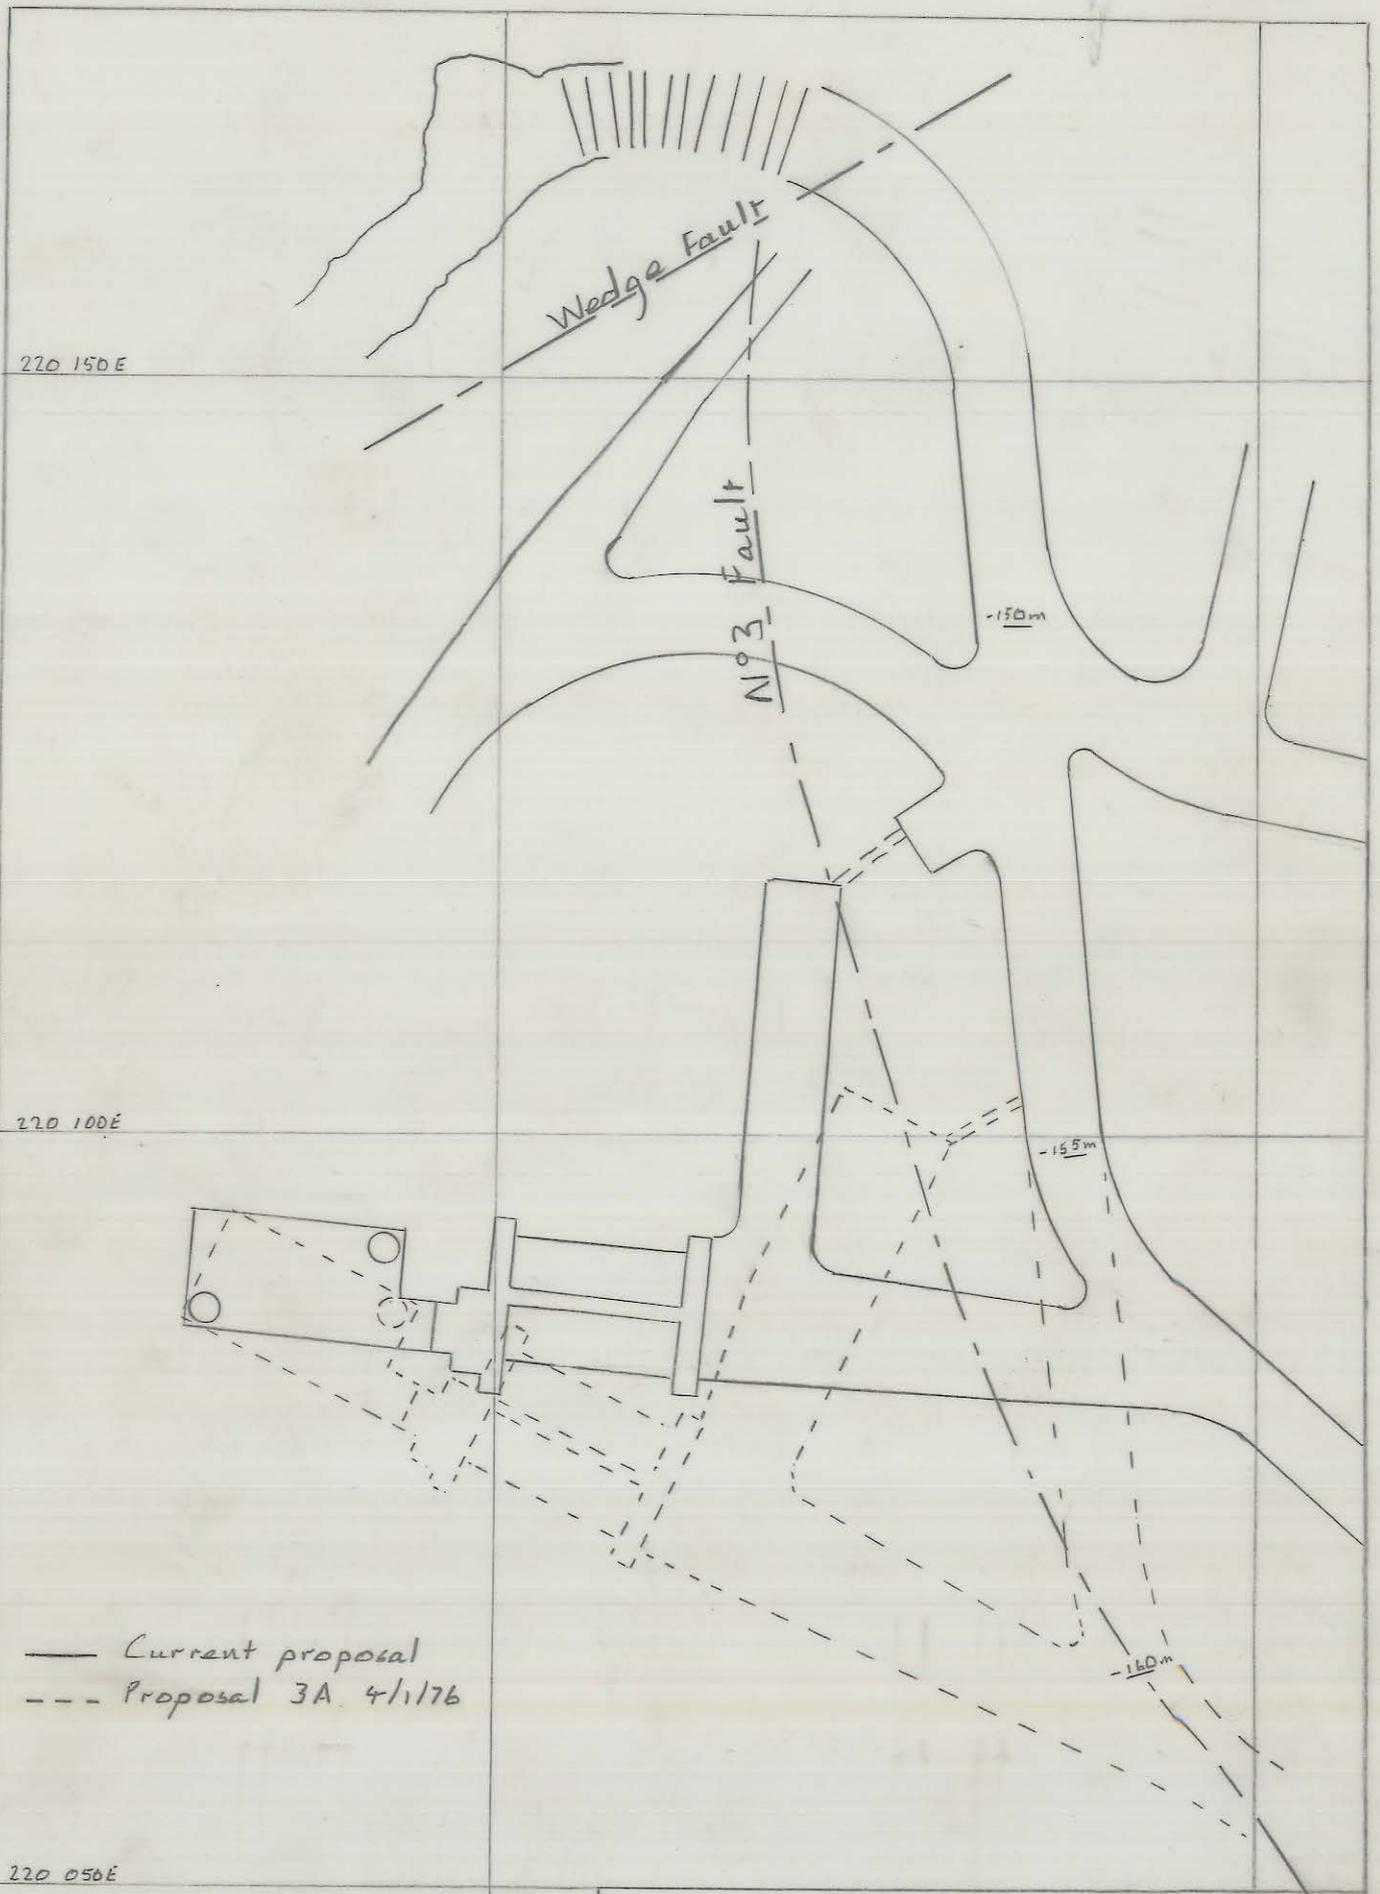

— Current proposal  
 --- Proposal 3A 4/1/76

GENERAL LAYOUT OF SUMP AREA  
 Showing locations of major faults  
 Dolphin Mine Emergency Pumping Scheme  
 J.H.K. 16/2/76      Scale 1:500