


5 cm

0374\_3303

03DM08-3019

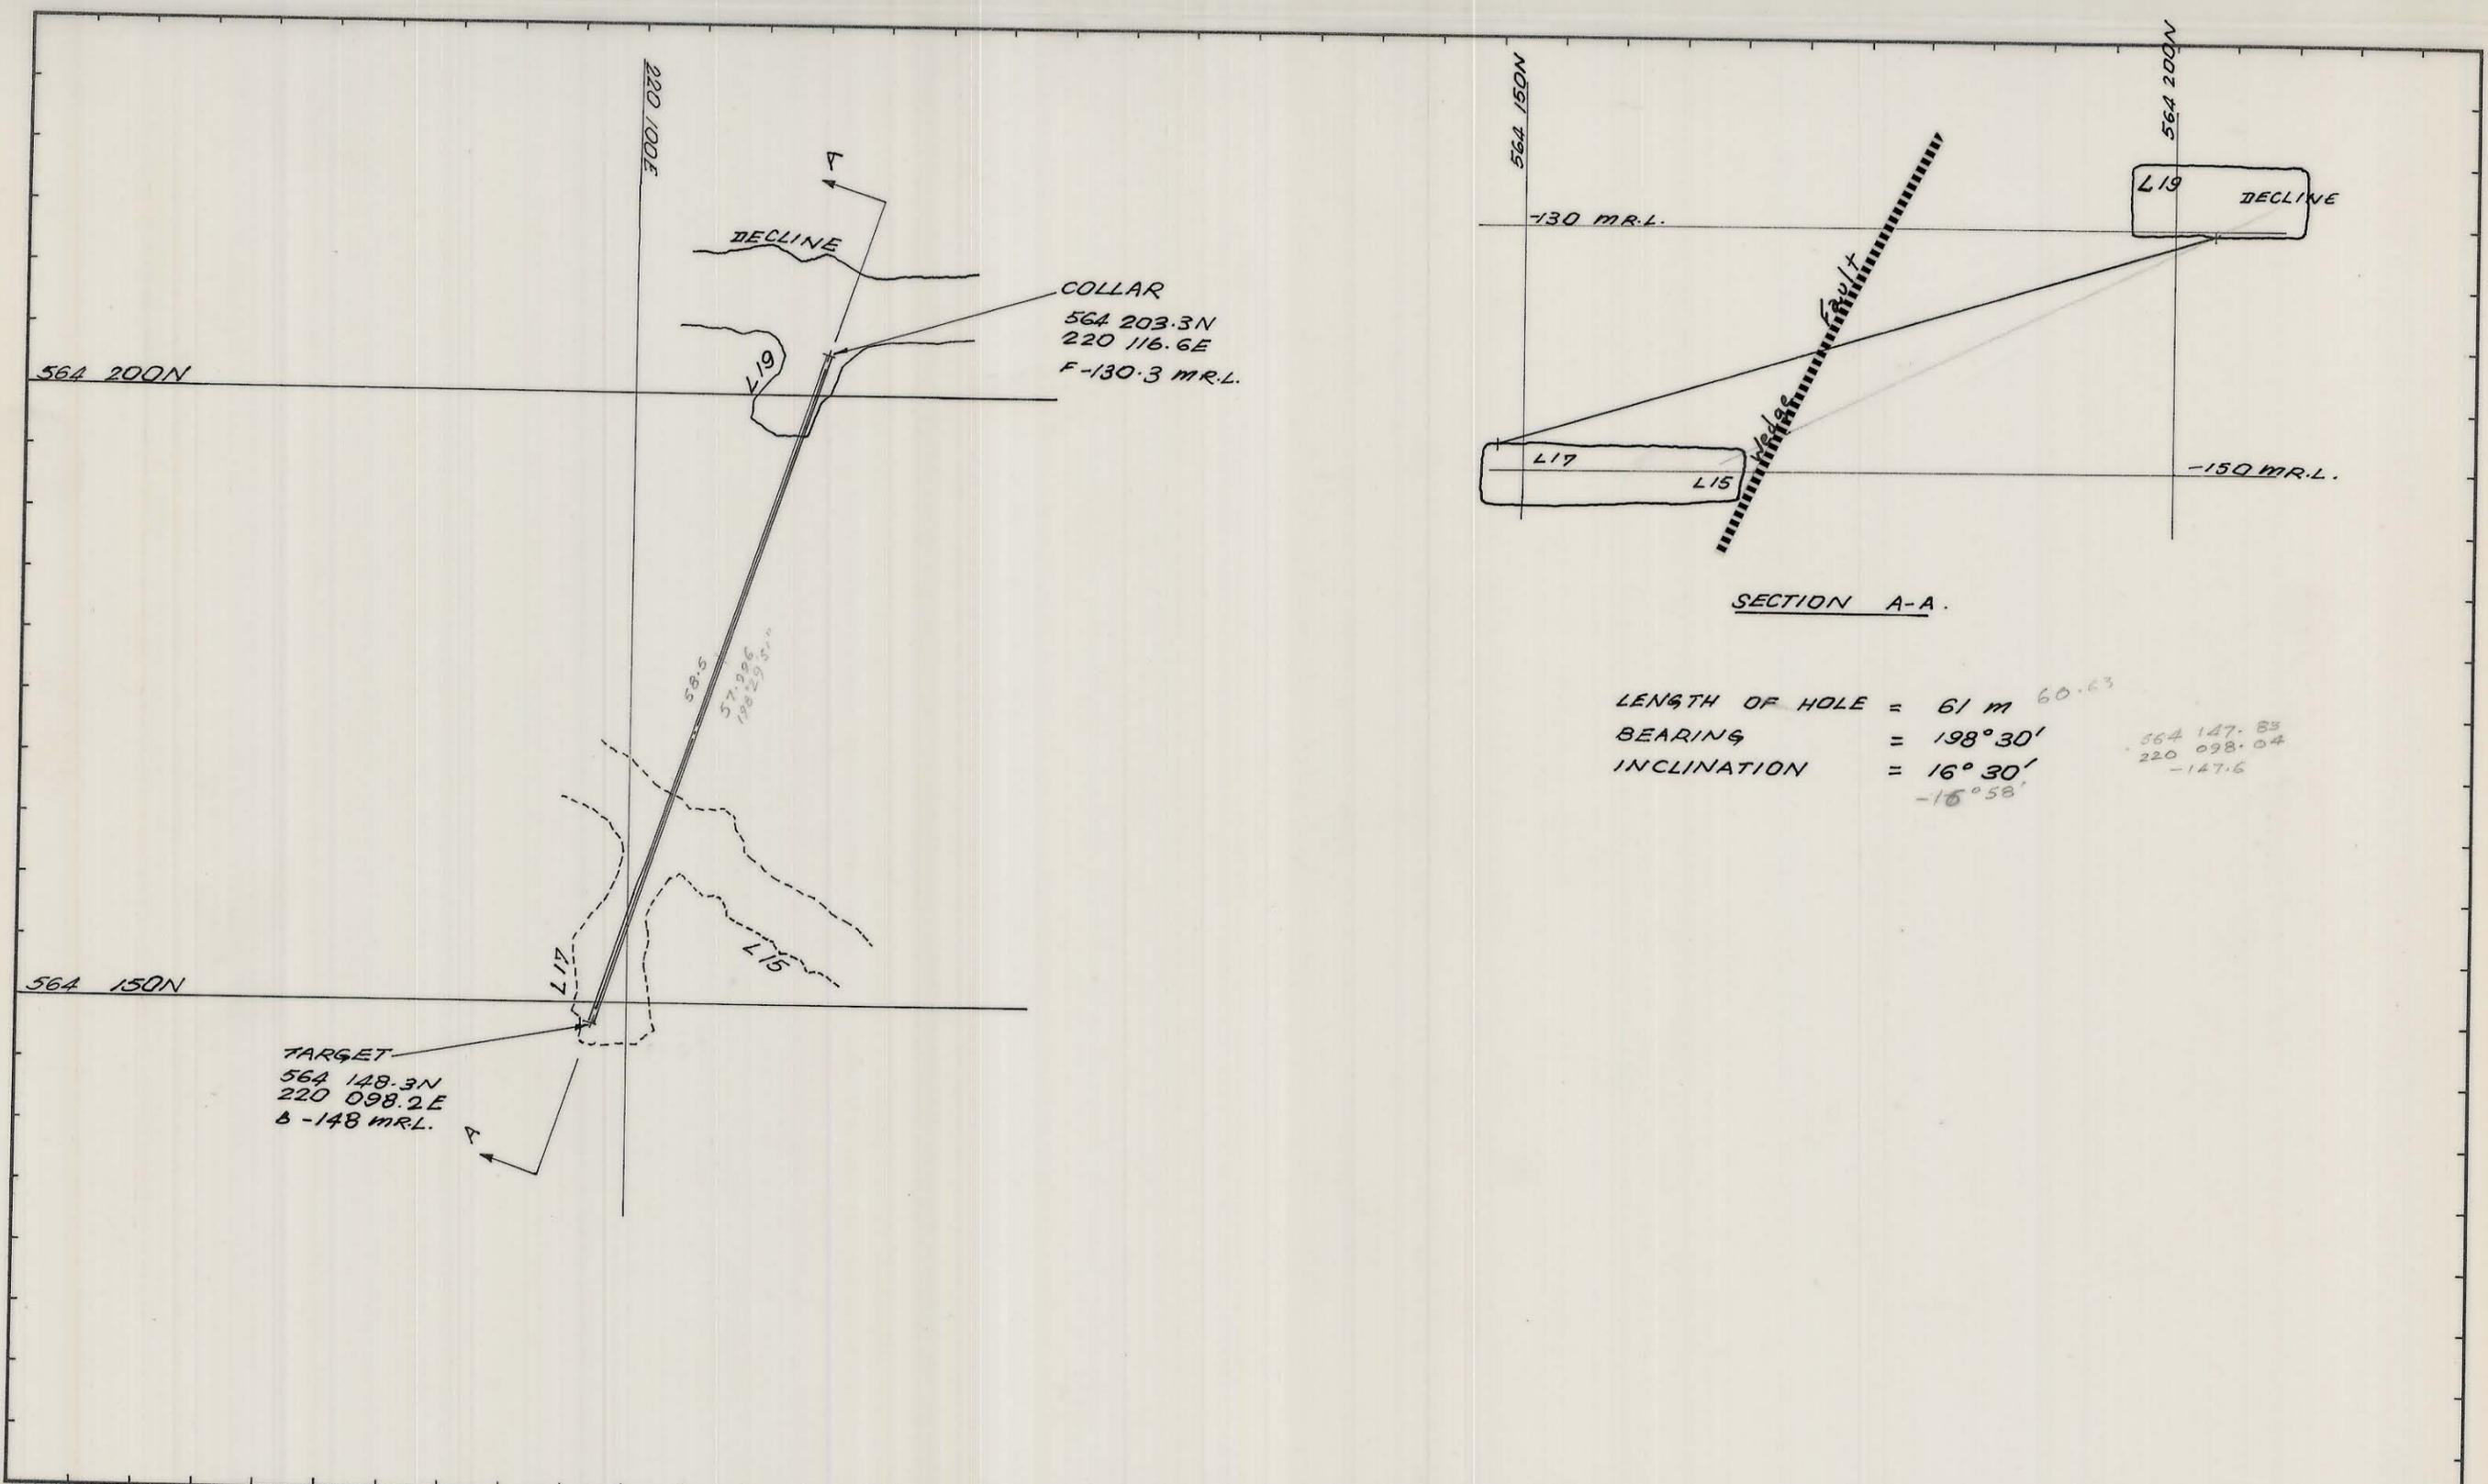

REF. PLAN 04DM1A-1040, 04DM1A-1050

GEOLOGY	<i>JK.</i>	9-9-82
SURVEY		
PLANNING	<i>AB</i>	27-8-82
ROCK MEC.	<i>AW</i>	9-9-82
MINES SUPT.		
G.M.S.		
T.S.S.		

SCALE 1: 500

**KS** KING ISLAND SCHEELITE  
GRASSY KING ISLAND

**DOLPHIN MINE**  
DRAINHOLE FROM L19 TO L17

DRAWING NUMBER  
03DM08-3019