


03DM12-1003

0374_3310

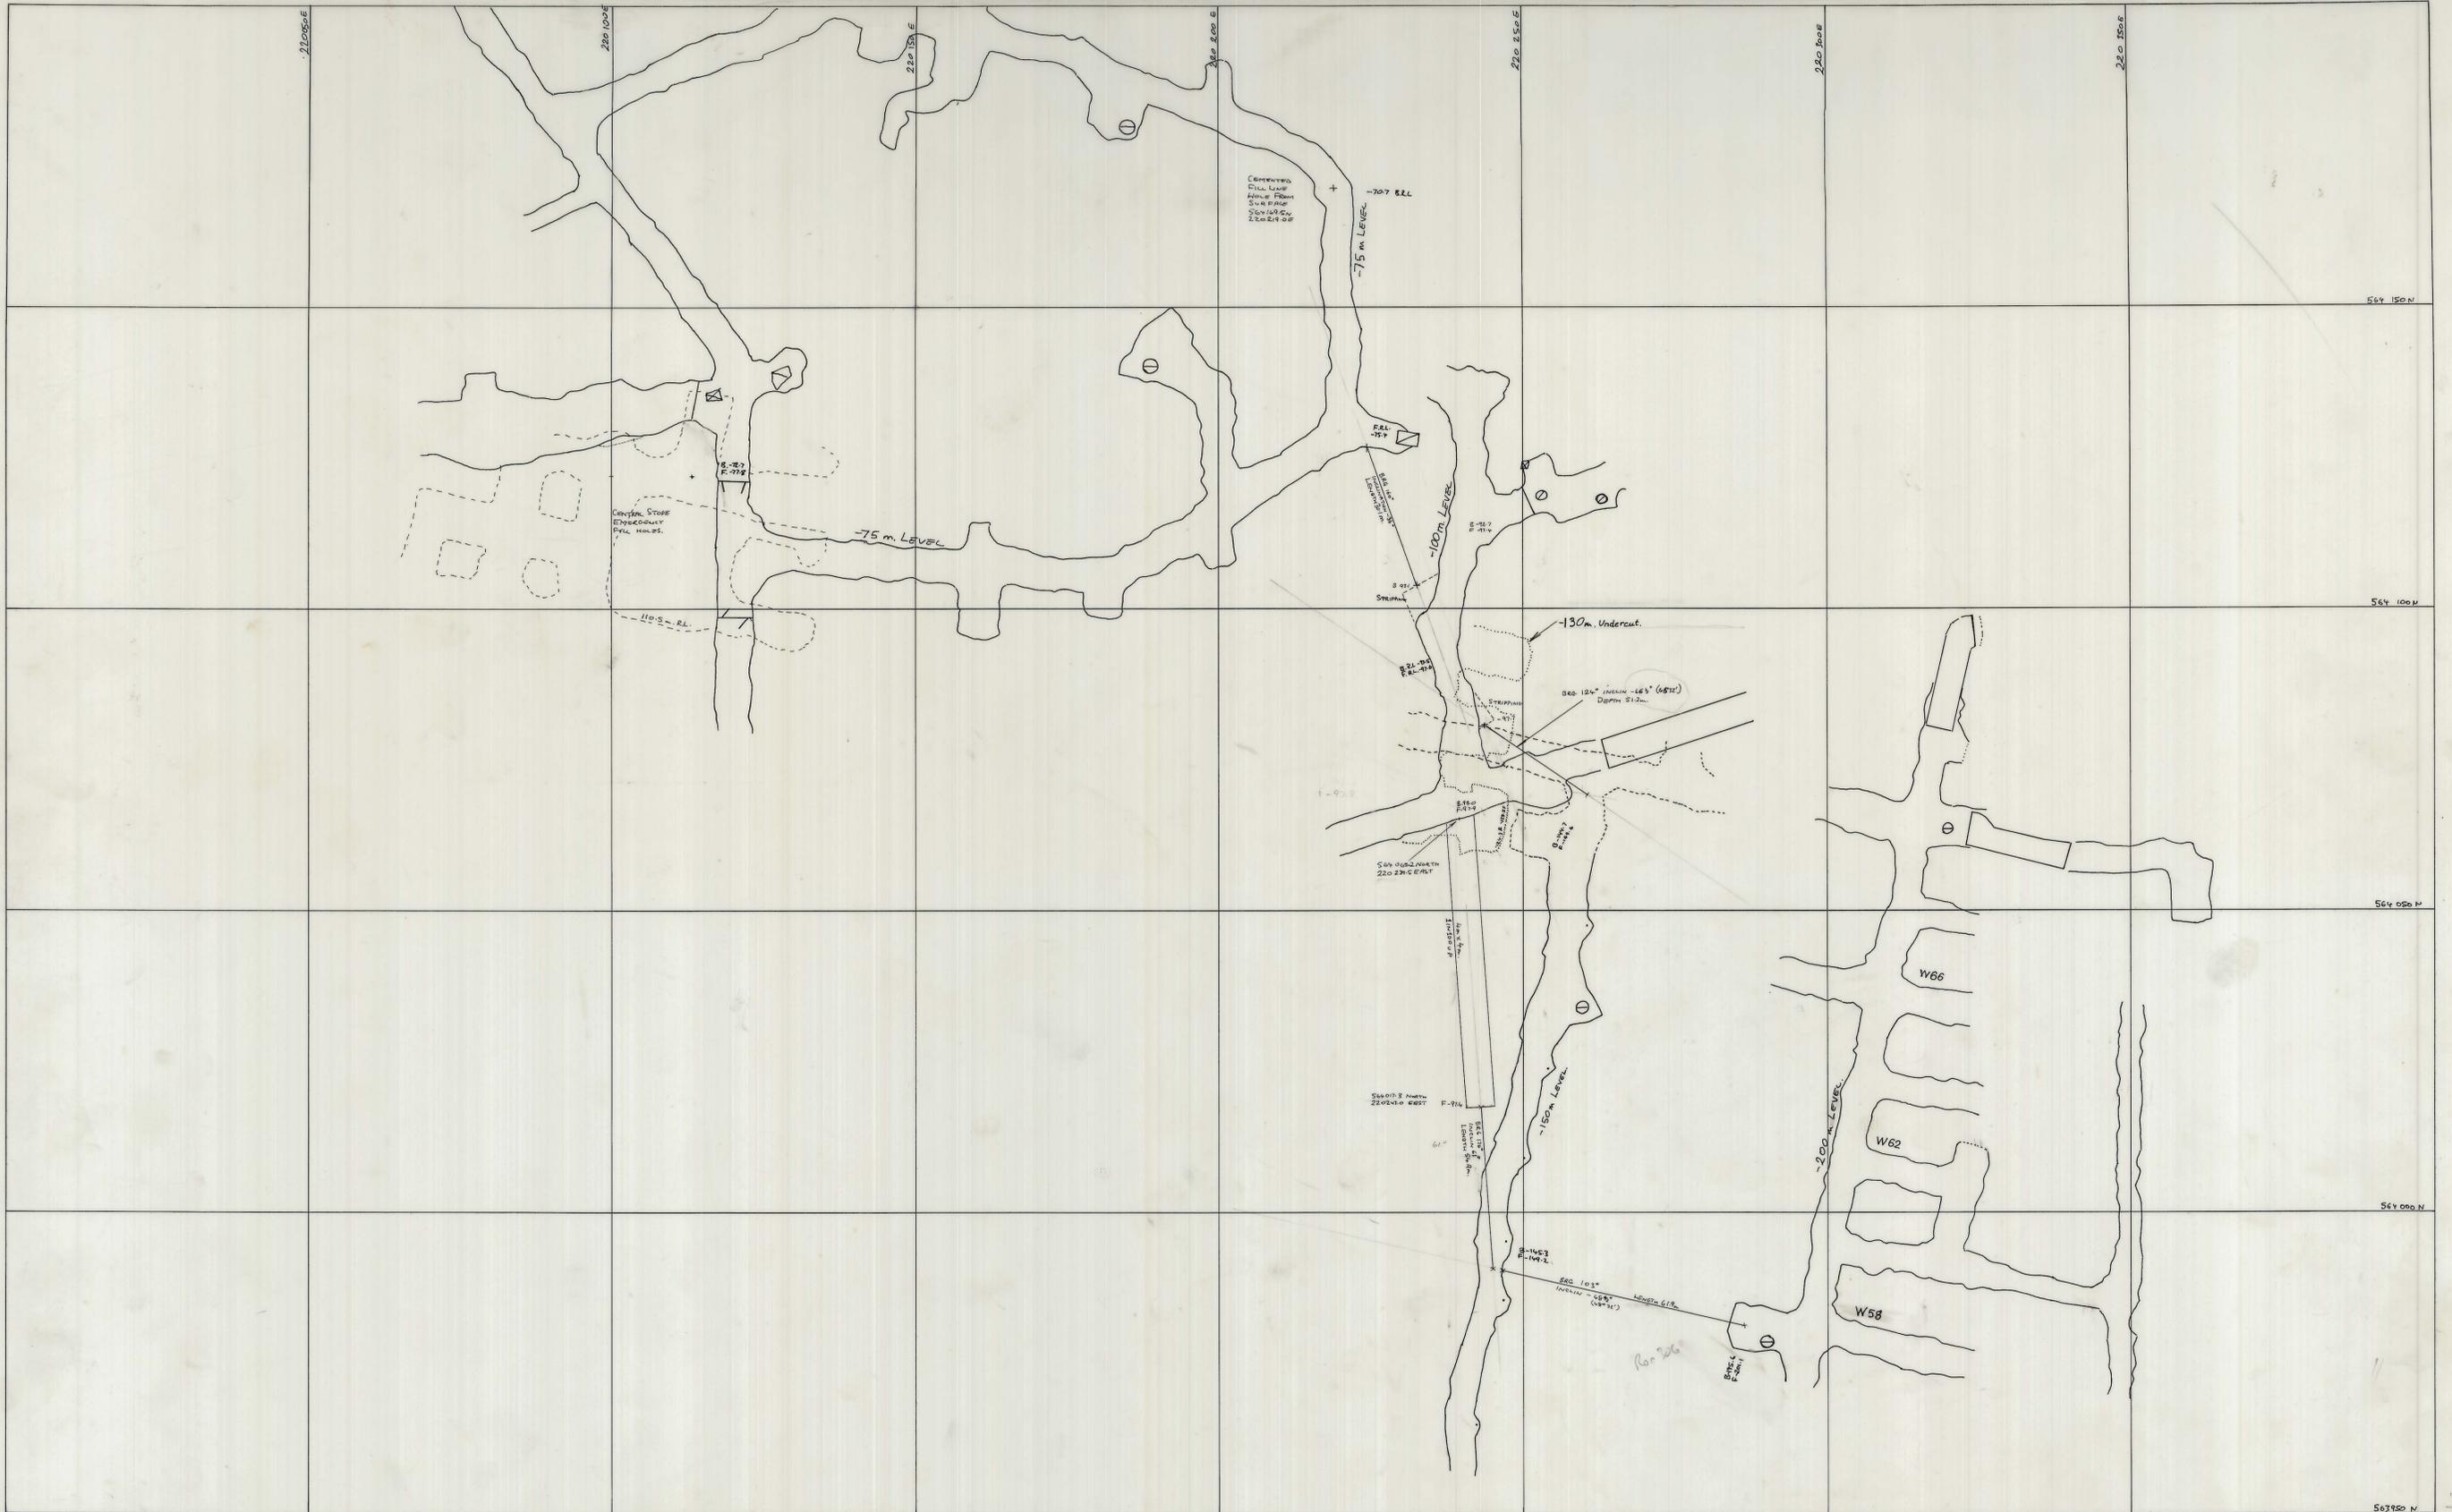

DRAWING	W.S.	26/6/81
DESIGNED	W.S.	7/7/81
DRAWN	W.S.	16/8/81
CHECKED	W.S.	8/12/81
UTS	W.S.	10/3/81
FILED	W.S.	

SCALE 1:500



LOCATION
DOLPHIN MINE

SUBJECT
CEMENTED SAND FILL LINE
-75m. LEVEL TO -200m. LEVEL.
EMERGENCY FILL HOLDS FOR
CENTRAL SHAFT.

W. Brown 26/6/81

KIS KING ISLAND SCHEELITE
A DIVISION OF HARMAN INTERNATIONAL

GRASSY KING ISLAND

PLAN NUMBER
03DM12 - 1003