
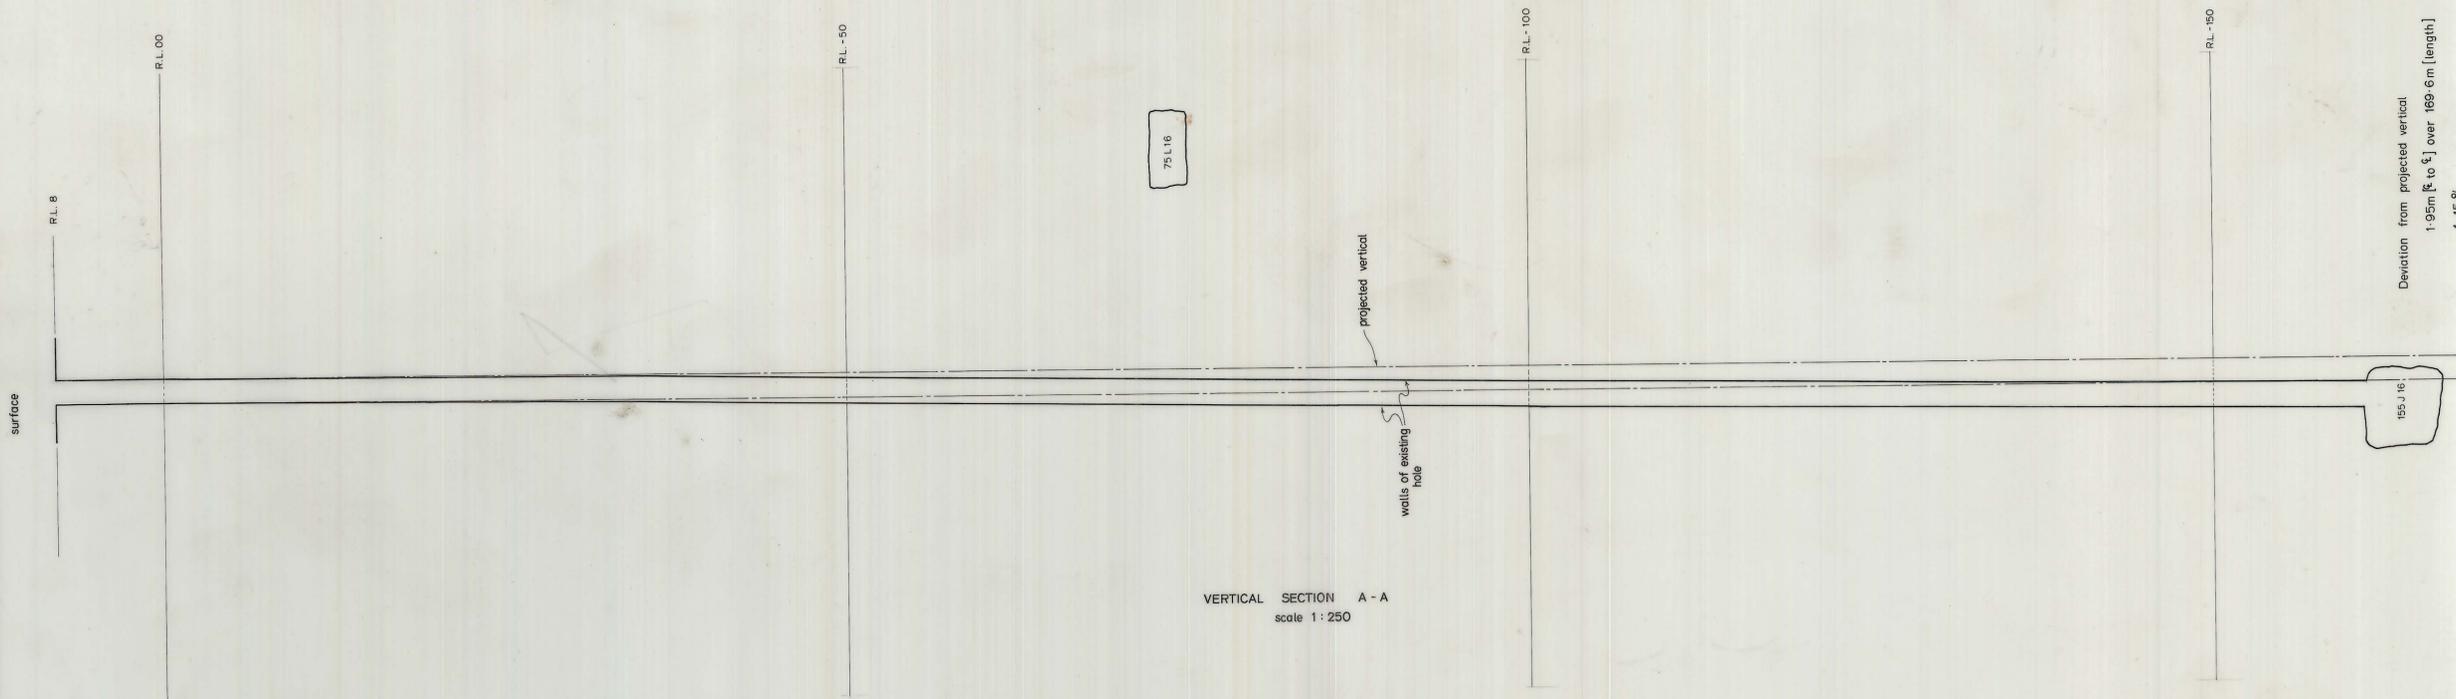


03DM08-1012

0374_3311

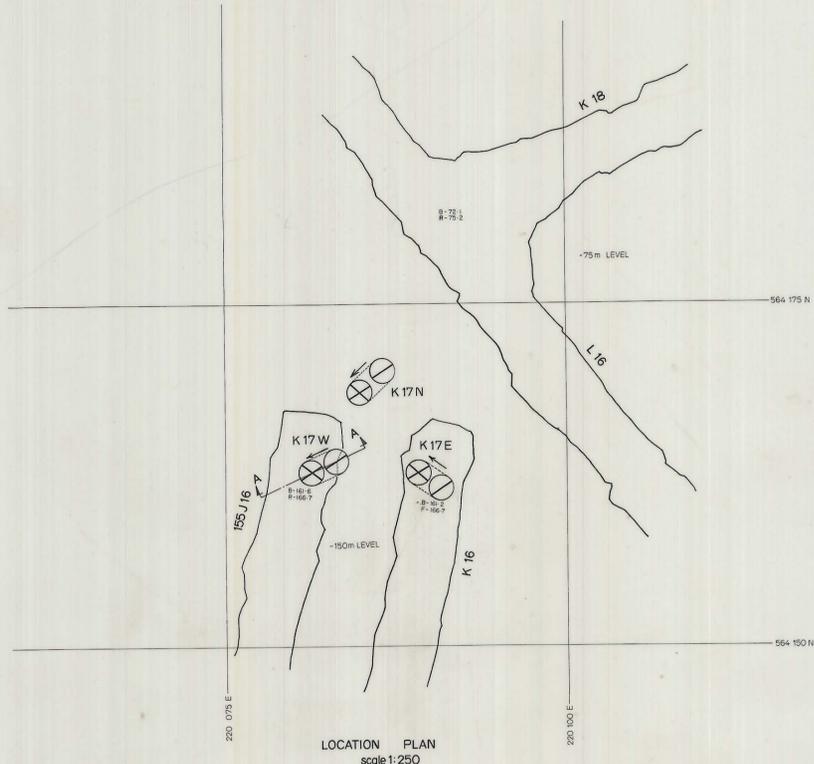

Deviation from projected vertical
1.95m [to 5] over 169.6m [length]
1:15 %
00° 39' 30"

SCALE See Above

LOCATION DOLPHIN PUMPING SCHEME

SUBJECT

K 17 WEST RISE

north



GRASSY KING ISLAND

PLAN NUMBER

03DM08 - 1012