


03 DM 16 - 4007

0374_3317

5 cm

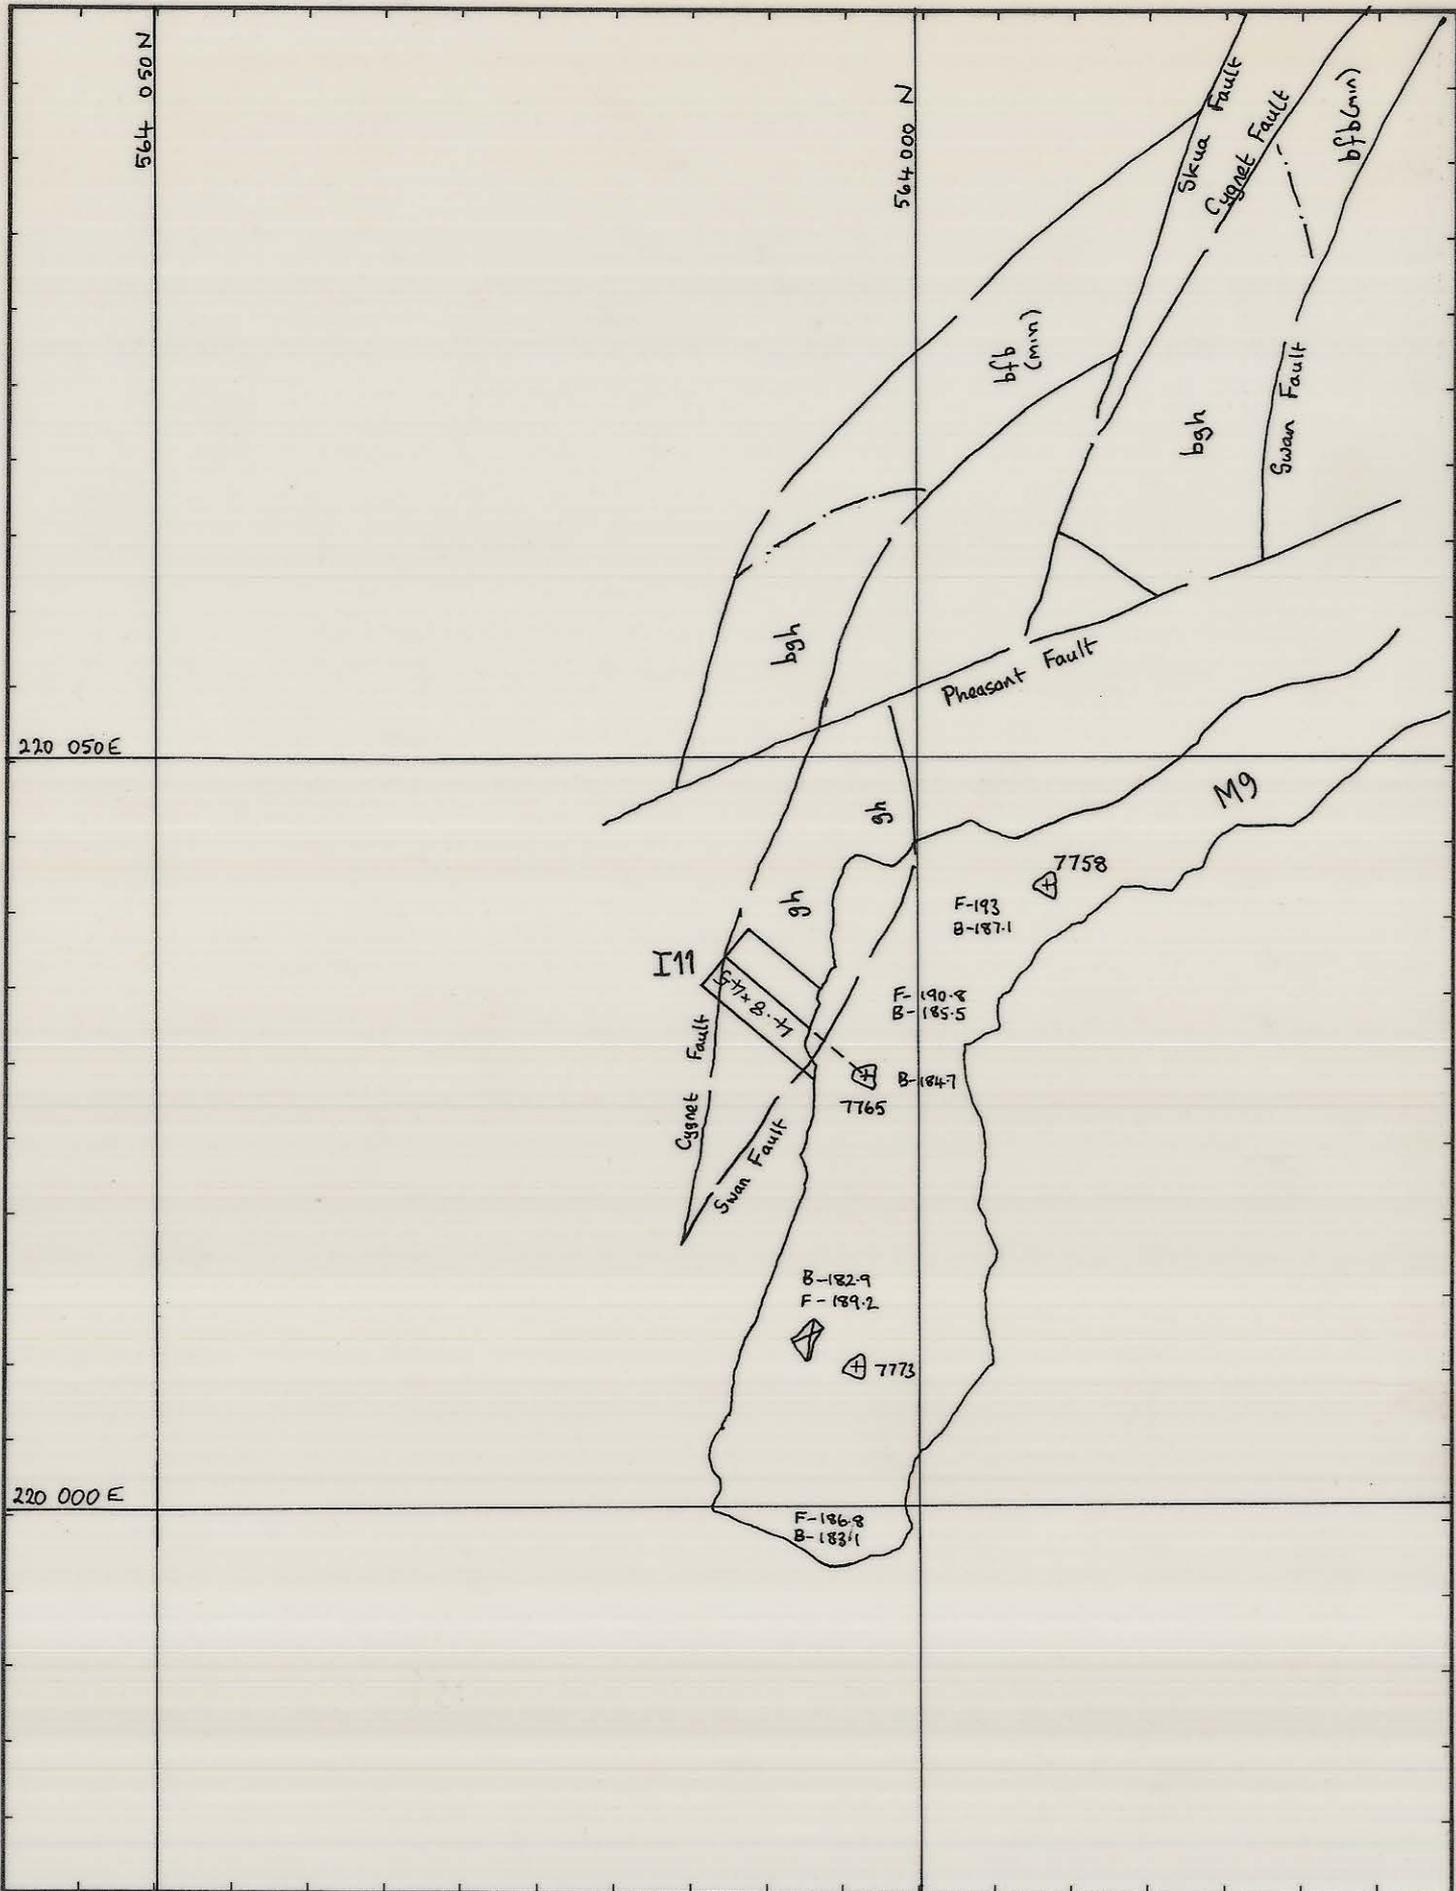

| | | | | | | |
|-----------|-------------------|--------|------------|------------|------------------|---|
| REF. PLAN | <i>Mast 10/84</i> | | GEOLOGY | | 1 : 500 SCALE | |
| | | | SURVEY | | | |
| | | | PLANNING | <i>ADJ</i> | <i>19.9.84</i> | DODO / PIT DAG EXPLORATORY I 11 X- CUT |
| | | | ROCK.MEC. | | | |
| | | | GRADE CON. | | | |
| | | | DRAFTING | | | |
| | | T.S.S. | | | DRAWING NUMBER | |