
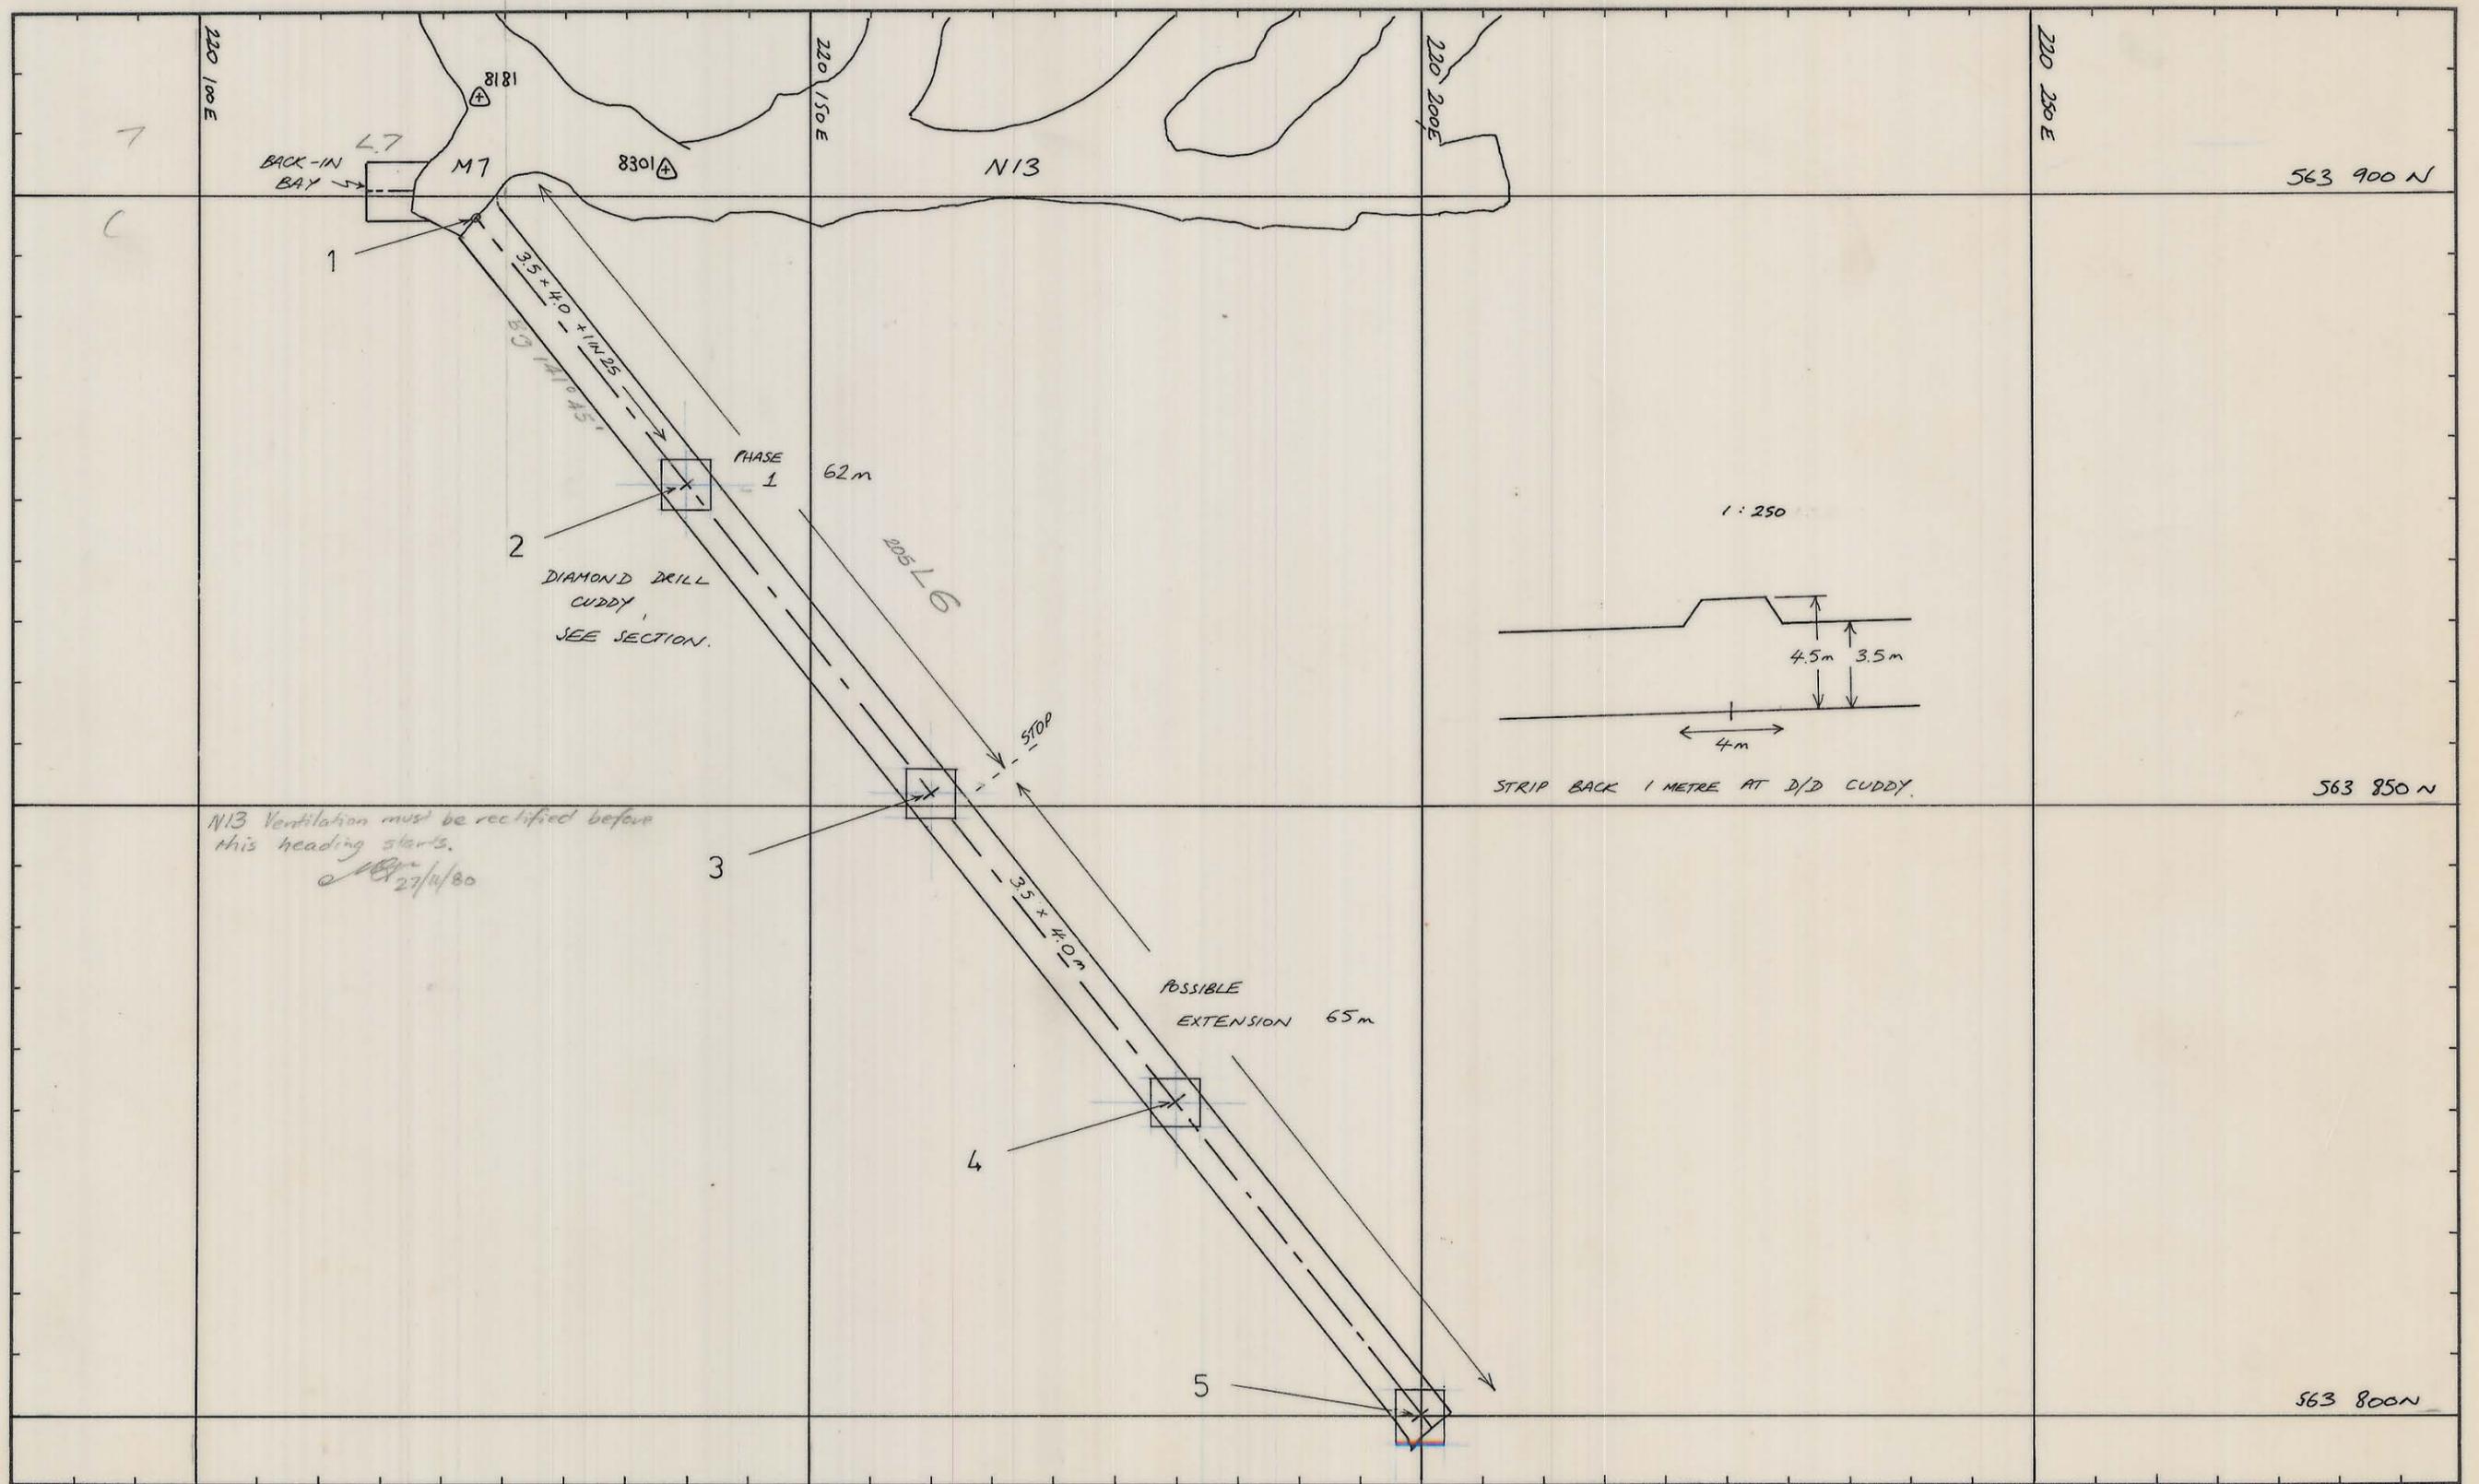


0374_3328

03 DM 16 3003

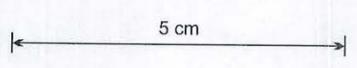

POINT	N	E	R.L.
1	563 898.3	220 122.5	205.9 F
2	563 876.3	220 139.8	204.8 F
3	563 851.0	220 159.8	203.5 F
4	563 825.7	220 179.9	202.2 F
5	563 800.0	220 200.0	200.9 F

REF PLAN 04 DM 14 - 1007

GEOLOGY	R.E.S.D.	26-11-80
SURVEY	ASL	27/11/80
PLANNING	MR	26. NOV. 80
ROCK MEC.	2/11/80	28. 11. 80
GRADE-CON.	DOLPHIN SUPT.	
G.M.S. BRACKETING	29/1/81	
T.S.S.	26/11/80	

SCALE 1: 500

KIS KING ISLAND SCHEELITE GRASSY KING ISLAND

SOUTHERN OREBODY
 DRILL DRIVE M7
 L6

DRAWING NUMBER 03 DM 16 - 3003