


0374_3342

03 DM 12 - 3006

5 cm

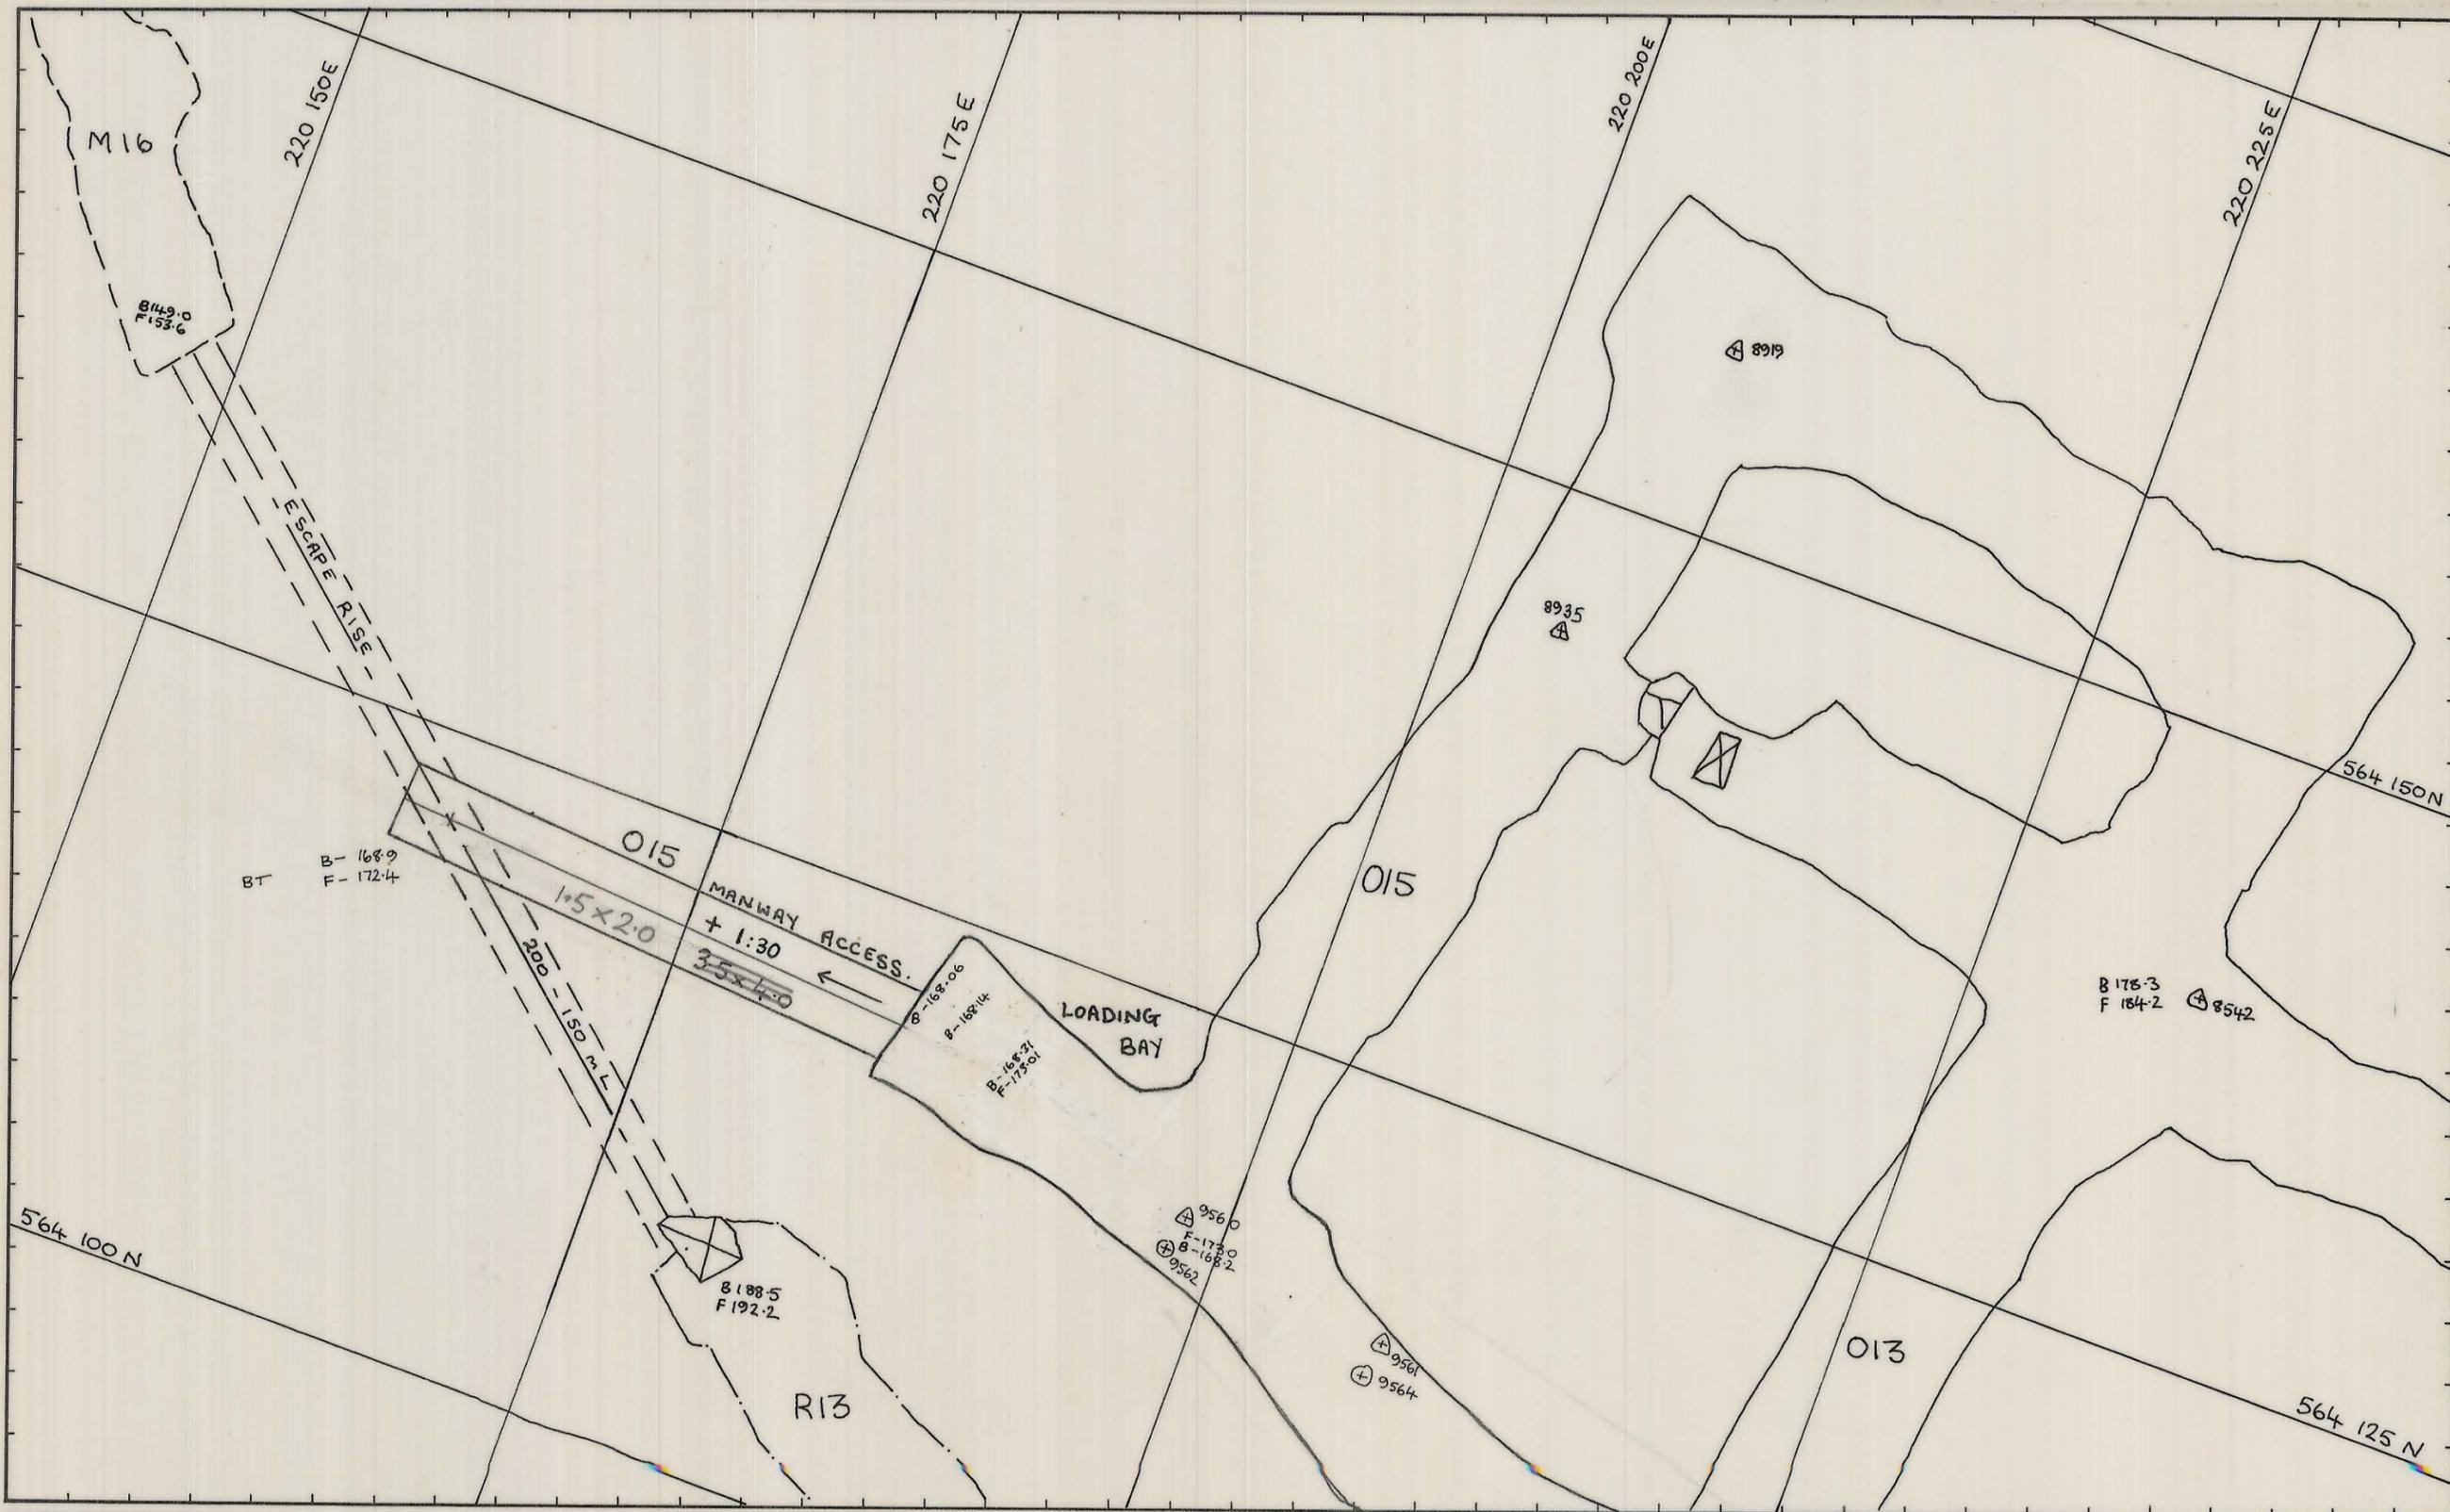

| | | | | |
|-----------------------------------|------------|--------------------|---|--|
| REF PLAN <i>Modd. 30/10/84</i> | GEOLOGY | | SCALE 1:250 | |
| | SURVEY | | | |
| | PLANNING | <i>ADJ</i> 30-8-84 | ESCAPEWAY ACCESS FROM 015 TO R13/M16 MANWAY. | |
| | ROCK MEC. | <i>dl</i> 4.9.84 | | |
| | GRADE CON. | | | |
| DRAFTING | | DRAWING NUMBER | | |
| T.S.S. | | 03 DM 12 - 3006 | | |